


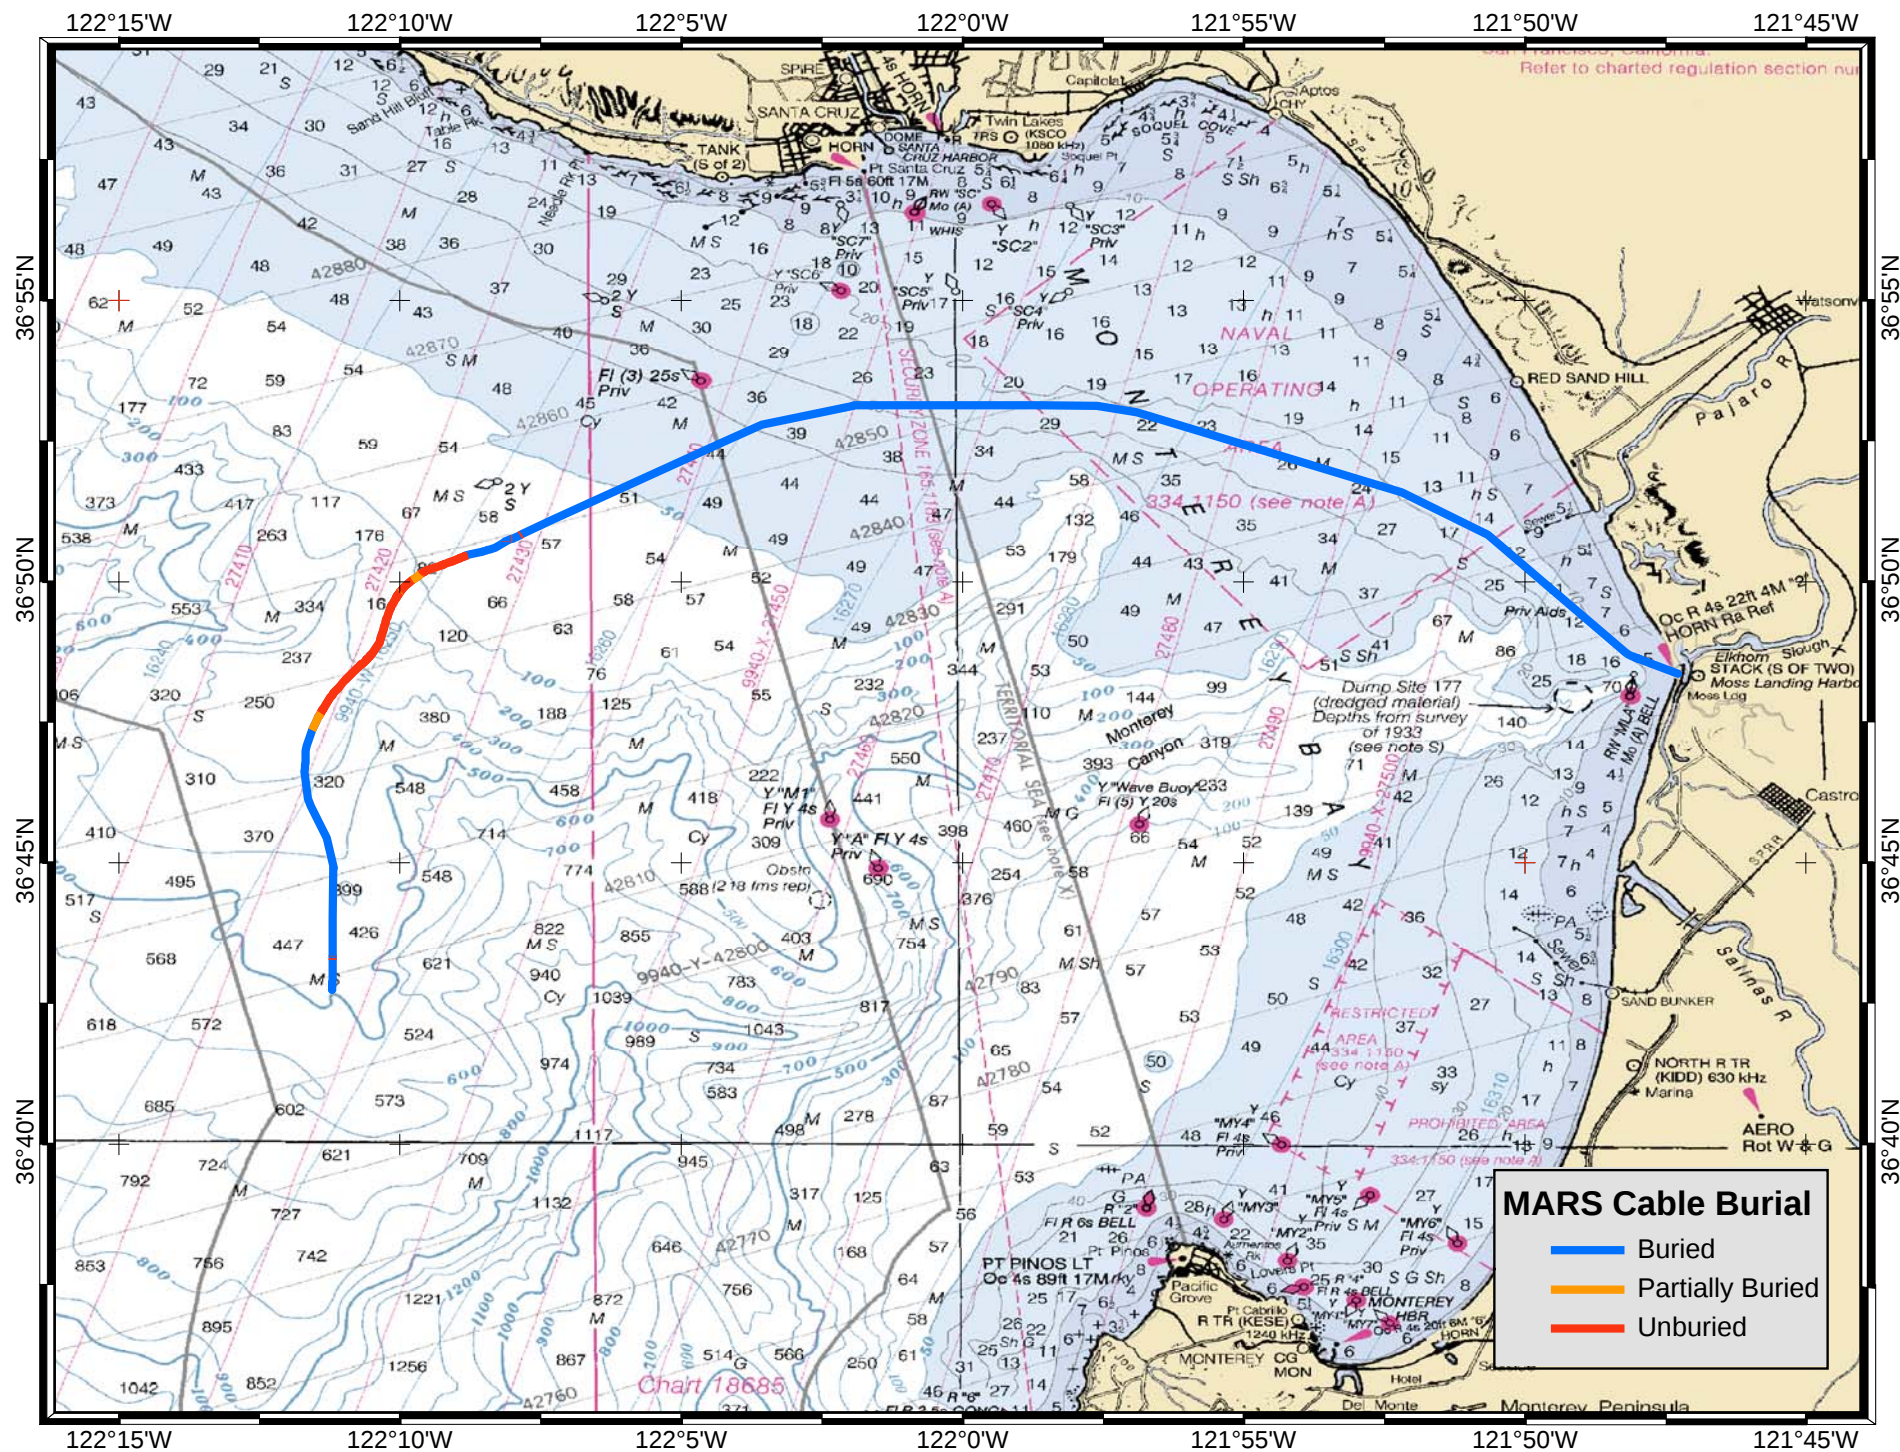

Portion of NOAA chart 18680 with the MARS cable route indicated by the colored line from Moss Landing, CA out into Monterey Bay. Blue portions are buried, orange portions are partially buried, and red portions are unburied sections of cable. Electronic versions of the chart (PDF format) or full-sized hard copies are available upon request (see letter).