

0 4 8 16 32
SCALE: 1/16"=1'-0"

0 2 4 6 16
SCALE: 1/8"=1'-0"

0 1 2 4 8
SCALE: 1/4"=1'-0"

0 1' 2' 3' 5'
SCALE: 1/2"=1'-0"

0 1' 2' 3' 4'
SCALE: 3/4"=1'-0"

0 1' 2' 3' 4'
SCALE: 1"=1'-0"

0 1' 2' 3' 4'
SCALE: 1-1/2"=1'-0"

0 1' 2' 3' 4'
SCALE: 3"=1'-0"


IF THIS SHEET IS NOT 24" X 36", IT IS A
REDUCED PRINT. SCALE ACCORDINGLY

GENERAL NOTES:

1. POWER AND DATA TRENCH: 12"x30" SEPARATE CONDUITS
2. BUILDING WILL ANCHORED TO 10"x16" CONC. PAD
3. PAD AREA WILL BE LEVELED. NOT MORE THAN 4"-6"
4. NO OTHER GRADING OR FILL REQUIRED
5. FINISH FLOOR OF STATION WILL BE 11" ABOVE CONC. SLAB, WHICH IS 2" ABOVE FINISH GRADE
6. ELECTRICAL TRANSFORMER TO BE SET ON 3'x4' PAD (ESTIMATED SIZE)

LEGEND:

- | | |
|--|--|
| ① MARS SHORE STATION | ⑦ CABLE BORING |
| ② ENTRY HOLE VAULT 8'x8' | ⑧ CABLE TRENCH: VAULT TO STATION |
| ③ ELECTRICAL TRANSFORMER | ⑨ COMMUNICATION PULL BOX |
| ④ (E) POWER POLE W/ POLE MOUNTED BREAKER PANEL | ⑩ 2" CONDUIT UNDERGROUND COMMUNICATION |
| ⑤ (E) POWER POLE | ⑪ NEW PULL BOX POINT OF CONNECTION TO (E) COMMUNICATIONS |
| ⑥ POWER & DATA TRENCH | — Existing conduit |

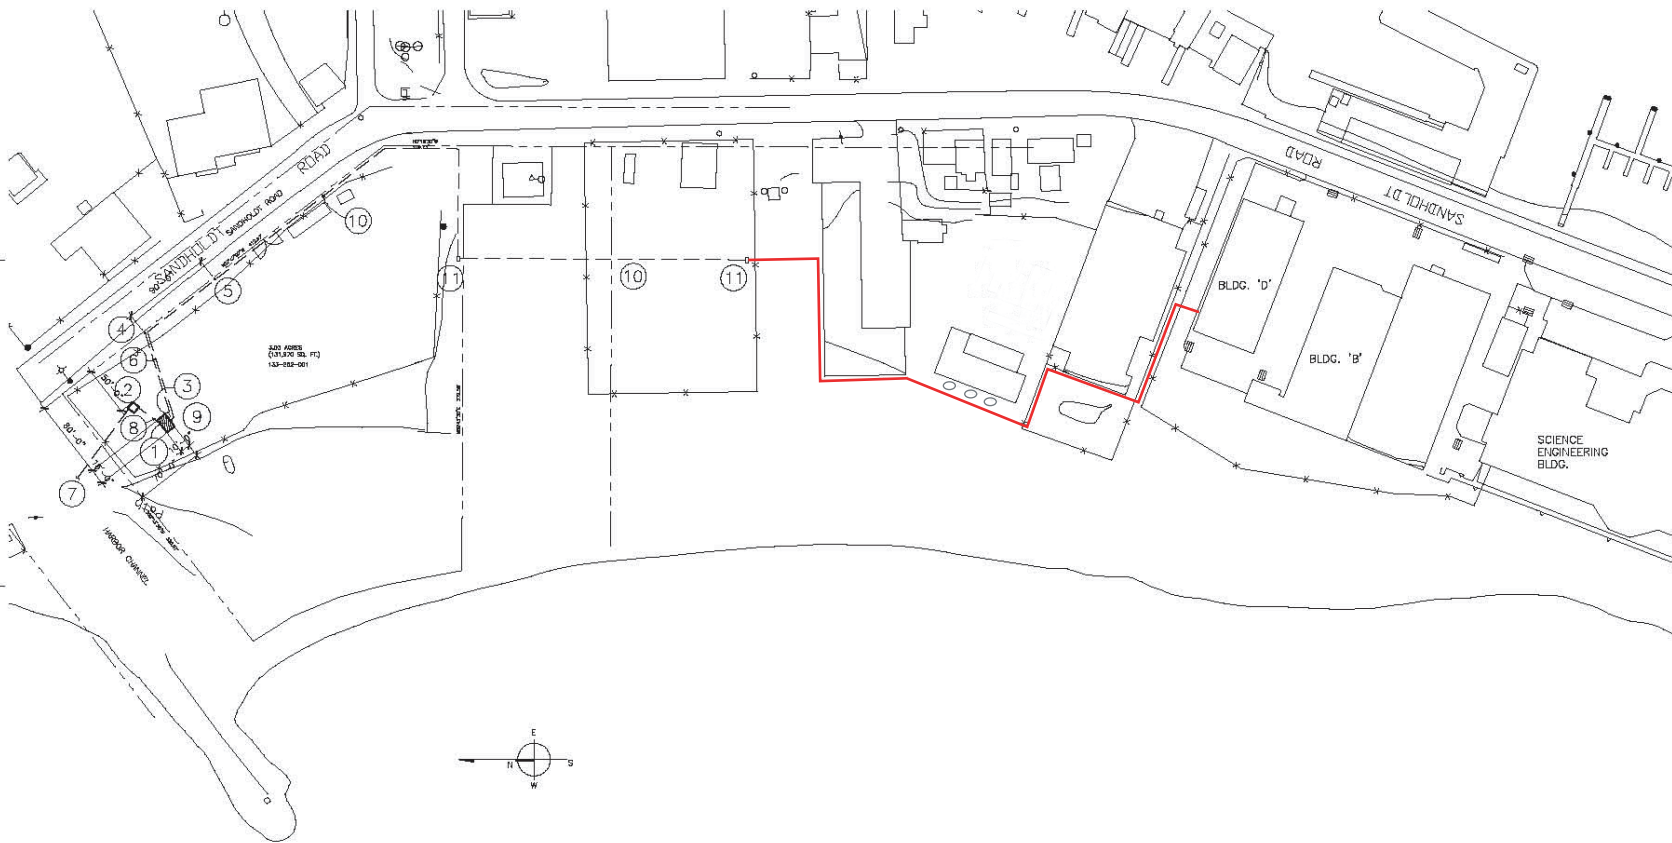

H3FL
Holewinski Blevens Fadelum & Lukas, Architects

380 Main Street
Salinas, California 93901
408/ 757-8001



Richard J. Fadelum C12691
Thomas R. Lukas CB982

Consultants:

Agency Approval:

Revisions		
No.	Description	Date



MOSS LANDING FACILITIES
SANDHOLDT ROAD
MOSS LANDING CA. 95039

MARS SHORE STATION

SITE PLAN

Drawn by:

Checked:

Approved:

Project No. 04010

Drawing No.

Date 8/11/05

A1.2

36 SITE PLAN

80' = 1" = 0"

THE USE OF THESE PLANS AND SPECIFICATIONS SHALL BE RESTRICTED TO THE ORIGINAL SITE FOR WHICH THEY WERE PREPARED AND PUBLICATION THEREOF IS EXPRESSLY LIMITED TO SUCH USE. RE-USE, REPRODUCTION, OR PUBLICATION BY ANY METHOD, IN WHOLE OR IN PART, IS PROHIBITED. TITLE TO THE PLANS AND SPECIFICATIONS REMAINS IN THE ARCHITECT WITHOUT NECESSARY VISUAL CONTACT WITH THESE PLANS AND SPECIFICATIONS SHALL CONSTITUTE PRIMA FACIE EVIDENCE OF THE ACCEPTANCE OF THESE INSTRUCTIONS.