


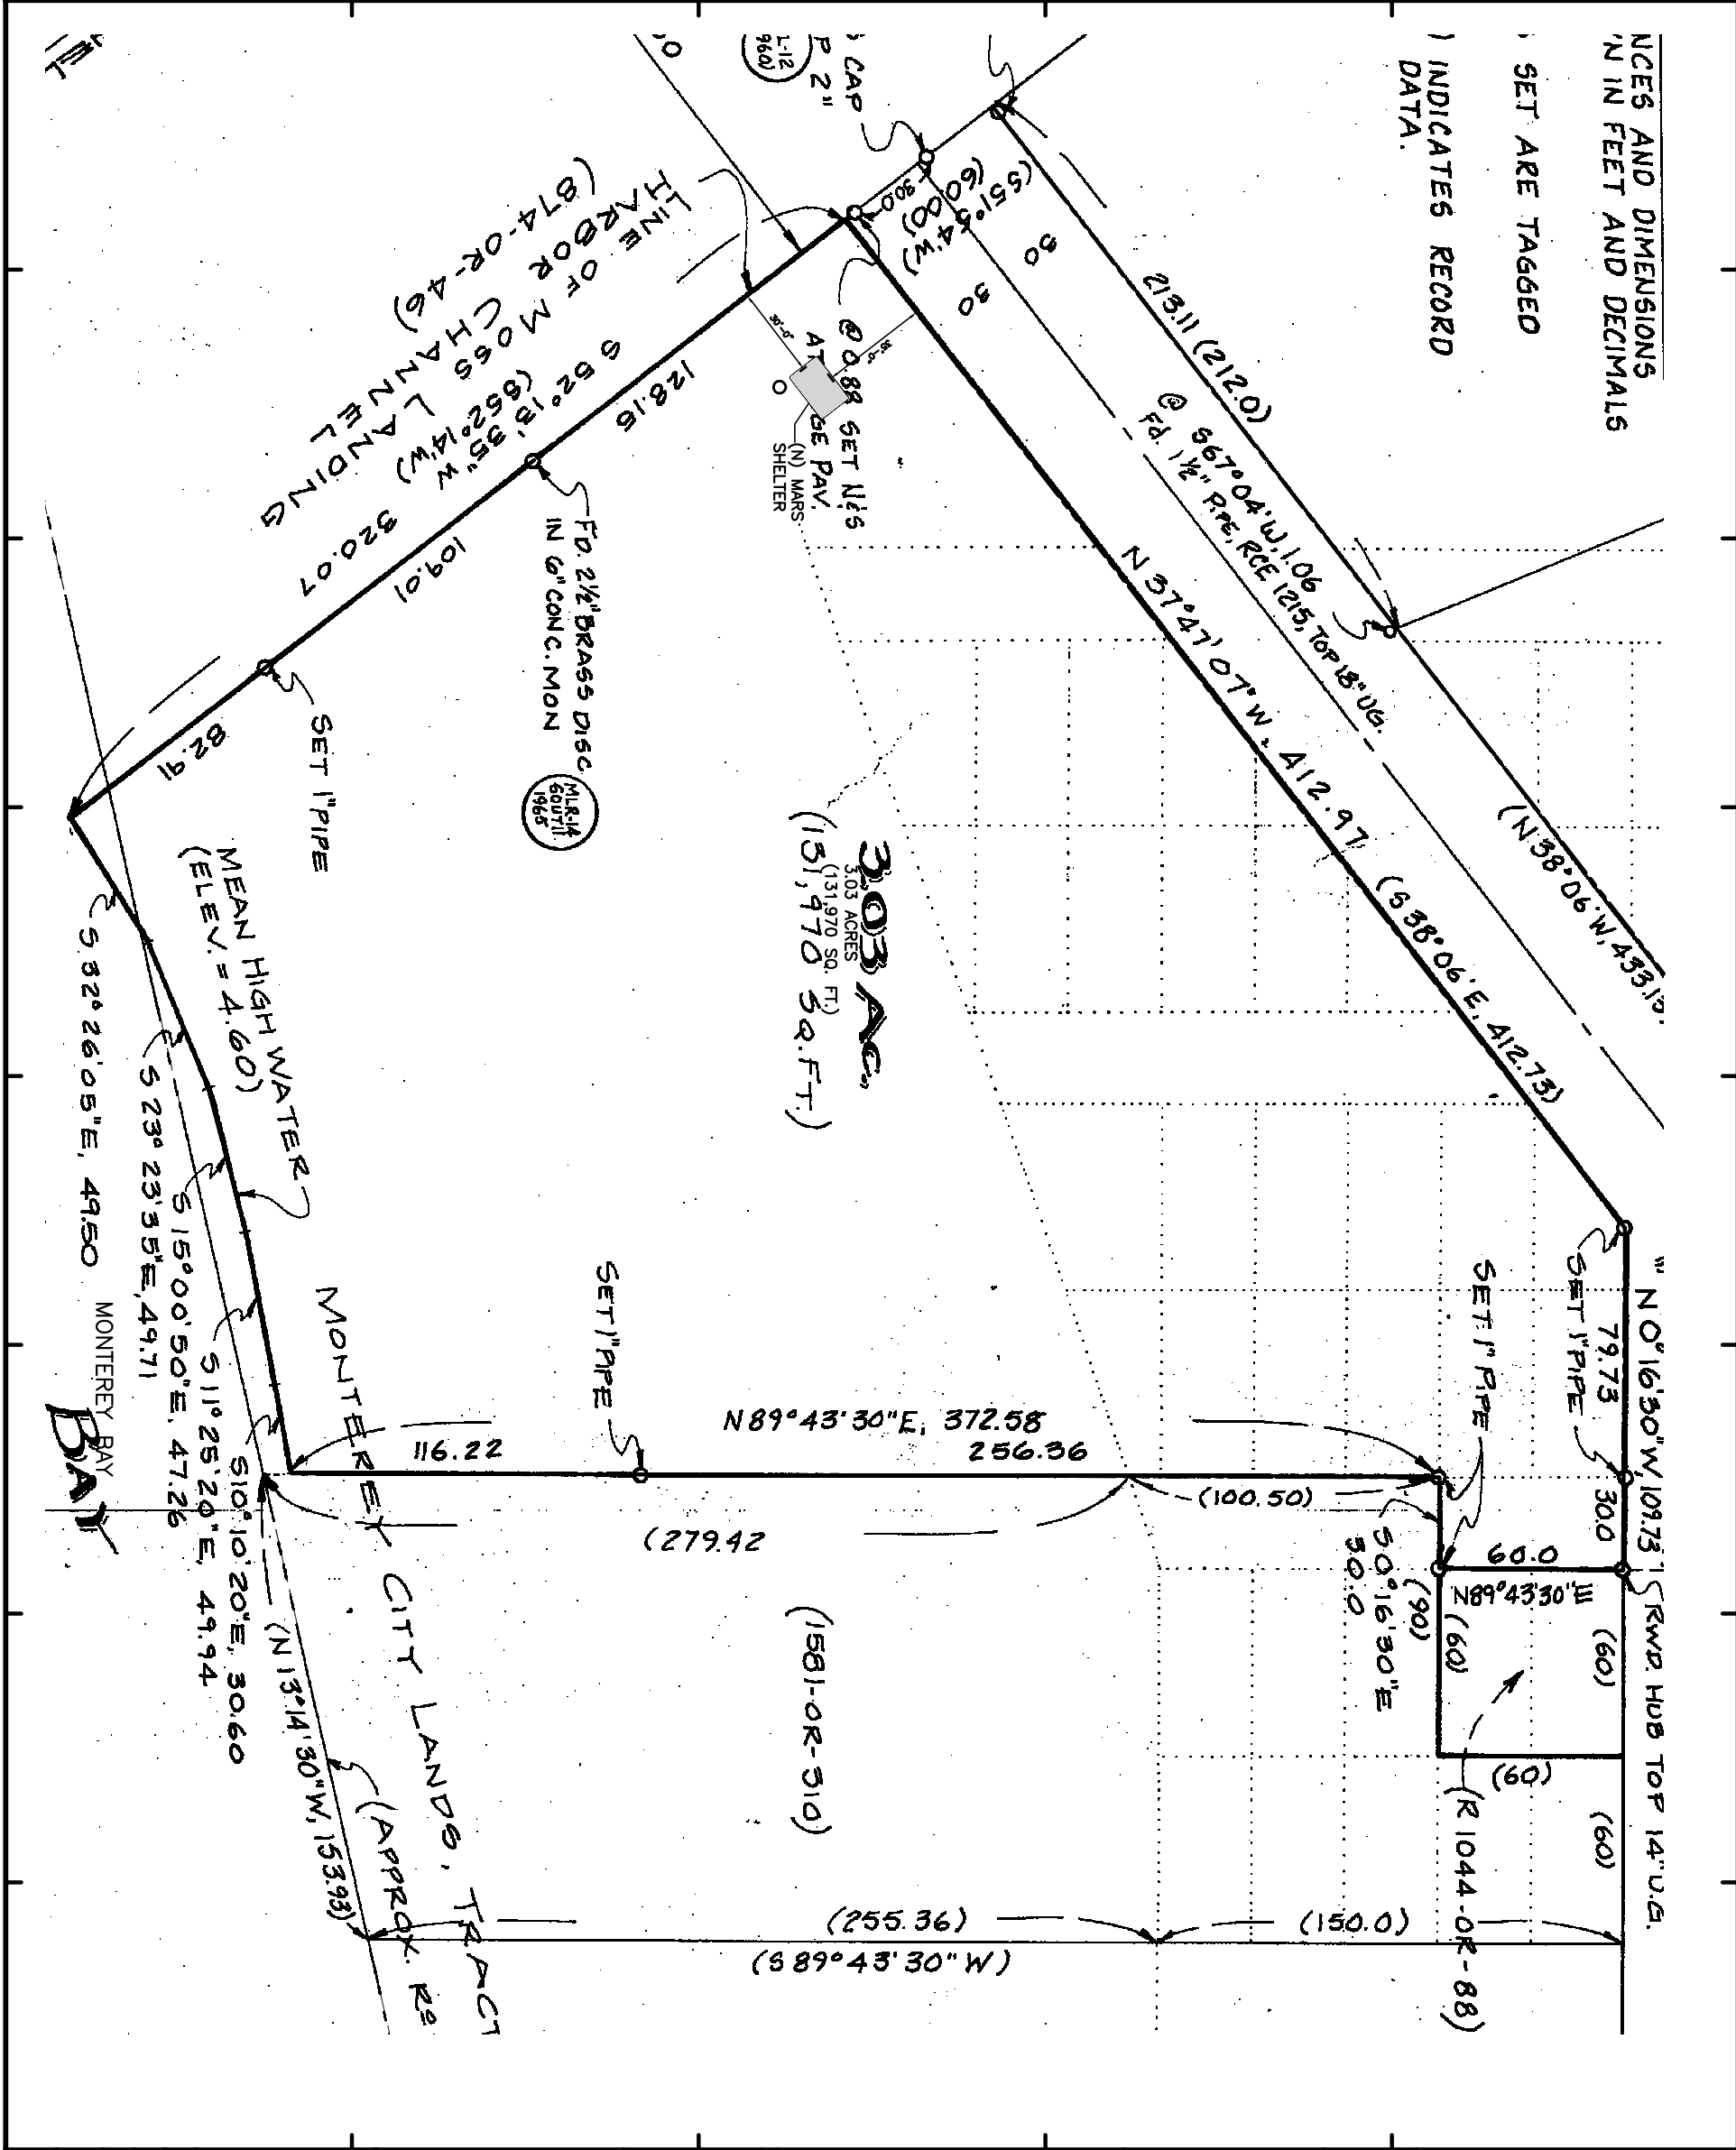

THIS SHEET IS NOT TO BE USED FOR ANY OTHER PURPOSE THAN THAT FOR WHICH IT WAS DESIGNED. ANY OTHER USE IS AT THE USER'S RISK.

NOTES AND DIMENSIONS
IN FEET AND DECIMALS

SETS ARE TAGGED
INDICATES RECORD
DATA.





