


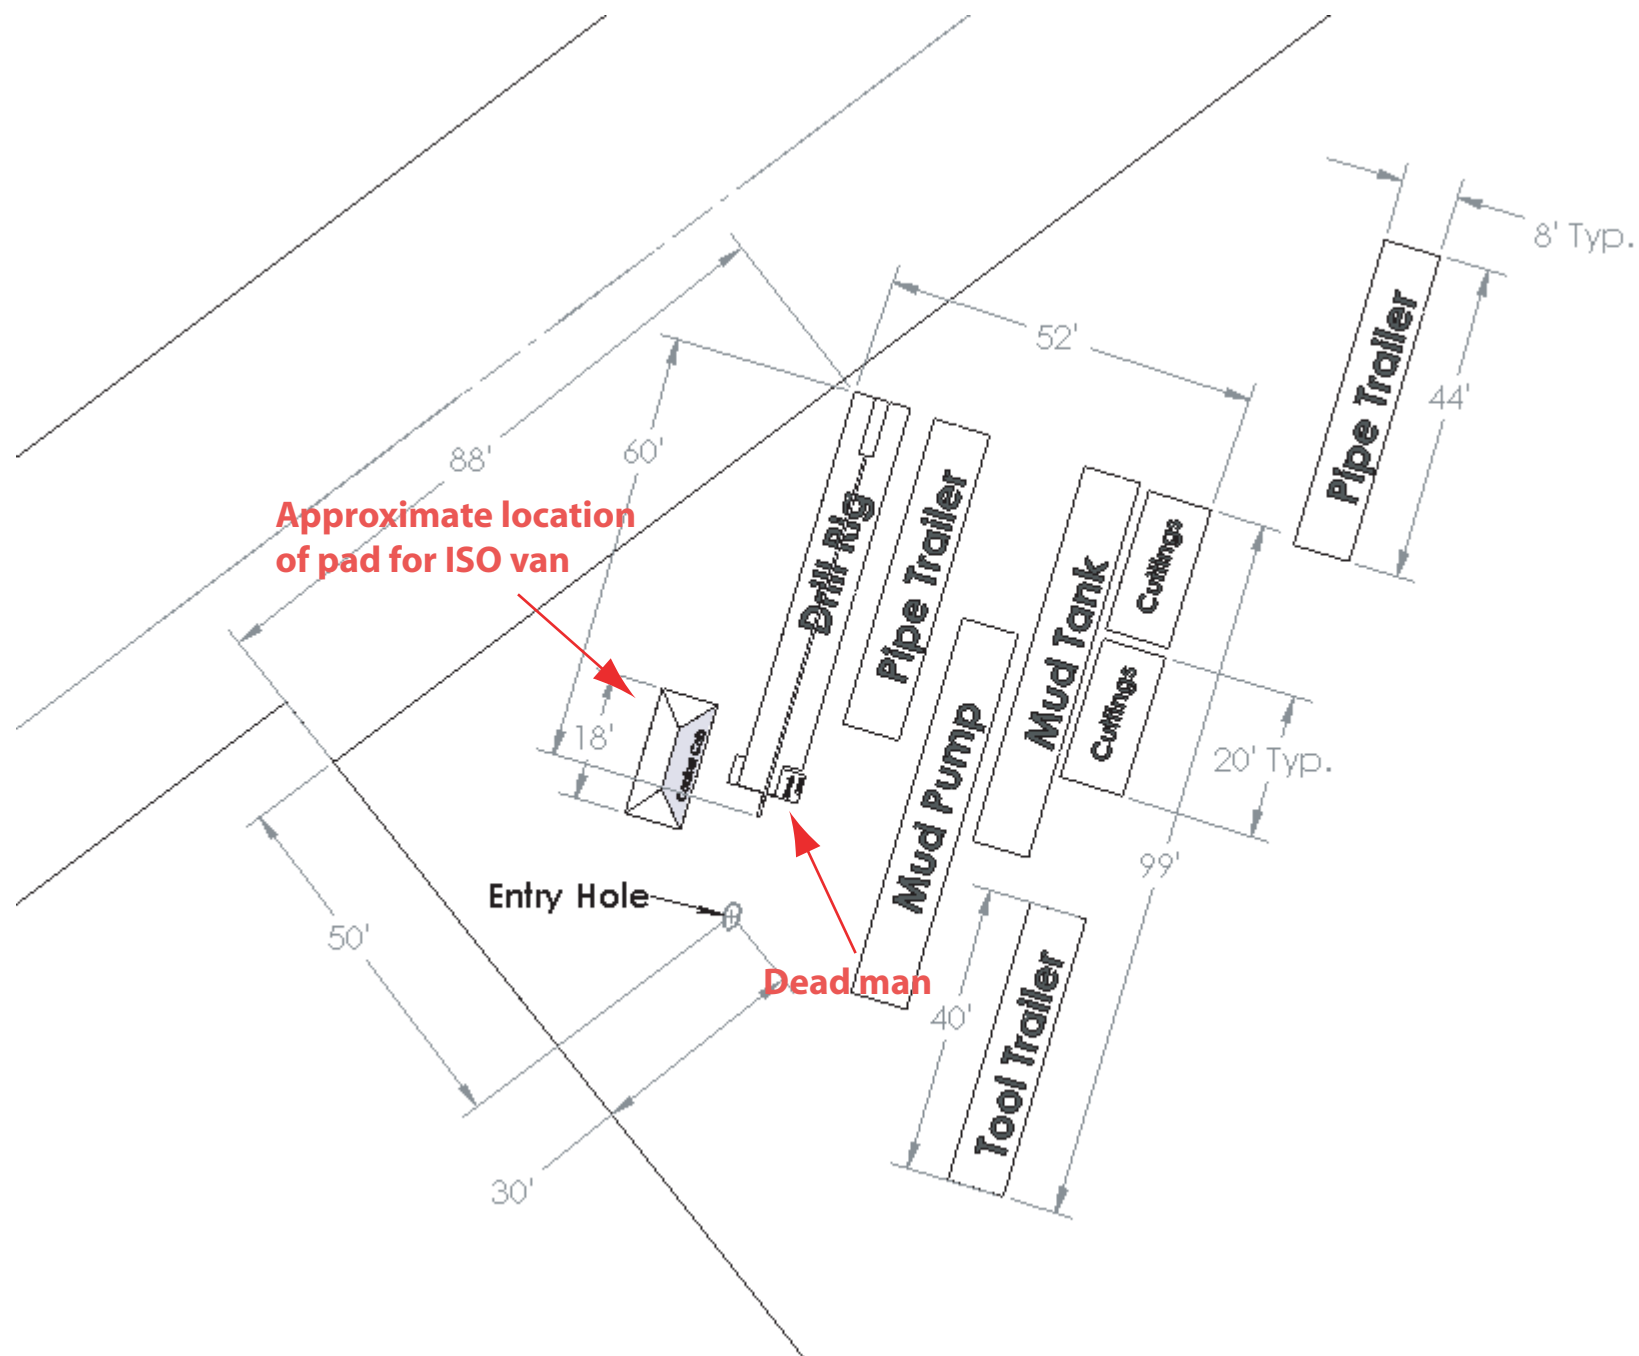

[G