


MARS HDD SURVEY

Datum: WGS1984
Grid: UTM Zone 10N
Survey Date: October 22, 2004

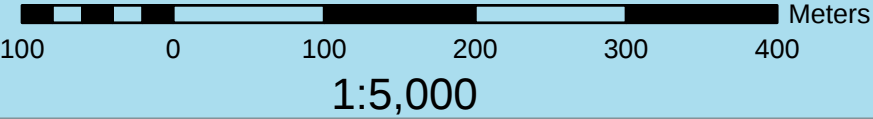

Legend

- XY1000
- XYHarbor
- XY6000
- XY5000
- XY4000
- XY2000

4,075,000

4,074,000

607,000

608,000

