


3

PANELBOARD / EQUIPMENT MOUNTING

NO SCALE

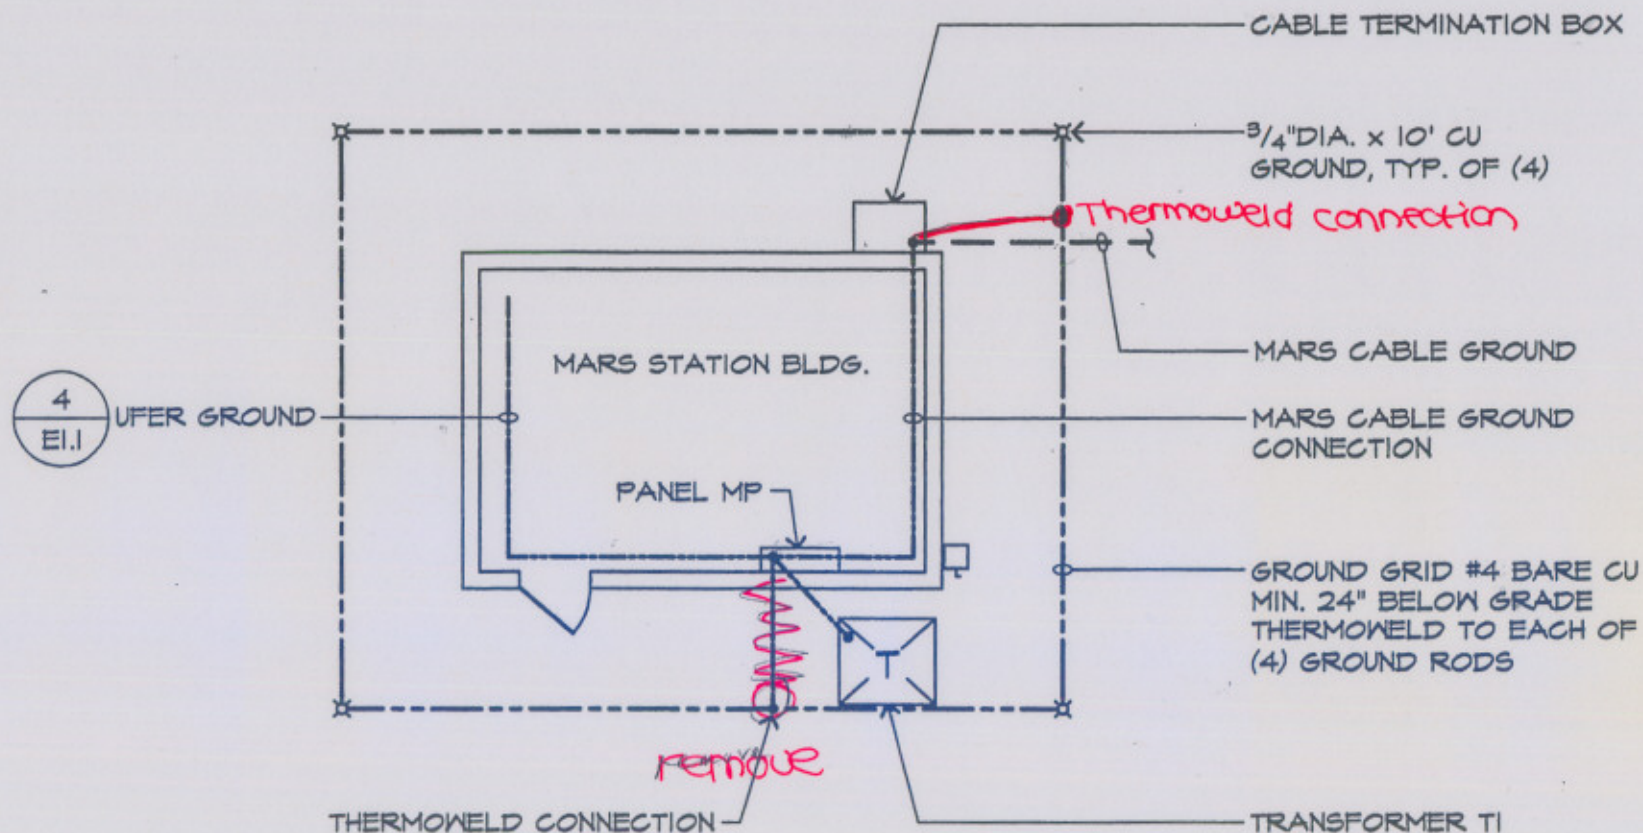

2

BUILDING GROUNDING

NO SCALE