


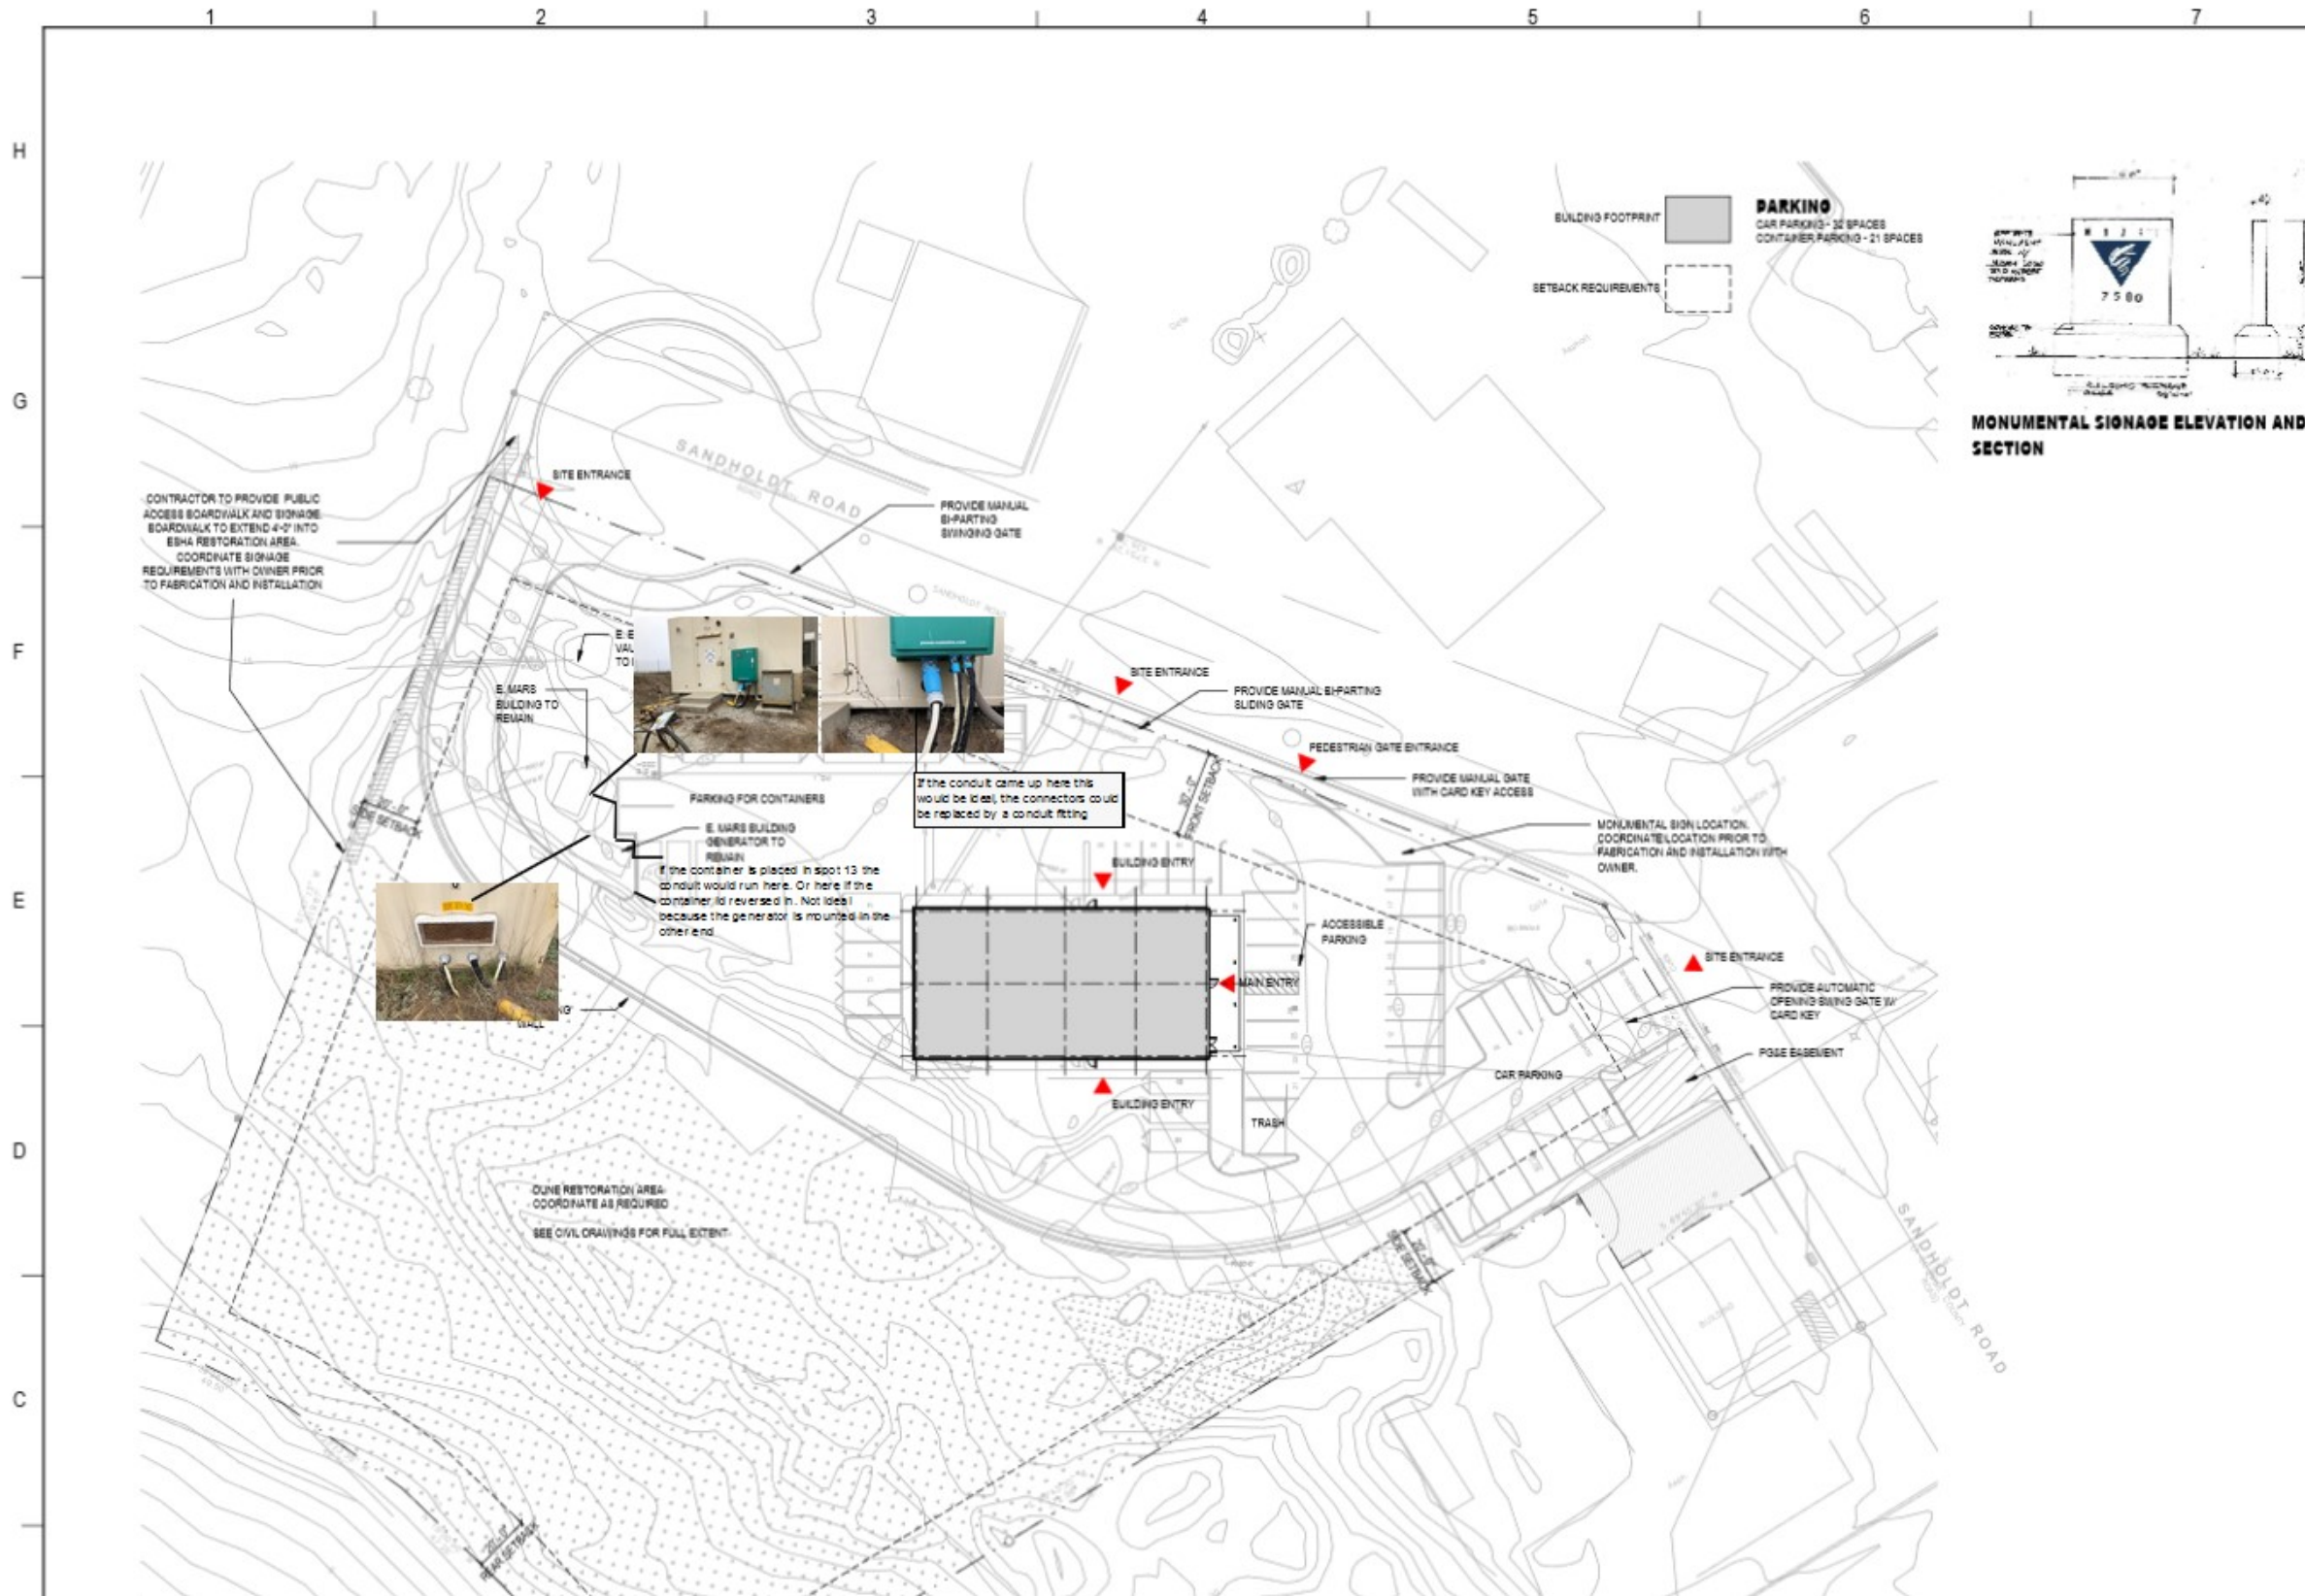

GENERAL ARCHITECTURAL NOTES

- CONTRACTOR TO TAKE SPECIAL CARE WITH CONSTRUCTION IN ENVIRONMENTALLY SENSITIVE AREAS OF THE SITE.
- PROVIDE CARD READER AT GATES AS DESIGNATED ON PLANS.
- COORDINATE CARD READER LOCATIONS AT EXTERIOR DOORS WITH OWNER.
- CONTRACTOR TO COORDINATE ALL CONSTRUCTION WITH E. MARS BUILDING INFRASTRUCTURE AND E. CABLE VAULT.
- PROVIDE MBARI MONUMENT SIGN AS SHOWN. COORDINATE EXACT LOCATION WITH OWNER PRIOR TO INSTALLATION.
- CONTRACTOR TO COORDINATE ALL CONTAINER SITE UTILITIES WITH OWNER PRIOR TO INSTALLATION.
- CONTRACTOR TO PROVIDE TRASH ENCLOSURE PER MONTEREY COUNTY REQUIREMENTS. INCLUDE LIGHTING AND POWER AS REQUIRED BY AHJ.

Flad Architects



AXIOM ENGINEERS
CONSULTING ENGINEERS

WESTON ENGINEERS, INC.
CONSULTING ENGINEERS

AURUM CONSULTING ENGINEERS

LANA
CONSULTING ENGINEERS

Stamps & Approvals



Project Key Plan

NOT FOR CONSTRUCTION

Rev Date Description

Project Title



MBARI

7000 Sandholdt Road