



PL-DL
PL15N002FC0-0-0-01
Laser and Monitor

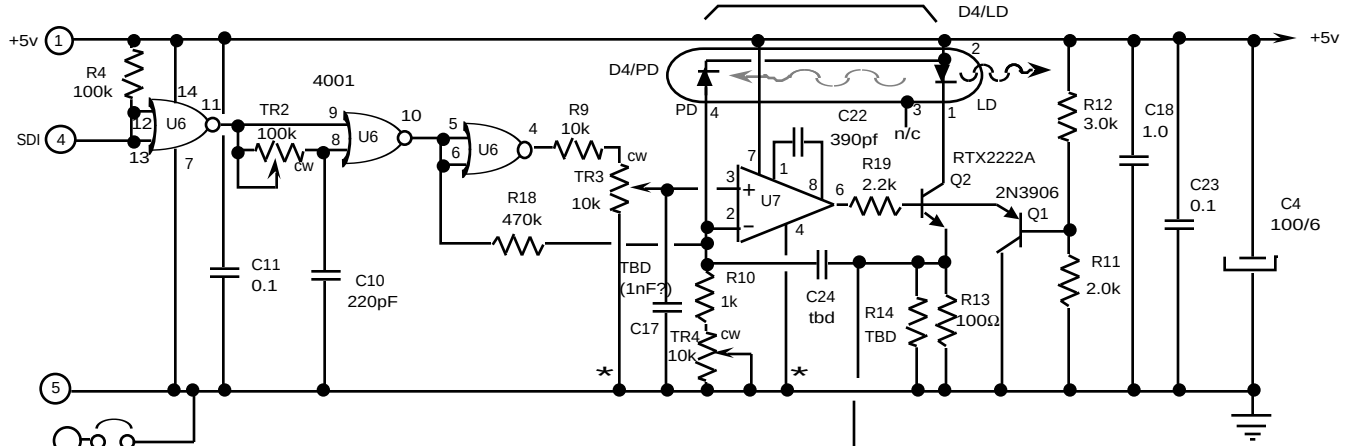


JP1 to mounting
hole pad to case

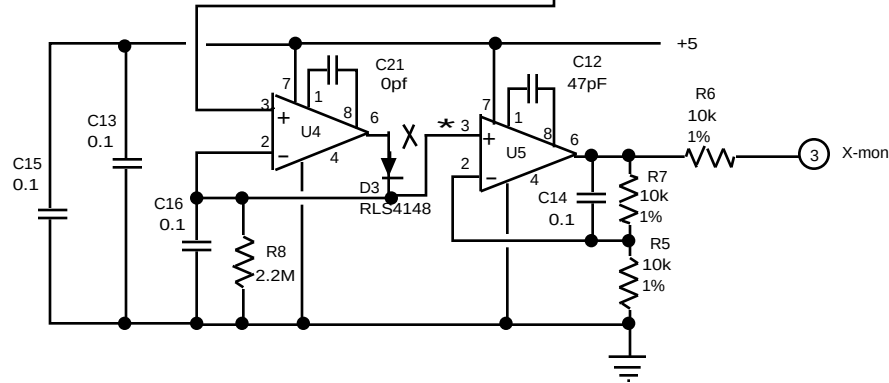

Notes:
1. all op-amps CA3130

PIN diode
PD/LD
55μM
1300 nm
ball lens

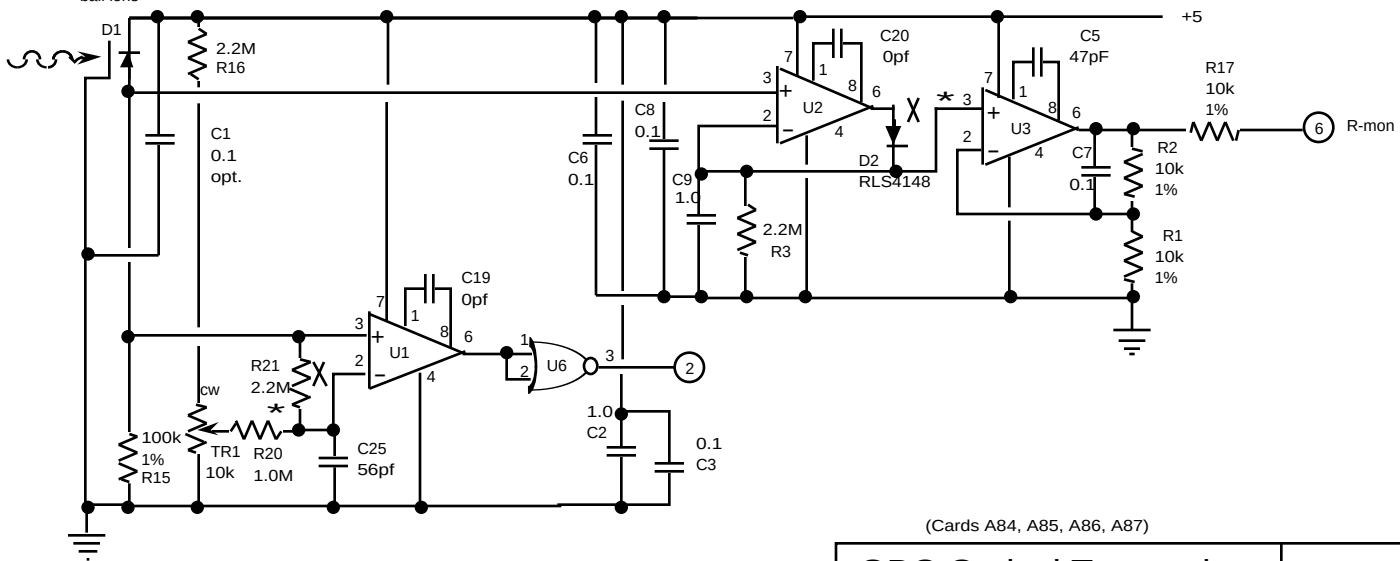

(Cards A84, A85, A86, A87)

★ requires foil mod ON REV 1 BOARDS

OBC Optical Transceiver			proj #
A. Bradley	XI-9-2004	rev I-26-2005	