


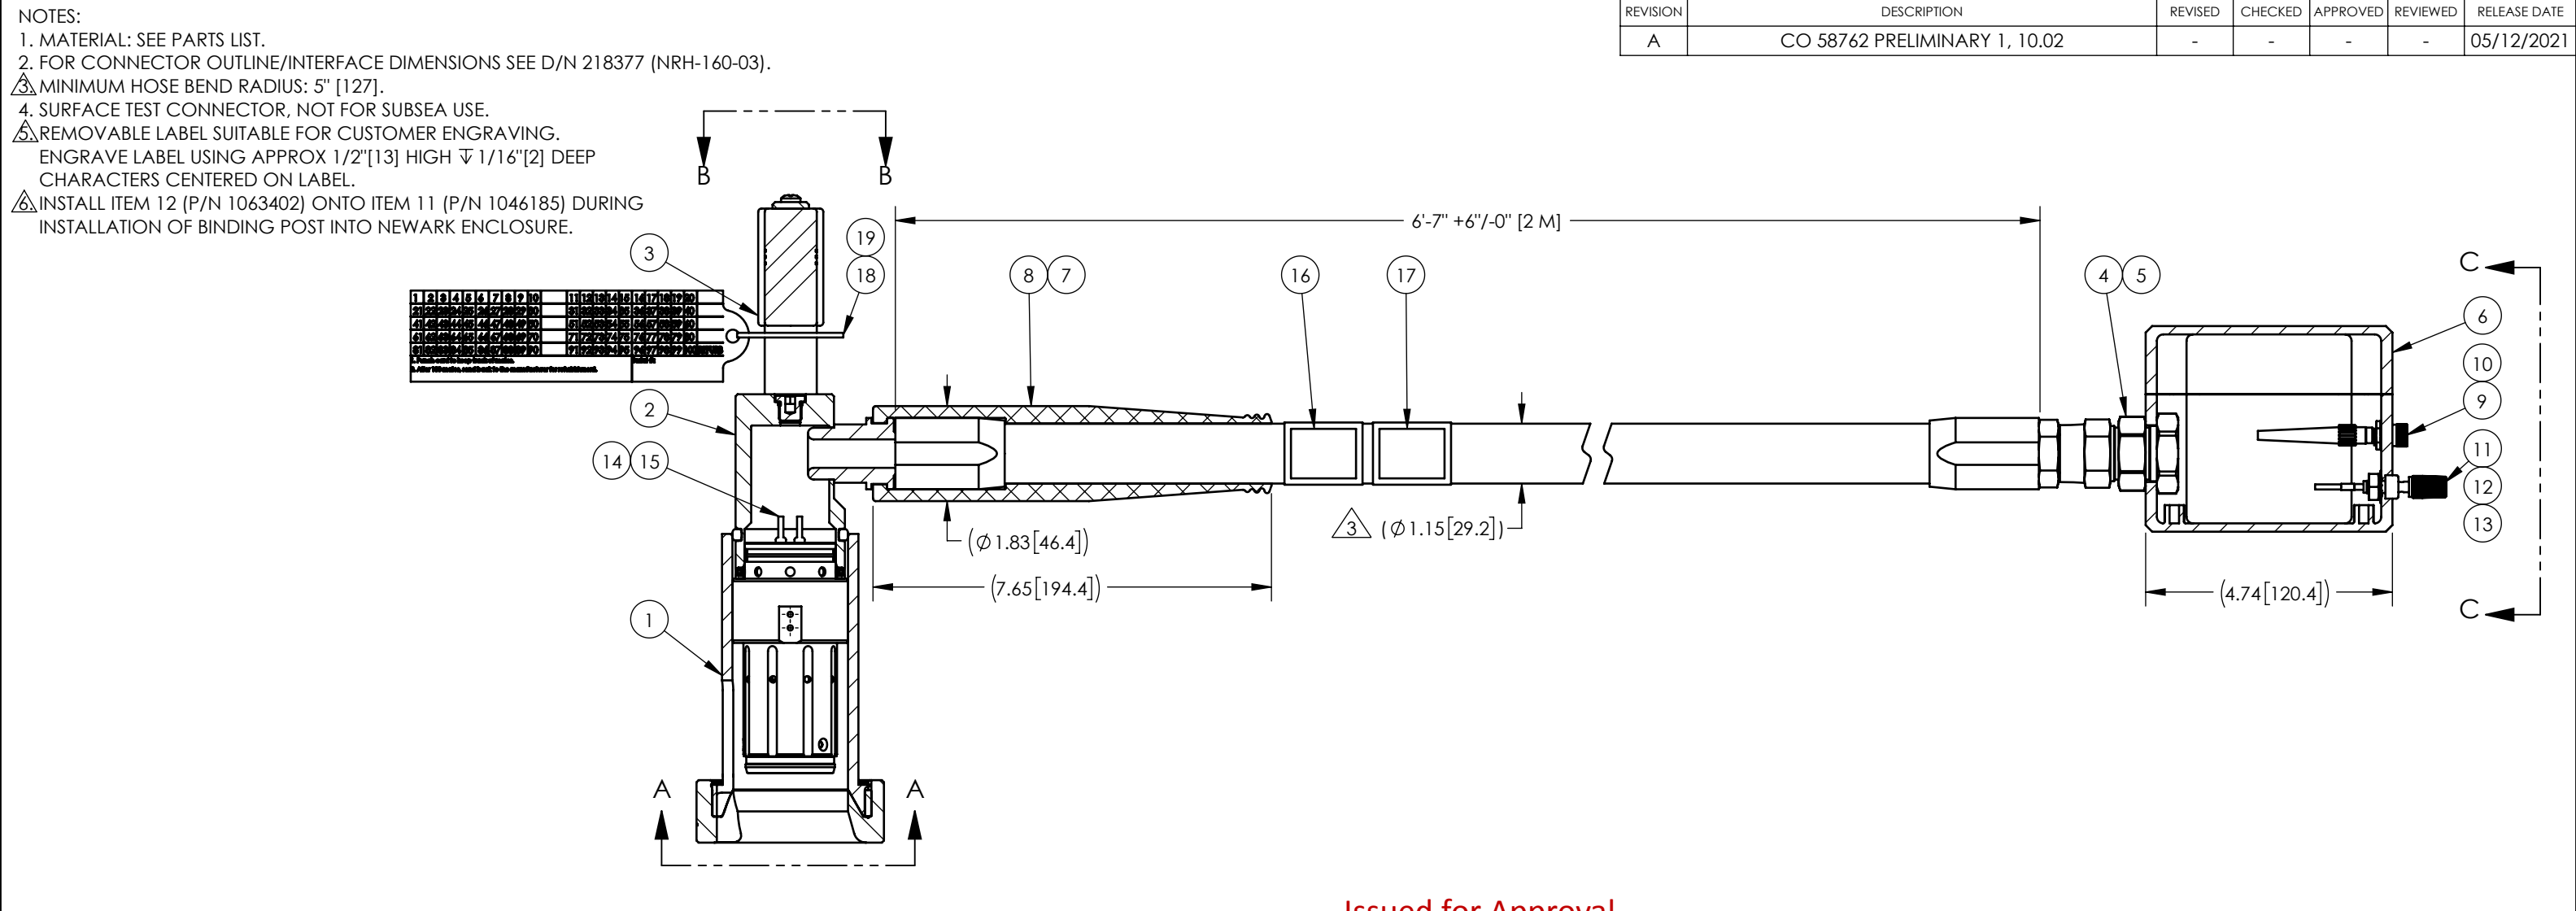

19	1089290	KHB-3820-06	MATING PUNCH CARD	1	
18	1013269	PLT2M-CO	PANDUIT CABLE TIE WRAP, NYLON 6/6	1	
17	1013373	P-TOUCH-1"	LABEL "ODI S/N____"	A/R	
16	1013373	P-TOUCH-1"	LABEL - "SURFACE TEST CONNECTOR, NOT FOR SUBSEA USE"	1	
15	1000717	44A0211-14-9	44A0211-14-9, 14 AWG, 1000V, W	2 X A/R	
14	1012423	ODN-001-04-1	NAUT BOOT SEAL, OD1037	2	
13	1013495	RNF100-CL-H00	HEAT SHRINK TUBING, 1/8" CLR	2 X A/R	
12	1063402	91757A111	5/16" INT TOOTH LOCK WASHER 18-8 SS	2	6
11	1046185	J370-ND	INSULATED BINDING POST	2	6
10	1048050	OD-1080	FC/PC CONNECTOR	4	
9	1014351	SAA-322200G	FC COUPLER/ADAPTER W/CERAMIC SLV	4	
8	1043833	ODN-109-01-28	TISJXN -12 HOSE ASSEMBLY	1	
7	1012416	ODHOSE-12-HBD-2	HOSE, 5/8" I.D., ORANGE	1 X A/R	
6	1062632	FIB-204-04-23	MODIFIED NEWARK ENCLOSURE	1	
5	1000279	12WLN-SS	NUT, BULKHEAD 316 SST	1	
4	1000276	KHB-2415-04	-12 JIC FTG MODIFIED, 316 SST	1	
3	1049660	ROV-496-01-2	ROV PADDLE HANDLE KIT W/IDENT, HYTREL/TI GR 5	1	
2	1049271	FAK-545-01-4-90	TERM SHELL KIT, 90 DEG -12 INT, TI GR 2	1	
1	1061792	NRH-168-01-1	NRH RCPT S/A, OOOOEE, TI GR 2	1	
ITEM	PART NO	REF NO	DESCRIPTION	QTY.	NOTES
PARTS LIST					


Issued for Approval

☒ Approved without comments – proceed with manufacture.

☐ Comments provided, incorporate and resubmit for approval.

T. Craig Dawe 05/13/2021

Signature Date

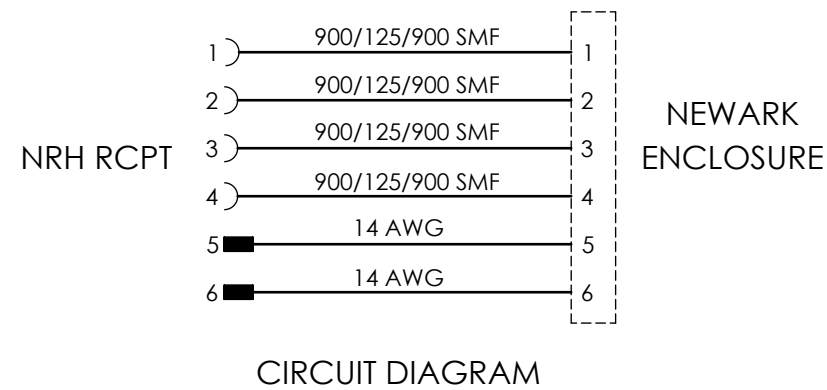

EXPORT CONTROLLED - COMMERCE INFORMATION INCLUDED HEREIN IS CONTROLLED BY THE EXPORT ADMINISTRATION REGULATIONS (EAR) AND REQUIRES AN EXPORT LICENSE, LICENSE EXCEPTION OR OTHER APPROVAL FROM THE APPROPRIATE U.S. GOVERNMENT AGENCY BEFORE BEING EXPORTED FROM THE UNITED STATES OR PROVIDED TO ANY FOREIGN PERSON. DIVERSION CONTRARY TO U.S. LAW IS PROHIBITED.

THE INFORMATION CONTAINED HEREIN IS PROPRIETARY TO TELEDYNE OIL & GAS, A BUSINESS UNIT OF TELEDYNE INSTRUMENTS, INC.

INTERPRET THIS DRAWING IN ACCORDANCE WITH:
ASME Y14.5-2018
DIM AND TOLERANCING
ASME Y14.100-2017
ENG DWG PRACTICES

UNLESS OTHERWISE SPECIFIED:
• DIMENSIONS ARE IN INCHES
• DIMS IN [] ARE IN MILLIMETERS
AND ARE FOR REF ONLY
• BREAK SHARP EDGES R.005
• INTERNAL CORNERS R.02 MAX
• MACHINED FEATURES 63 Ra
• TOLERANCES:
FRACTIONS ±1/64"
X.XX ±.01
X.XXX ±.003
ANGLES ±0.5°

DRAWN MYF
CHECKED DATE
APPRVD DATE

DO NOT SCALE FROM DRAWING
DIMENSIONS IN () ARE FOR REFERENCE ONLY
THIRD ANGLE PROJECTION

DATE 05/04/2021

DWG TITLE
40/2E NRH ROV CE RCPT/TEST BOX
GA DRAWING W/ PARTS LIST

SIZE B
DAI 0VV88
SCALE 1:3

DOC NO
2181989
PART NO 1127822
REF NO OPM-413-01


REV A
SHEET 1 OF 2

87654321


TUESDAY, MAY 11, 2021 11:16:13 AM

SW



SEE SHEET 1 FOR NOTES.

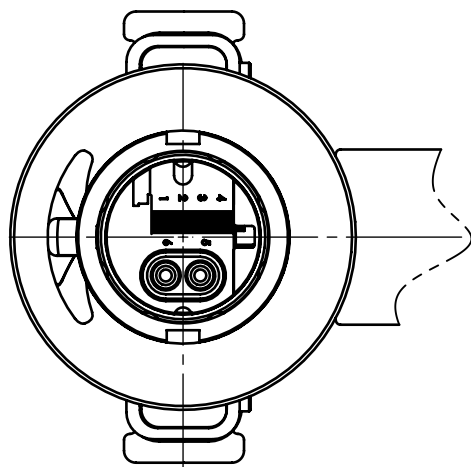

VIEW A-A
SCALE 1:2
KEYING 12 O'CLOCK

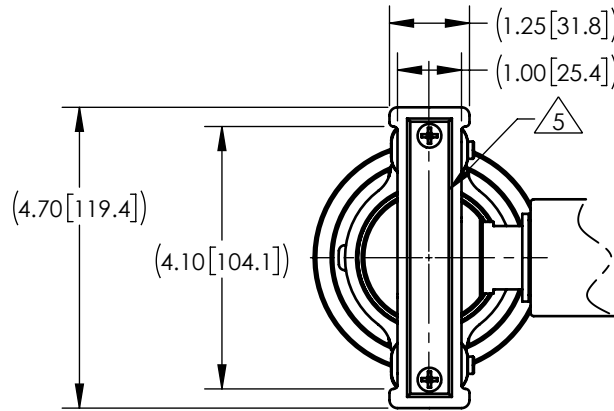

VIEW B-B

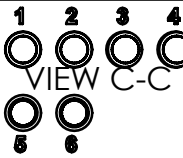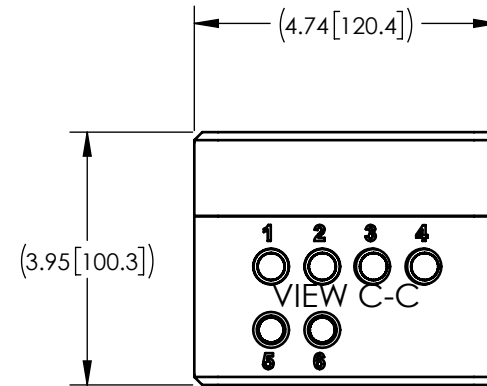

COMMERCE EAR-CONTROLLED TECHNOLOGY SUBJECT TO RESTRICTIONS
CONTAINED ON SHEET 1.



DWG TITLE
40/2E NRH ROV CE RCPT/TEST BOX
GA DRAWING W/ PARTS LIST

SIZE	DAI	DOC NO	REV
B	0VV88	2181989	A
SCALE	PART NO	SHEET	
1:3	REF NO OPM-413-01	2 OF 2	