



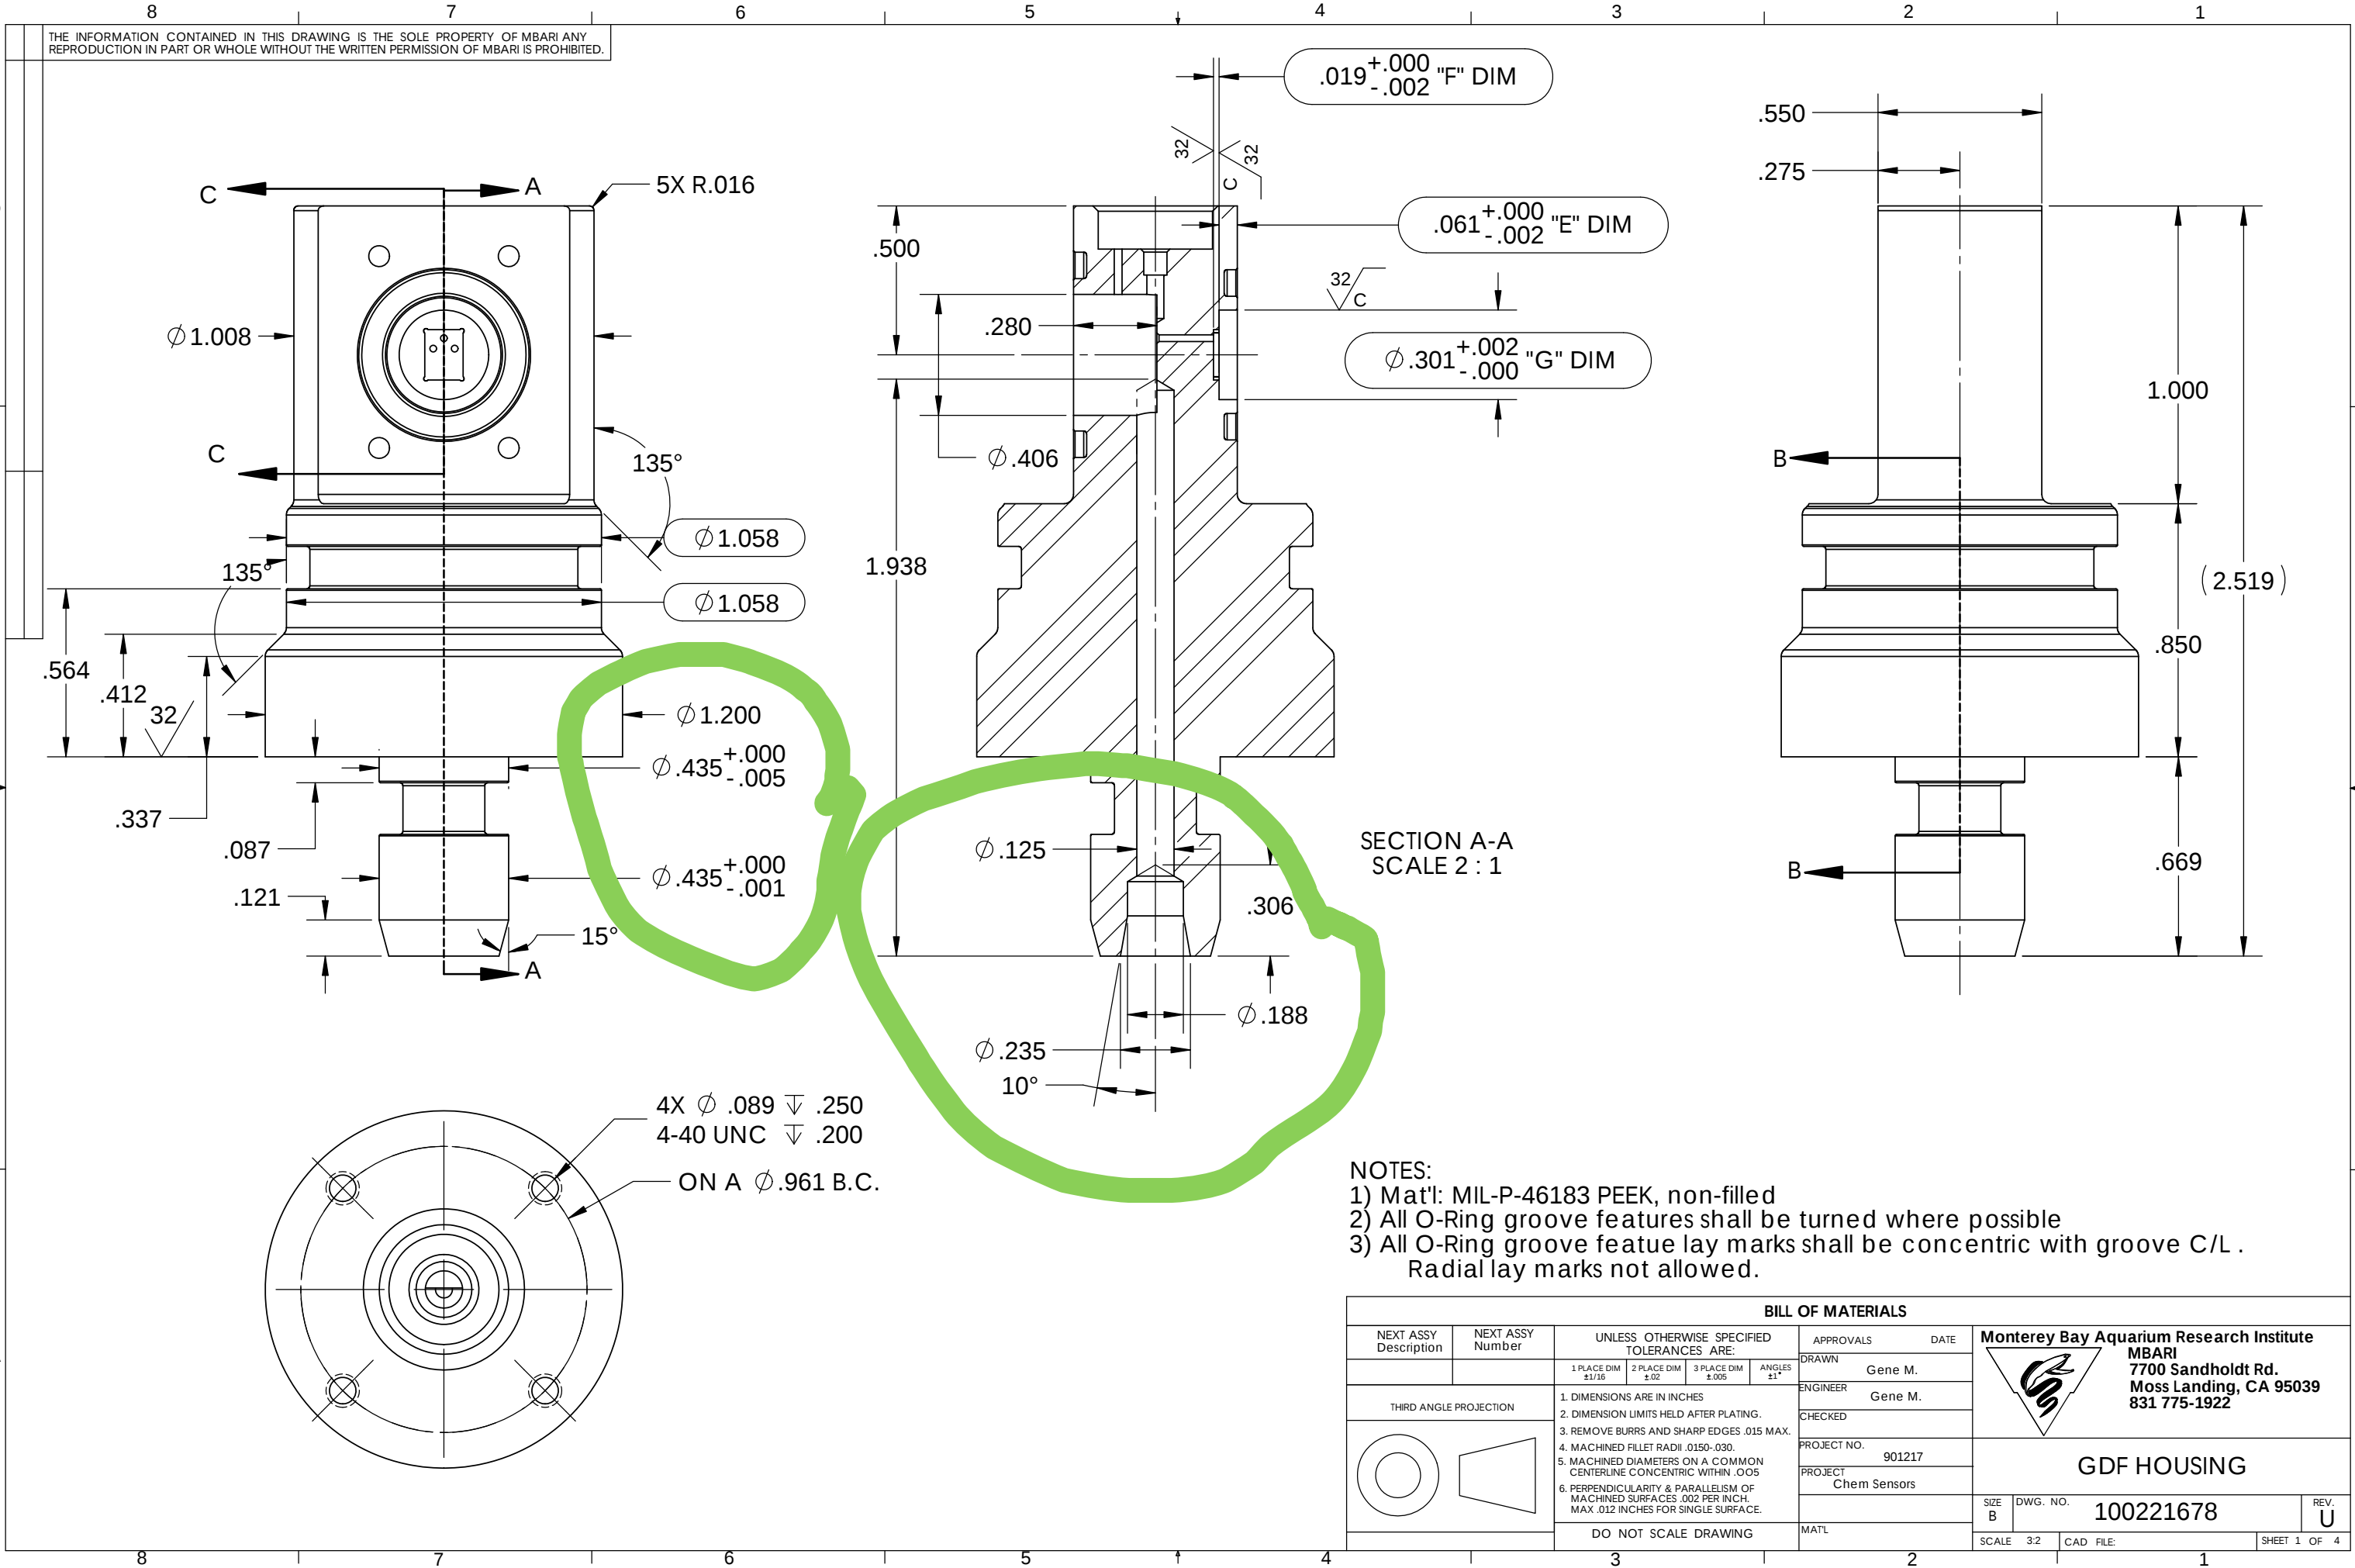


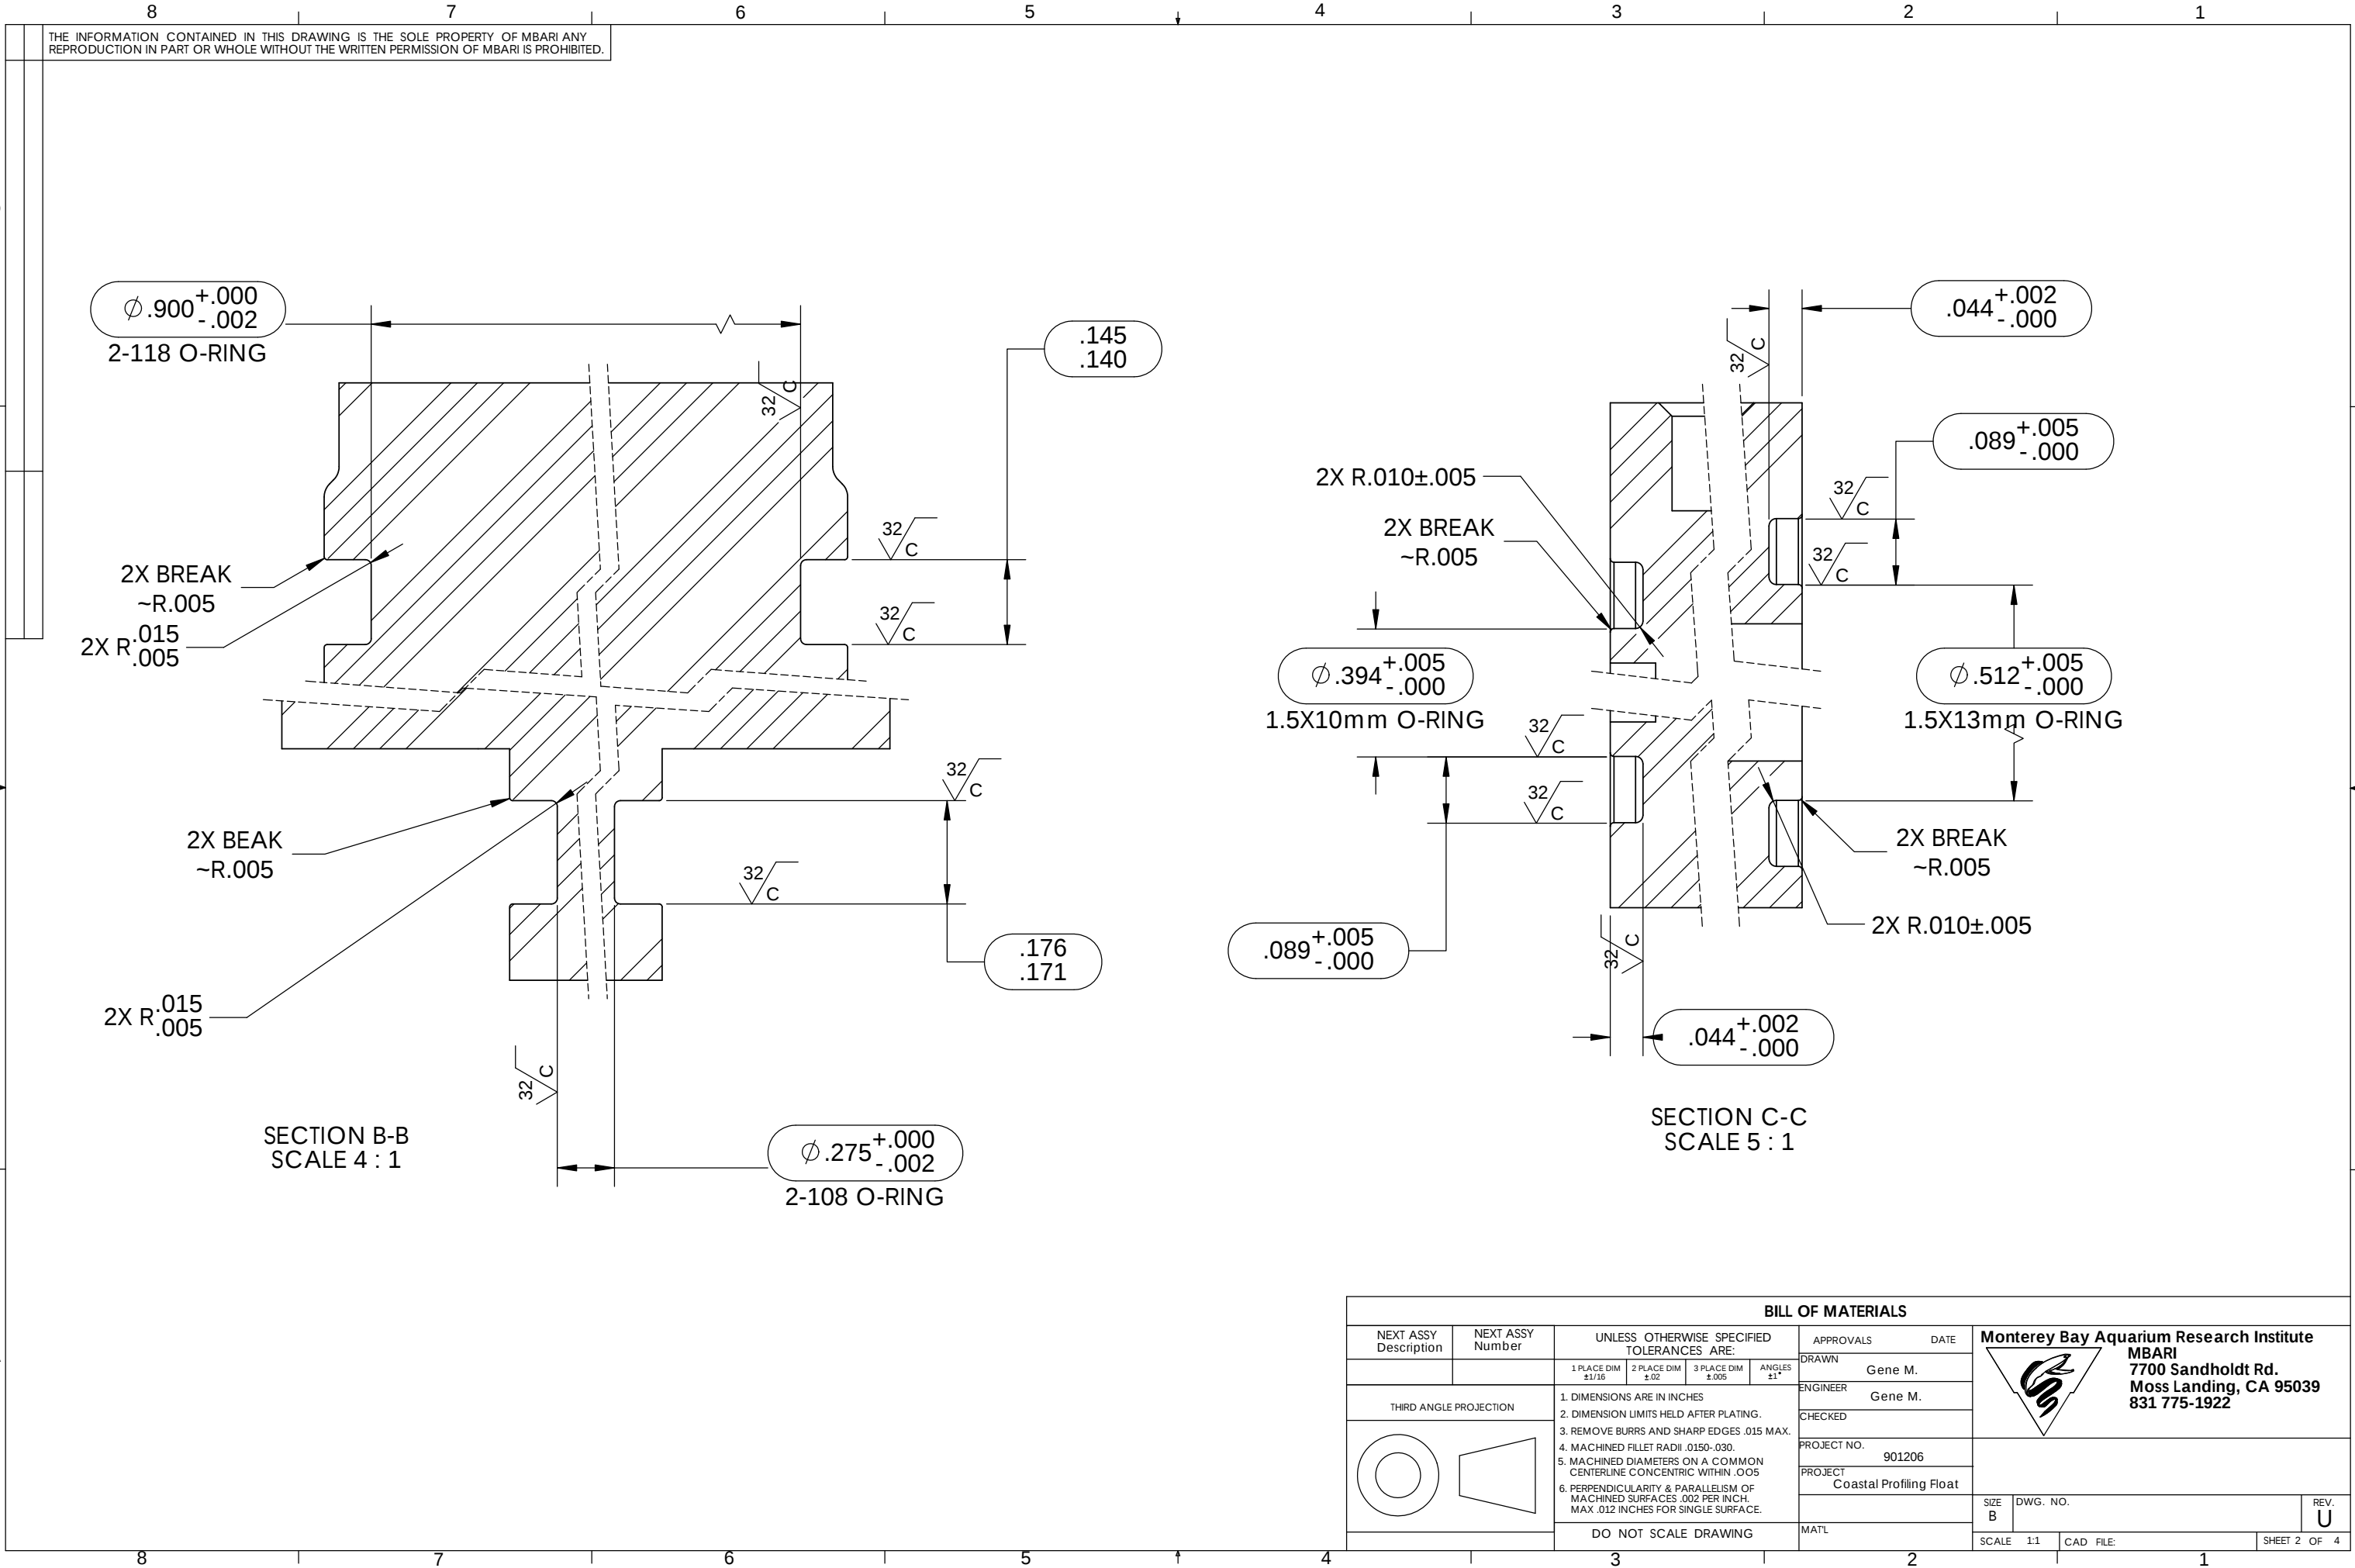



THE INFORMATION CONTAINED IN THIS DRAWING IS THE SOLE PROPERTY OF MBARI ANY REPRODUCTION IN PART OR WHOLE WITHOUT THE WRITTEN PERMISSION OF MBARI IS PROHIBITED.


SECTION B-B
SCALE 4 : 1


SECTION C-C
SCALE 5 : 1

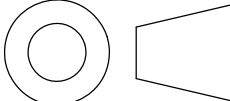BILL OF MATERIALS											
NEXT ASSY Description	NEXT ASSY Number	UNLESS OTHERWISE SPECIFIED TOLERANCES ARE:				APPROVALS		DATE		 Monterey Bay Aquarium Research Institute MBARI 7700 Sandholdt Rd. Moss Landing, CA 95039 831 775-1922	
		1 PLACE DIM ±1/16	2 PLACE DIM ±.02	3 PLACE DIM ±.005	ANGLES ±1°	DRAWN	Gene M.				
THIRD ANGLE PROJECTION		1. DIMENSIONS ARE IN INCHES 2. DIMENSION LIMITS HELD AFTER PLATING. 3. REMOVE BURRS AND SHARP EDGES .015 MAX. 4. MACHINED FILET RADII .0150-.030. 5. MACHINED DIAMETERS ON A COMMON CENTERLINE CONCENTRIC WITHIN .005 6. PERPENDICULARITY & PARALLELISM OF MACHINED SURFACES .002 PER INCH. MAX .012 INCHES FOR SINGLE SURFACE.				ENGINEER	Gene M.				
						CHECKED					
						PROJECT NO.	901206				
						PROJECT	Coastal Profiling Float				
						SIZE	DWG. NO.	REV.			
						MAT'L		B			U
		DO NOT SCALE DRAWING <th colspan="2"></th> <th>SCALE</th> <th>1:1</th> <th>CAD FILE:</th> <th>SHEET 2 OF 4</th>						SCALE	1:1		CAD FILE:

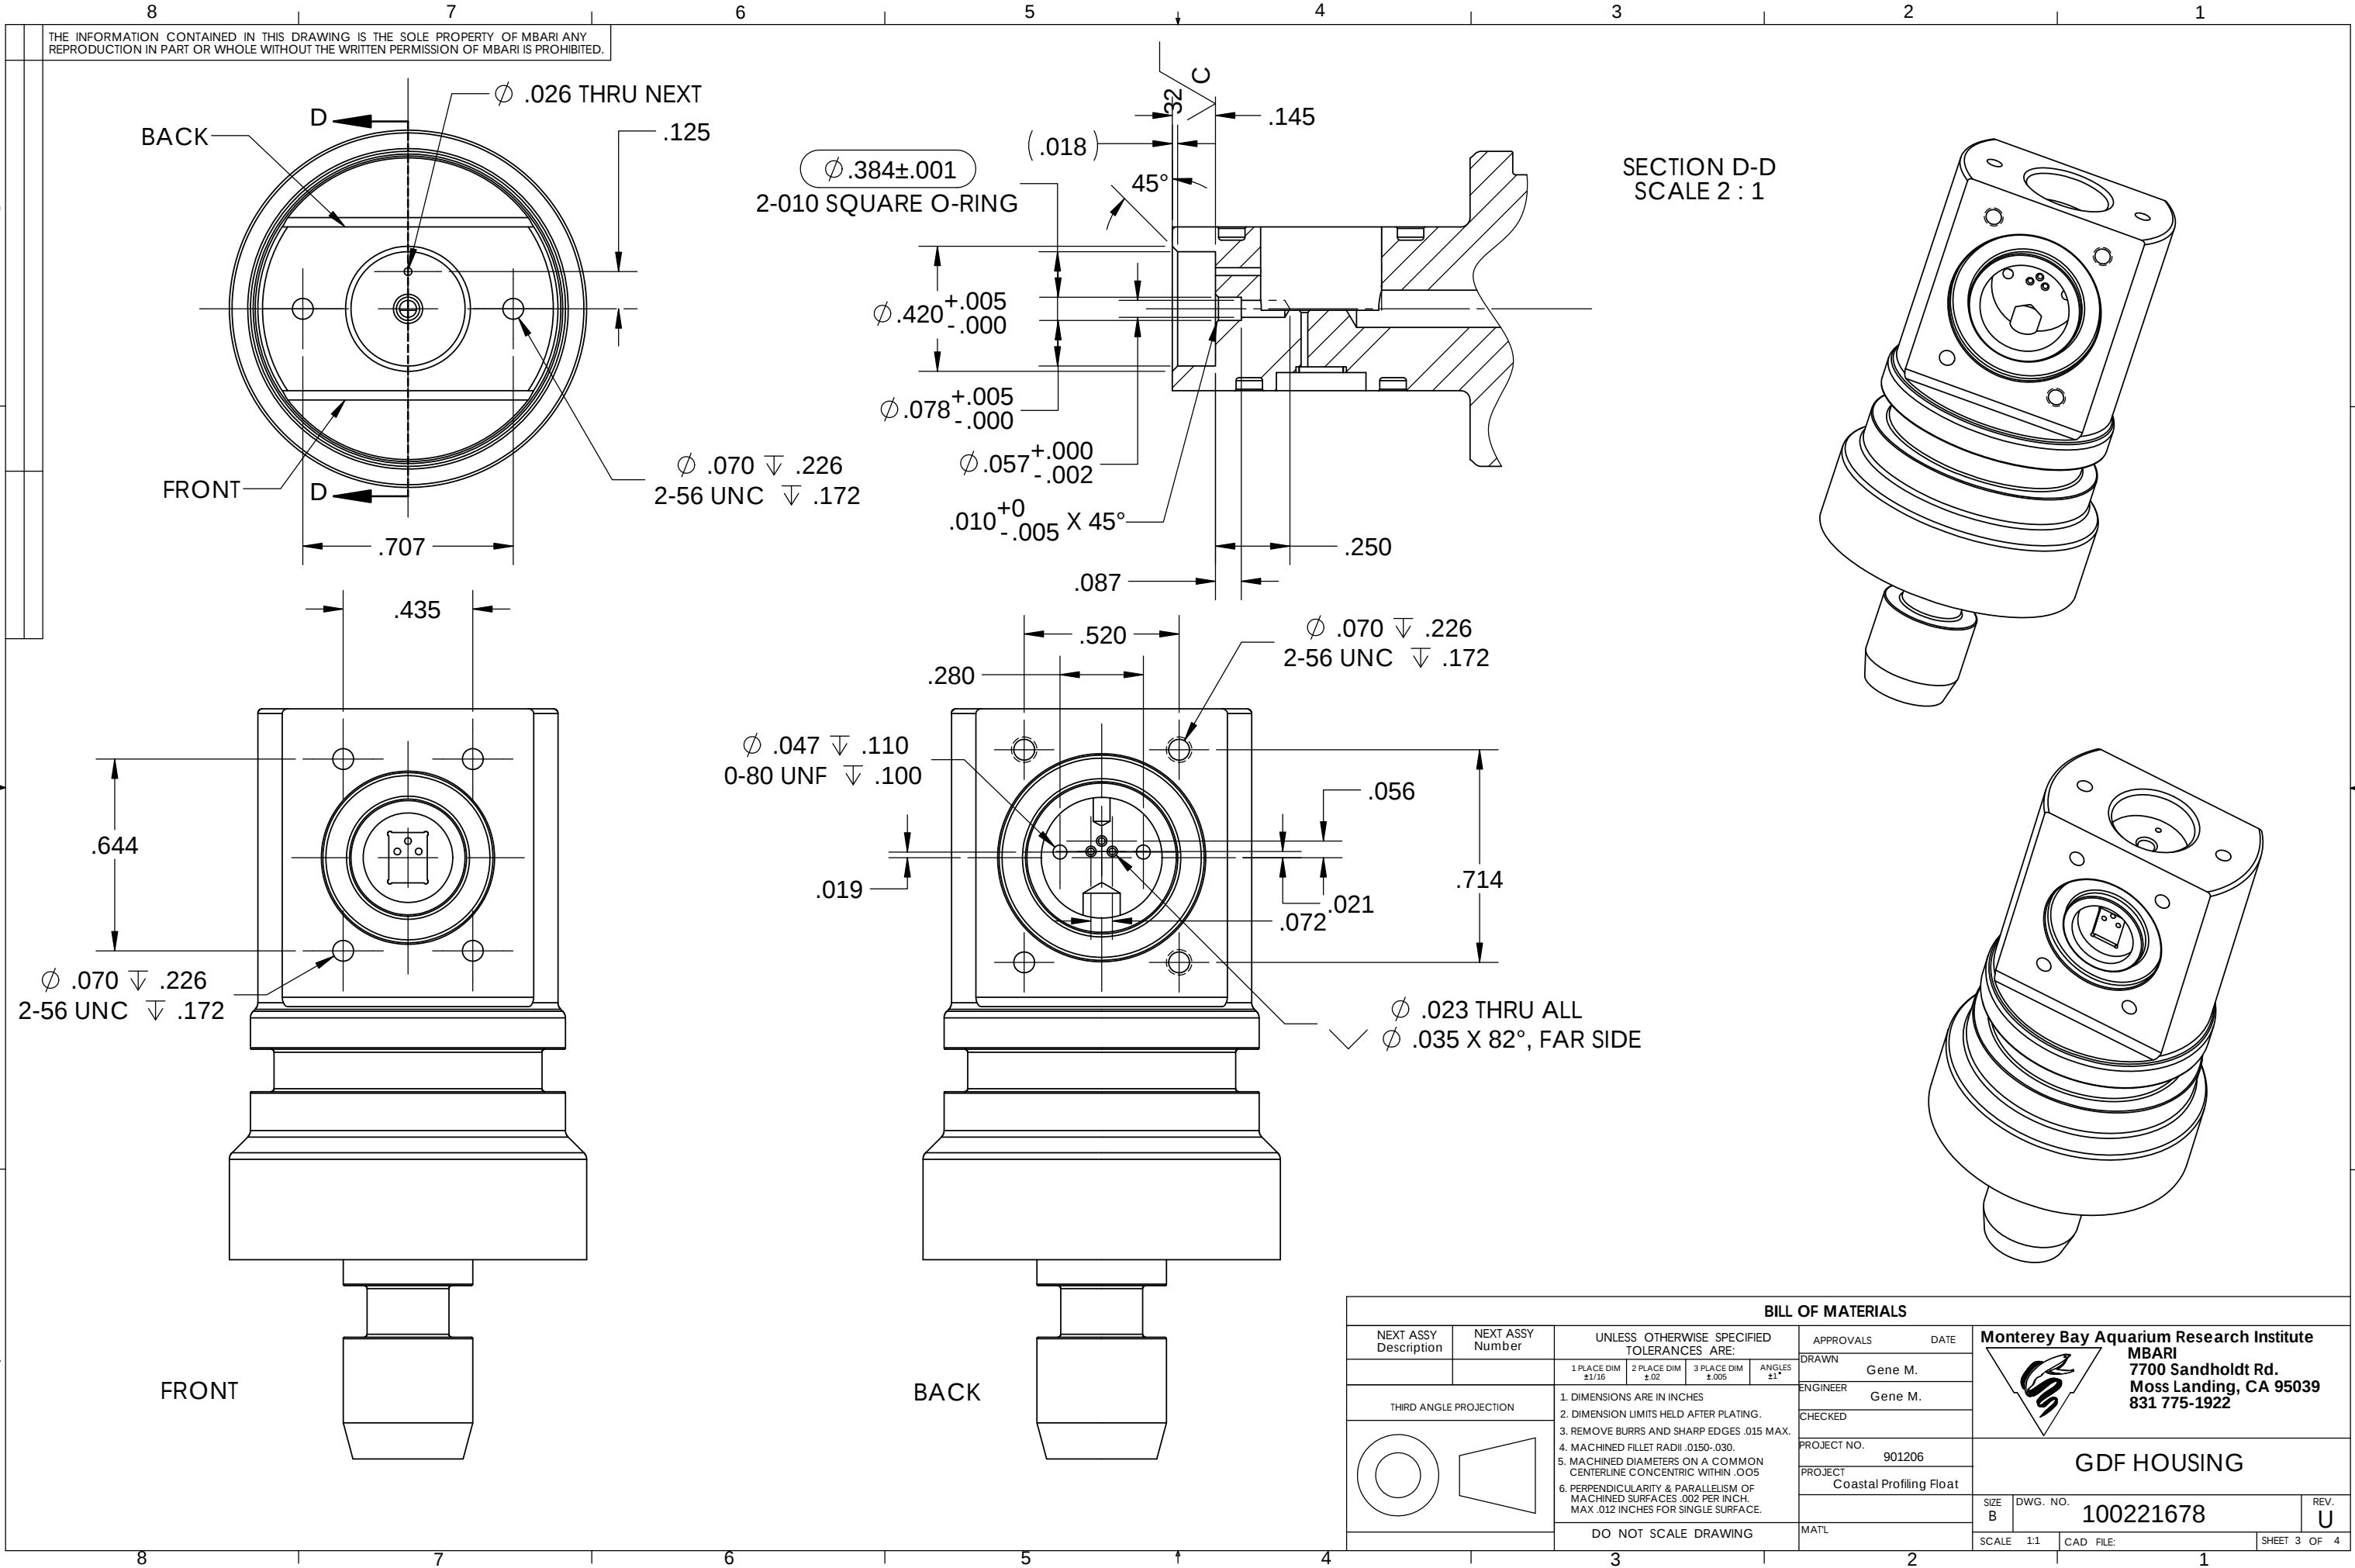

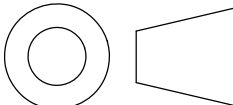BILL OF MATERIALS										
NEXT ASSY Description	NEXT ASSY Number	UNLESS OTHERWISE SPECIFIED TOLERANCES ARE:			APPROVALS		DATE			 Monterey Bay Aquarium Research Institute MBARI 7700 Sandholdt Rd. Moss Landing, CA 95039 831 775-1922
		1 PLACE DIM ±1/16	2 PLACE DIM ±.02	3 PLACE DIM ±.005	ANGLES ±1°	DRAWN	Gene M.			
THIRD ANGLE PROJECTION		1. DIMENSIONS ARE IN INCHES 2. DIMENSION LIMITS HELD AFTER PLATING. 3. REMOVE BURRS AND SHARP EDGES .015 MAX. 4. MACHINED FILLET RADII .0150-.030. 5. MACHINED DIAMETERS ON A COMMON CENTERLINE CONCENTRIC WITHIN .005 6. PERPENDICULARITY & PARALLELISM OF MACHINED SURFACES .002 PER INCH. MAX .012 INCHES FOR SINGLE SURFACE.				ENGINEER	Gene M.			
						CHECKED				
						PROJECT NO.	901206		GDF HOUSING	
						PROJECT	Coastal Profiling Float			
		DO NOT SCALE DRAWING				MATL	SIZE B		DWG. NO. 100221678	REV. U
						SCALE 1:1		CAD FILE:		SHEET 3 OF 4

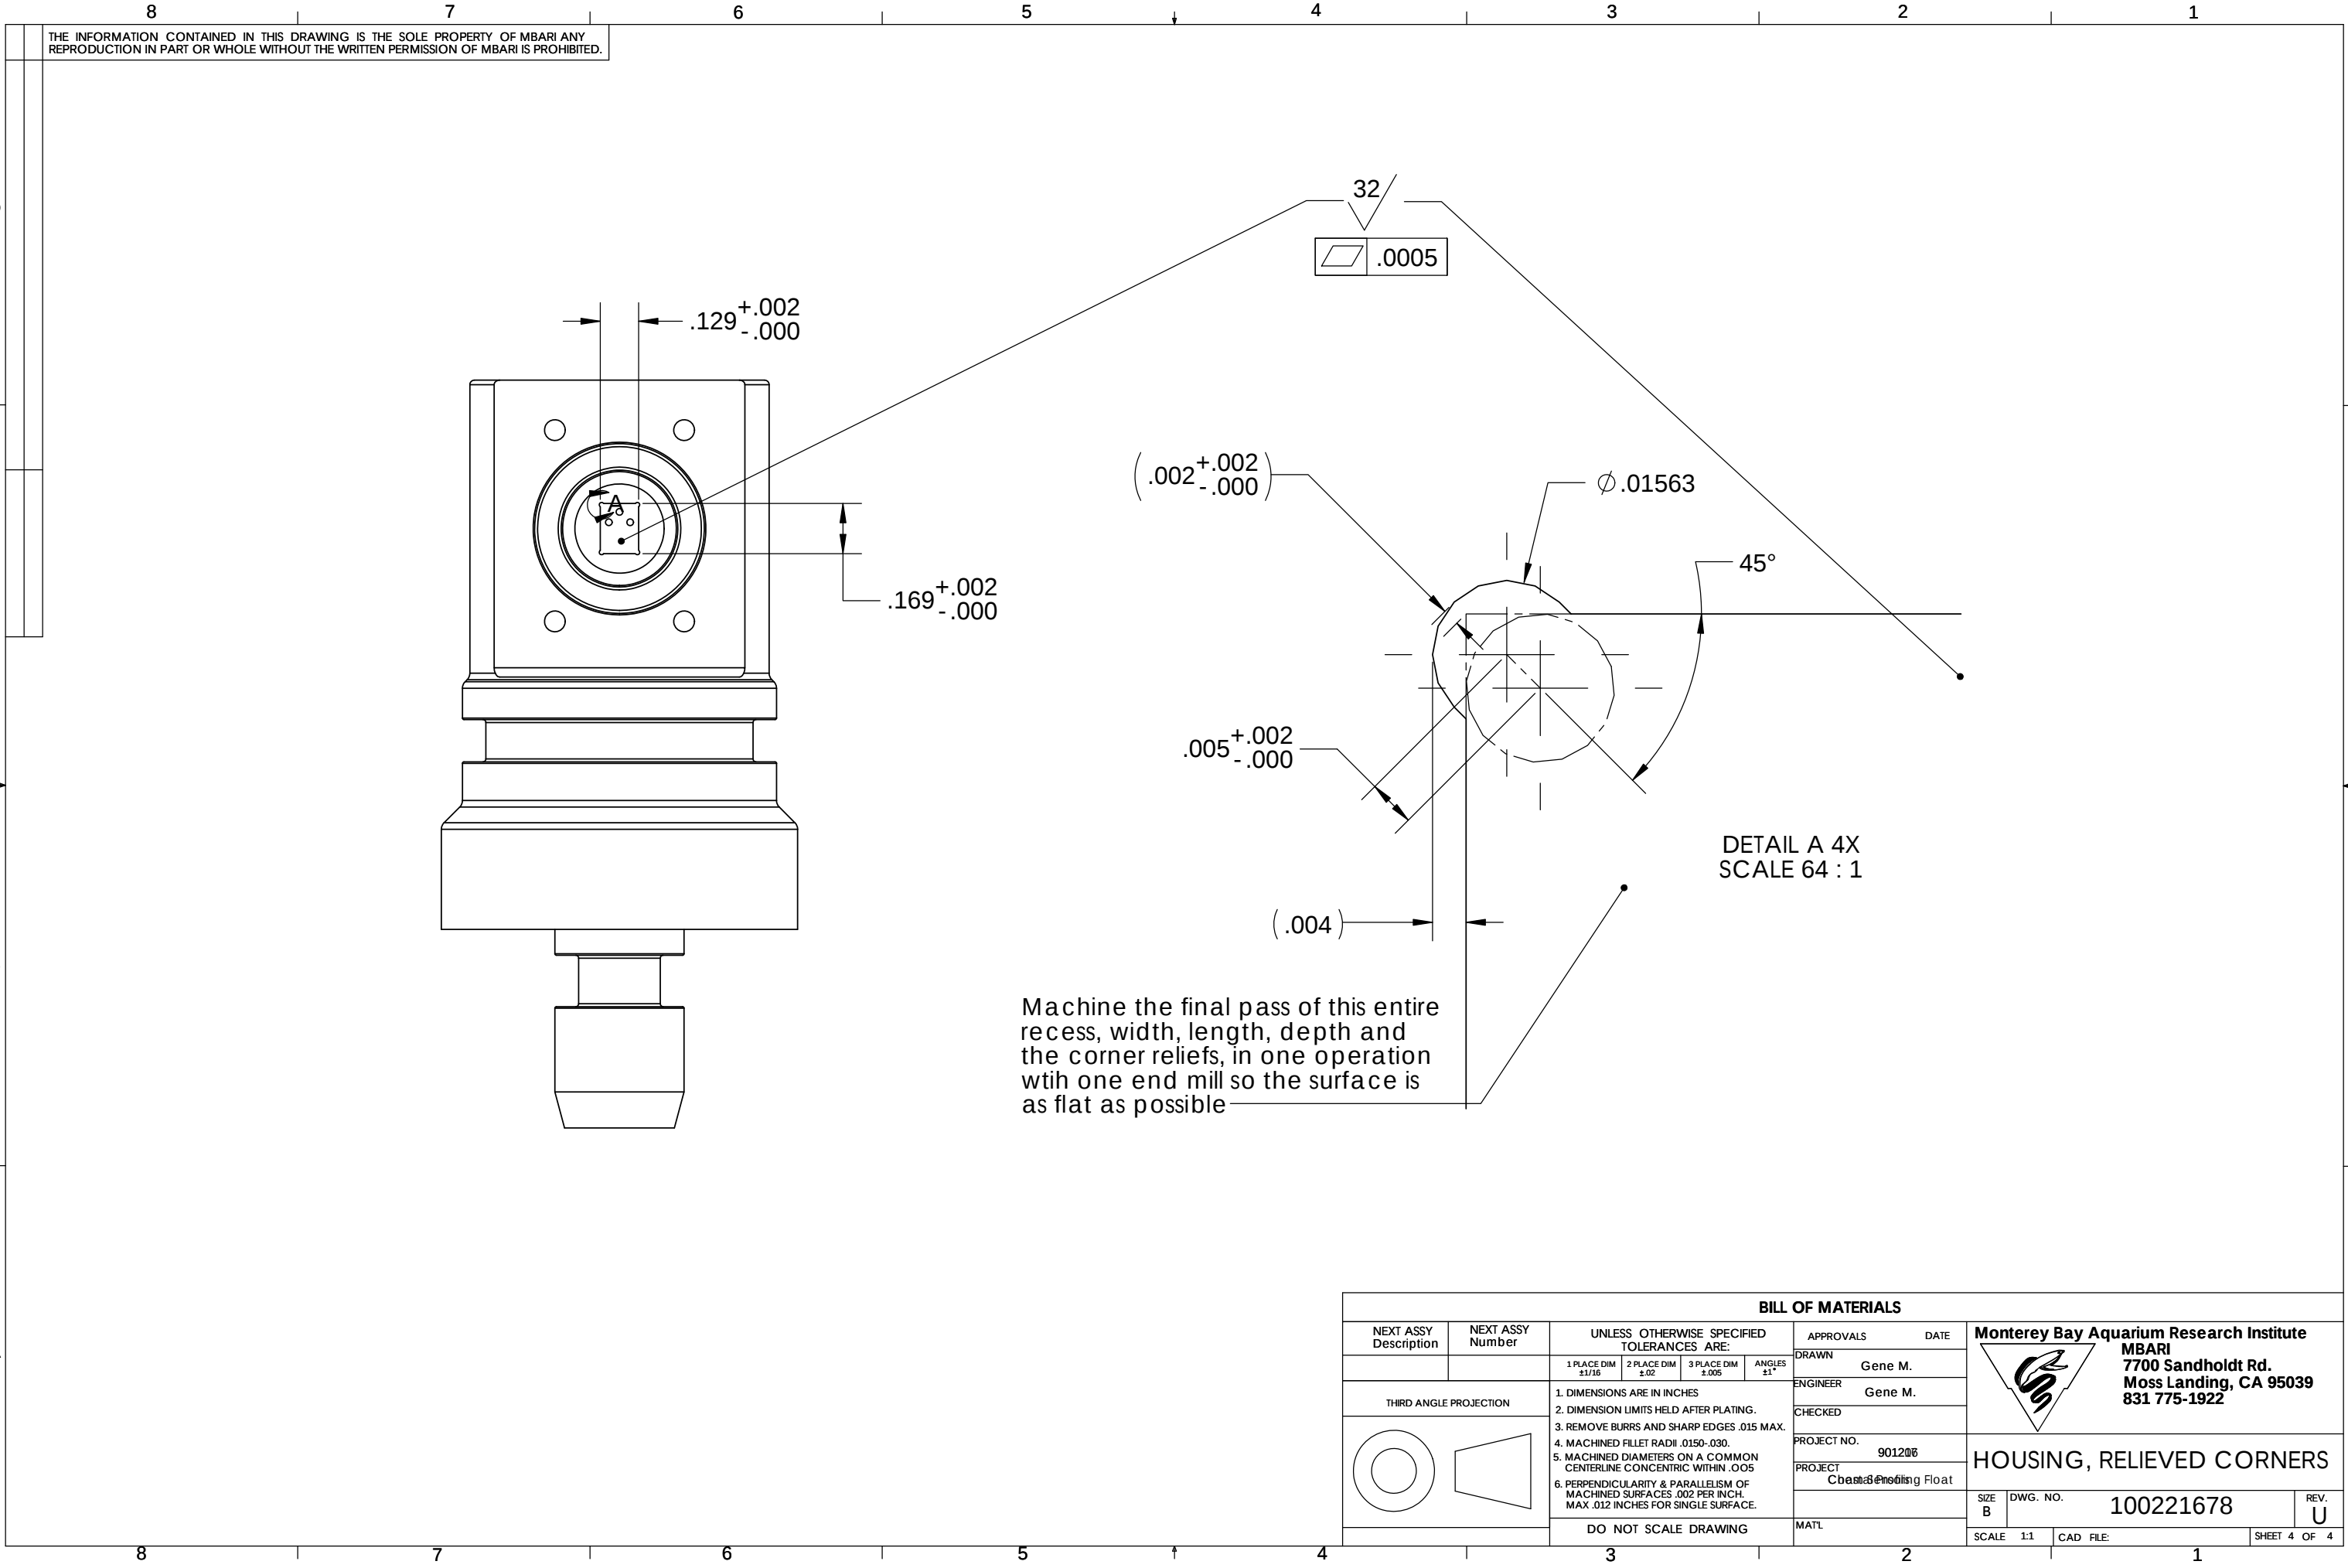

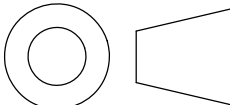BILL OF MATERIALS										
NEXT ASSY Description	NEXT ASSY Number	UNLESS OTHERWISE SPECIFIED TOLERANCES ARE:			APPROVALS		 Monterey Bay Aquarium Research Institute MBARI 7700 Sandholdt Rd. Moss Landing, CA 95039 831 775-1922			
					DRAWN	Gene M.				
THIRD ANGLE PROJECTION 		1 PLACE DIM ±1/16	2 PLACE DIM ±.02	3 PLACE DIM ±.005	ANGLES ±1°	ENGINEER				Gene M.
		CHECKED								
		PROJECT NO. 9012006								
PROJECT Channeling Float					HOUSING, RELIEVED CORNERS					
DO NOT SCALE DRAWING					MTRL		SIZE B	DWG. NO. 100221678	REV. U	
					SCALE 1:1		CAD FILE:		SHEET 4 OF 4	



Monterey Bay Aquarium Research Institute
MBARI
7700 Sandholdt Rd.
Moss Landing, CA 95039
831 775-1922

THE INFORMATION CONTAINED IN THIS DRAWING IS THE SOLE PROPERTY OF MBARI ANY REPRODUCTION IN PART OR WHOLE WITHOUT THE WRITTEN PERMISSION OF MBARI IS PROHIBITED.