
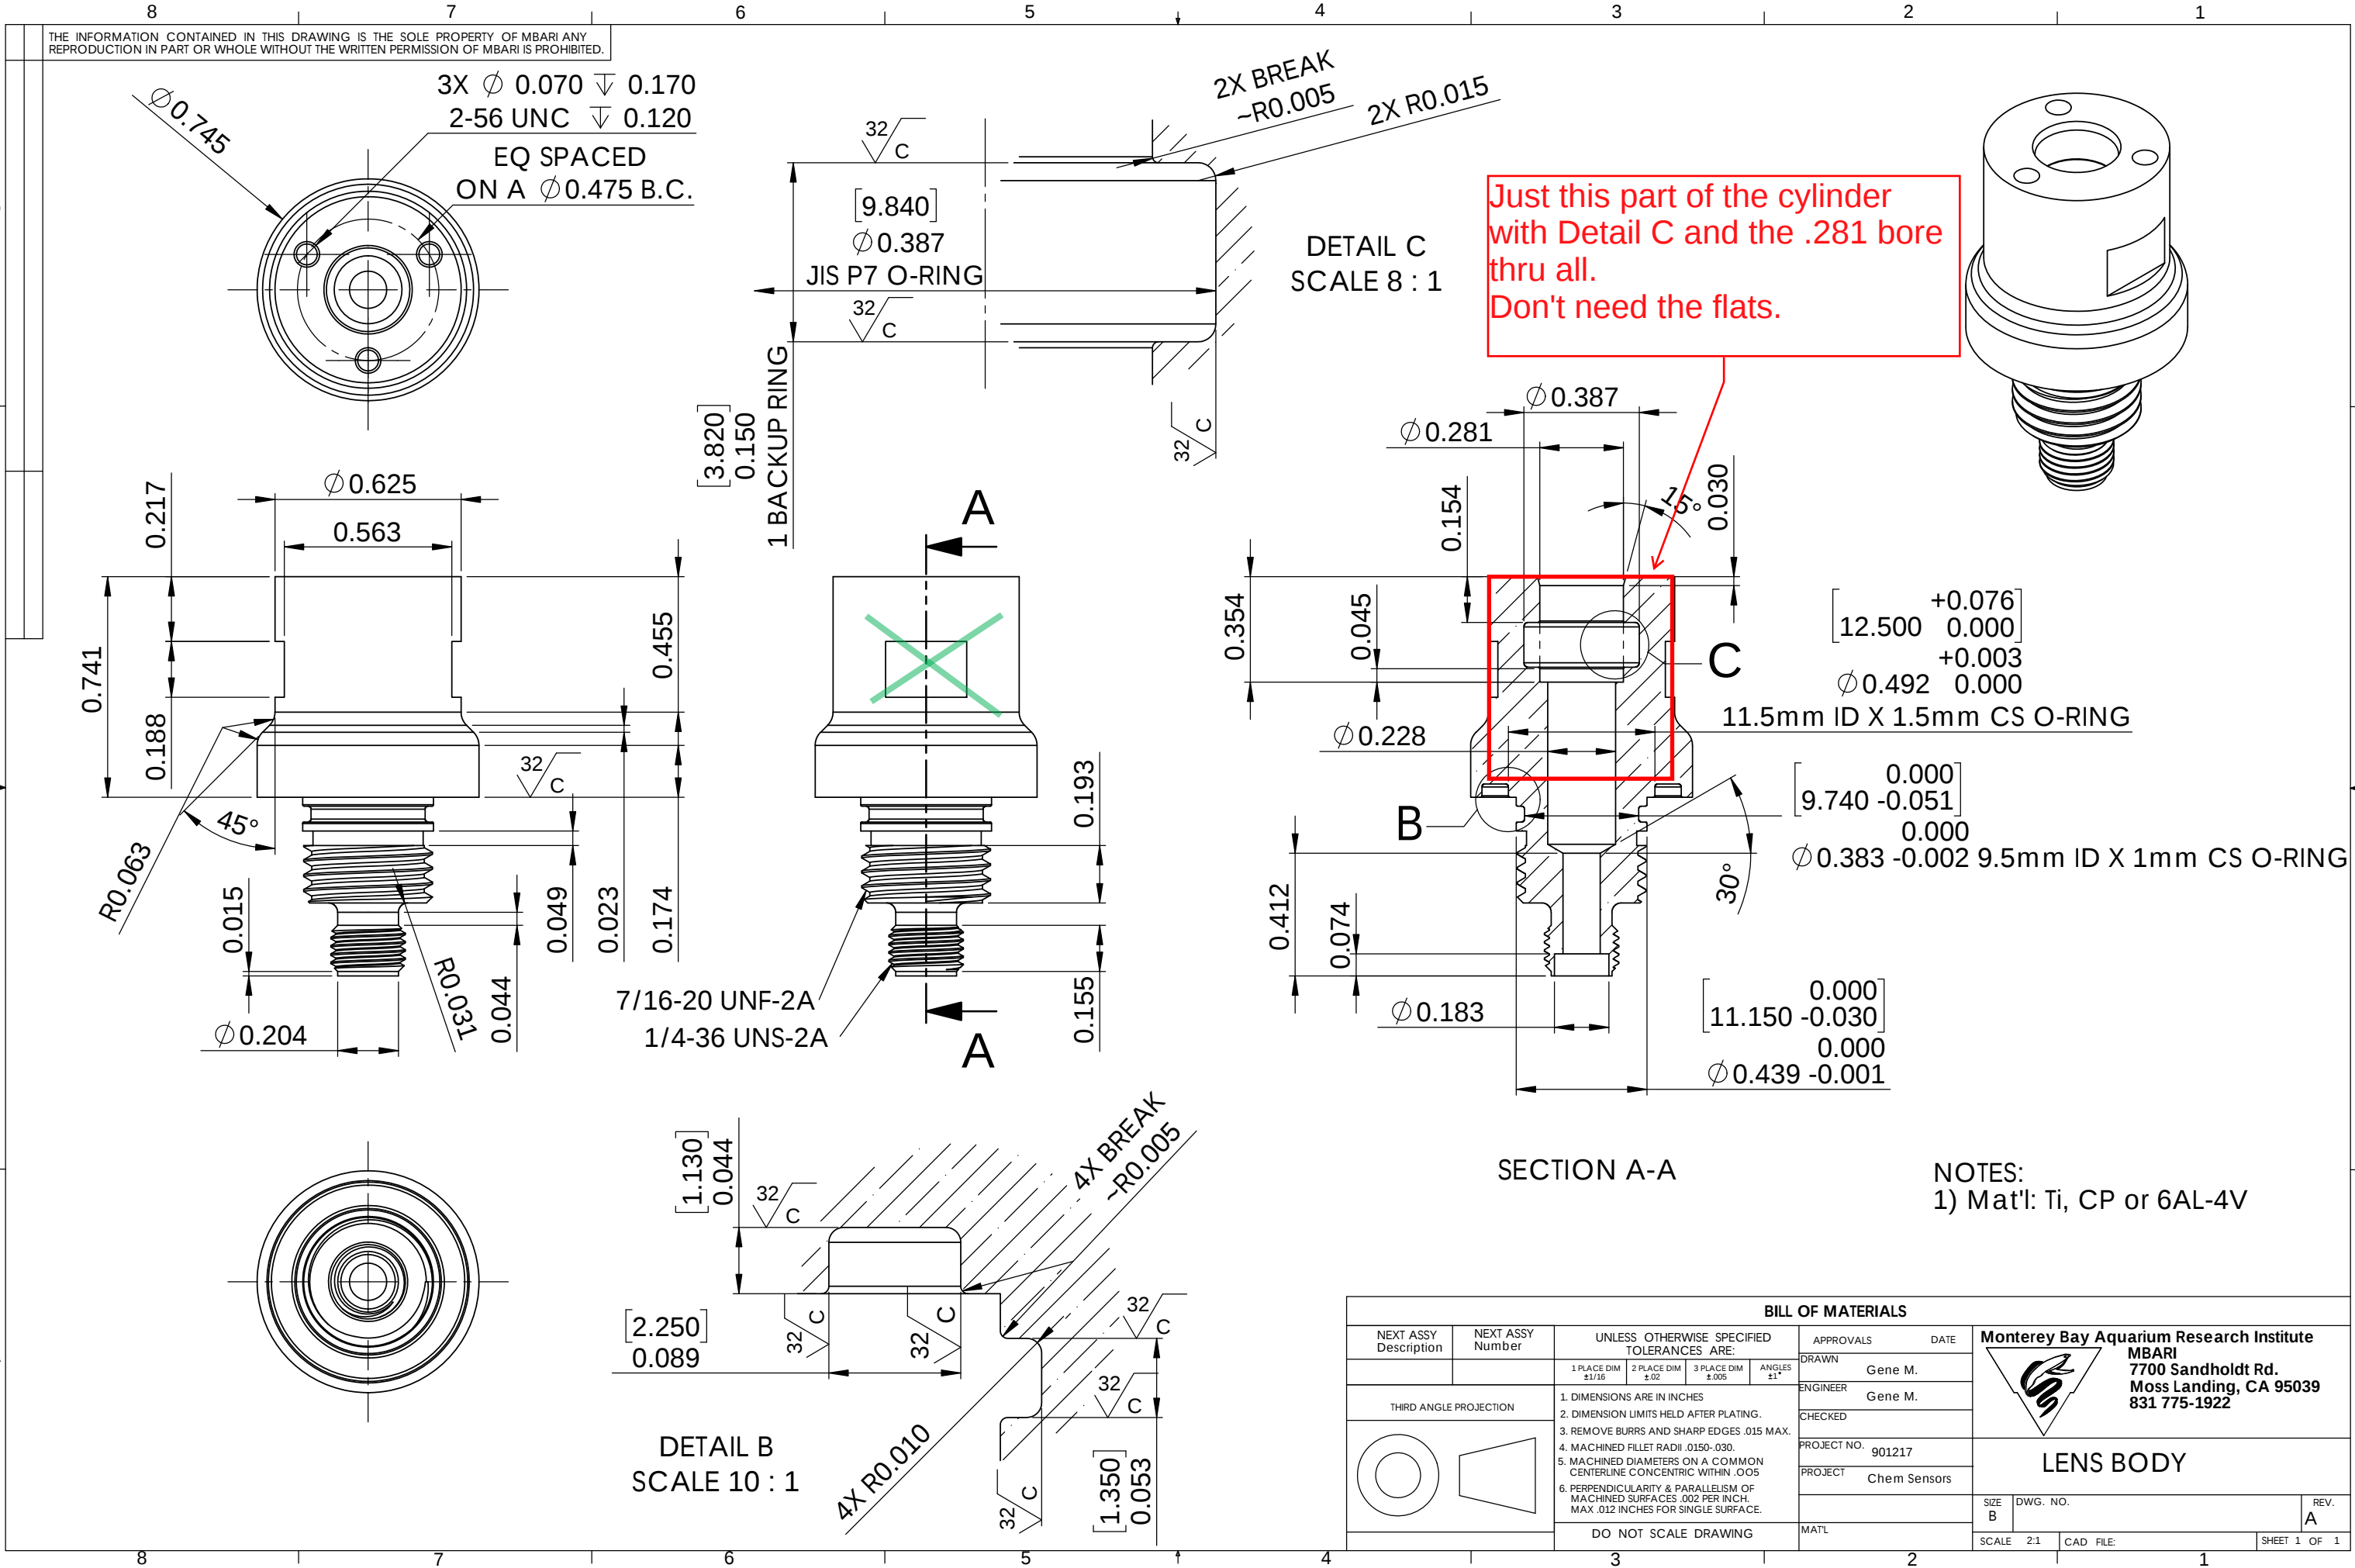


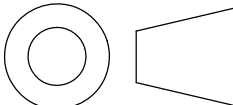

BILL OF MATERIALS										
NEXT ASSY Description	NEXT ASSY Number	UNLESS OTHERWISE SPECIFIED TOLERANCES ARE:			APPROVALS		DATE			 Monterey Bay Aquarium Research Institute MBARI 7700 Sandholdt Rd. Moss Landing, CA 95039 831 775-1922
		1 PLACE DIM ±1/16	2 PLACE DIM ±.02	3 PLACE DIM ±.005	ANGLES ±1°	DRAWN	Gene M.			
					ENGINEER	Gene M.				
					CHECKED					
THIRD ANGLE PROJECTION		1. DIMENSIONS ARE IN INCHES 2. DIMENSION LIMITS HELD AFTER PLATING. 3. REMOVE BURRS AND SHARP EDGES .015 MAX. 4. MACHINED FILLET RADII .0150-.030. 5. MACHINED DIAMETERS ON A COMMON CENTERLINE CONCENTRIC WITHIN .005 6. PERPENDICULARITY & PARALLELISM OF MACHINED SURFACES .002 PER INCH. MAX .012 INCHES FOR SINGLE SURFACE. 			PROJECT NO.	901217				
					PROJECT	Chem Sensors				
		DO NOT SCALE DRAWING			MAT'L		SIZE B		DWG. NO.	REV. A
							SCALE 2:1		CAD FILE:	SHEET 1 OF 1

MBARI
7700 Sandholdt Rd.
Moss Landing, CA 95039
831 775-1922

LENS BODY

REV. A