


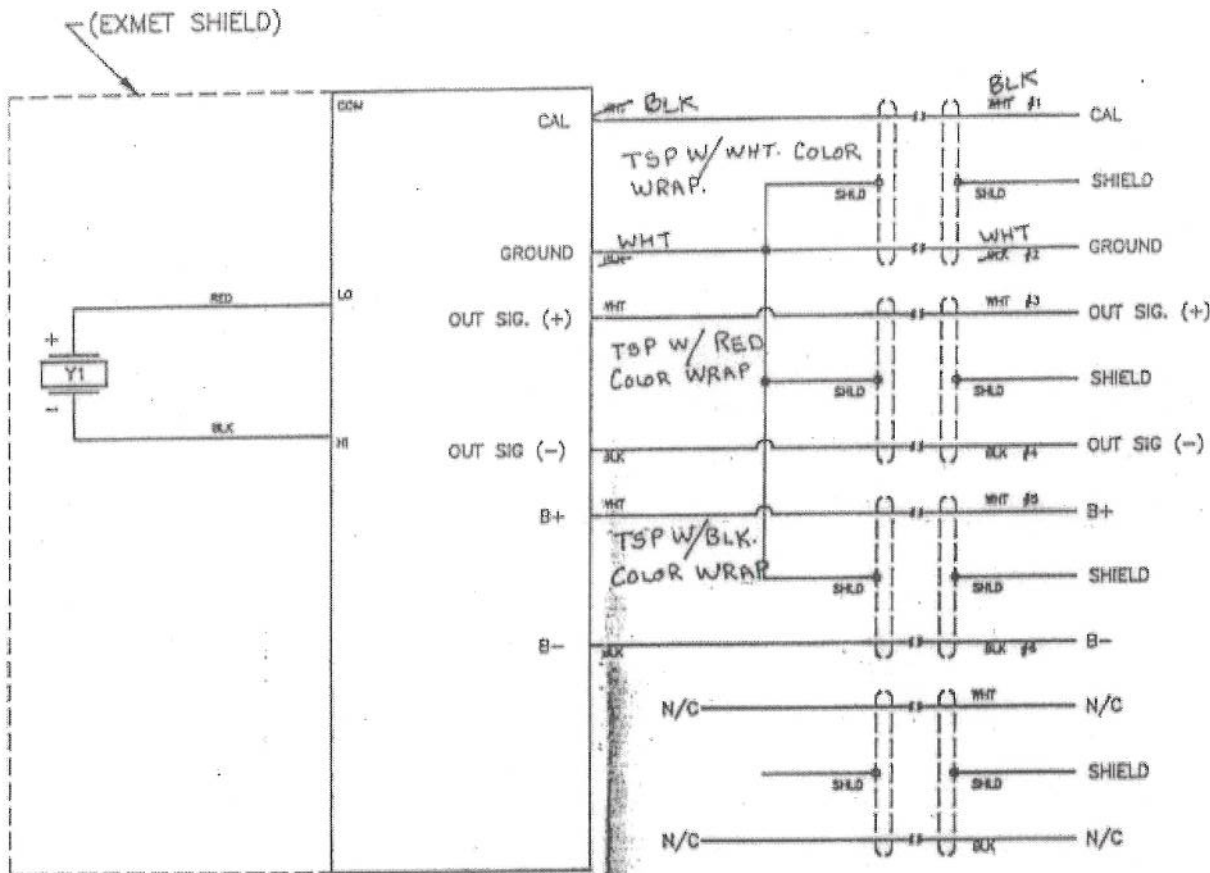

WIRING DIAGRAM

MAY 18 1999

SEE AECO'S

FILE COPY

UNLESS OTHERWISE SPECIFIED: DIMENSIONS ARE IN INCHES TOLERANCES DECIMALS .XX ± .02 ANGULAR ± .01 XXX ± .01 DO NOT SCALE DRAWING		CONTRACT NO.		INTERNATIONAL TRANSDUCER CORP SANTA BARBARA, CA 93111-2920	
DRAWN		J. JURQUIDI		DATE 5/6/93	
CHECK		R. BUTTON		5/17/93	
DESIGN					
DESIGN ACTIVITY					
CUSTOMER					
MATERIAL LISTED				TOP ASSEMBLY ITC-8201D	
FINISH NONE				SIZE D 17892	
TREATMENT NONE				FSCM NO. NOT ASSIGNED	
APPLICATION				DWG NO. 018887-1	
				SCALE 1:1 SYS B PATH SHEET 1 OF 4	