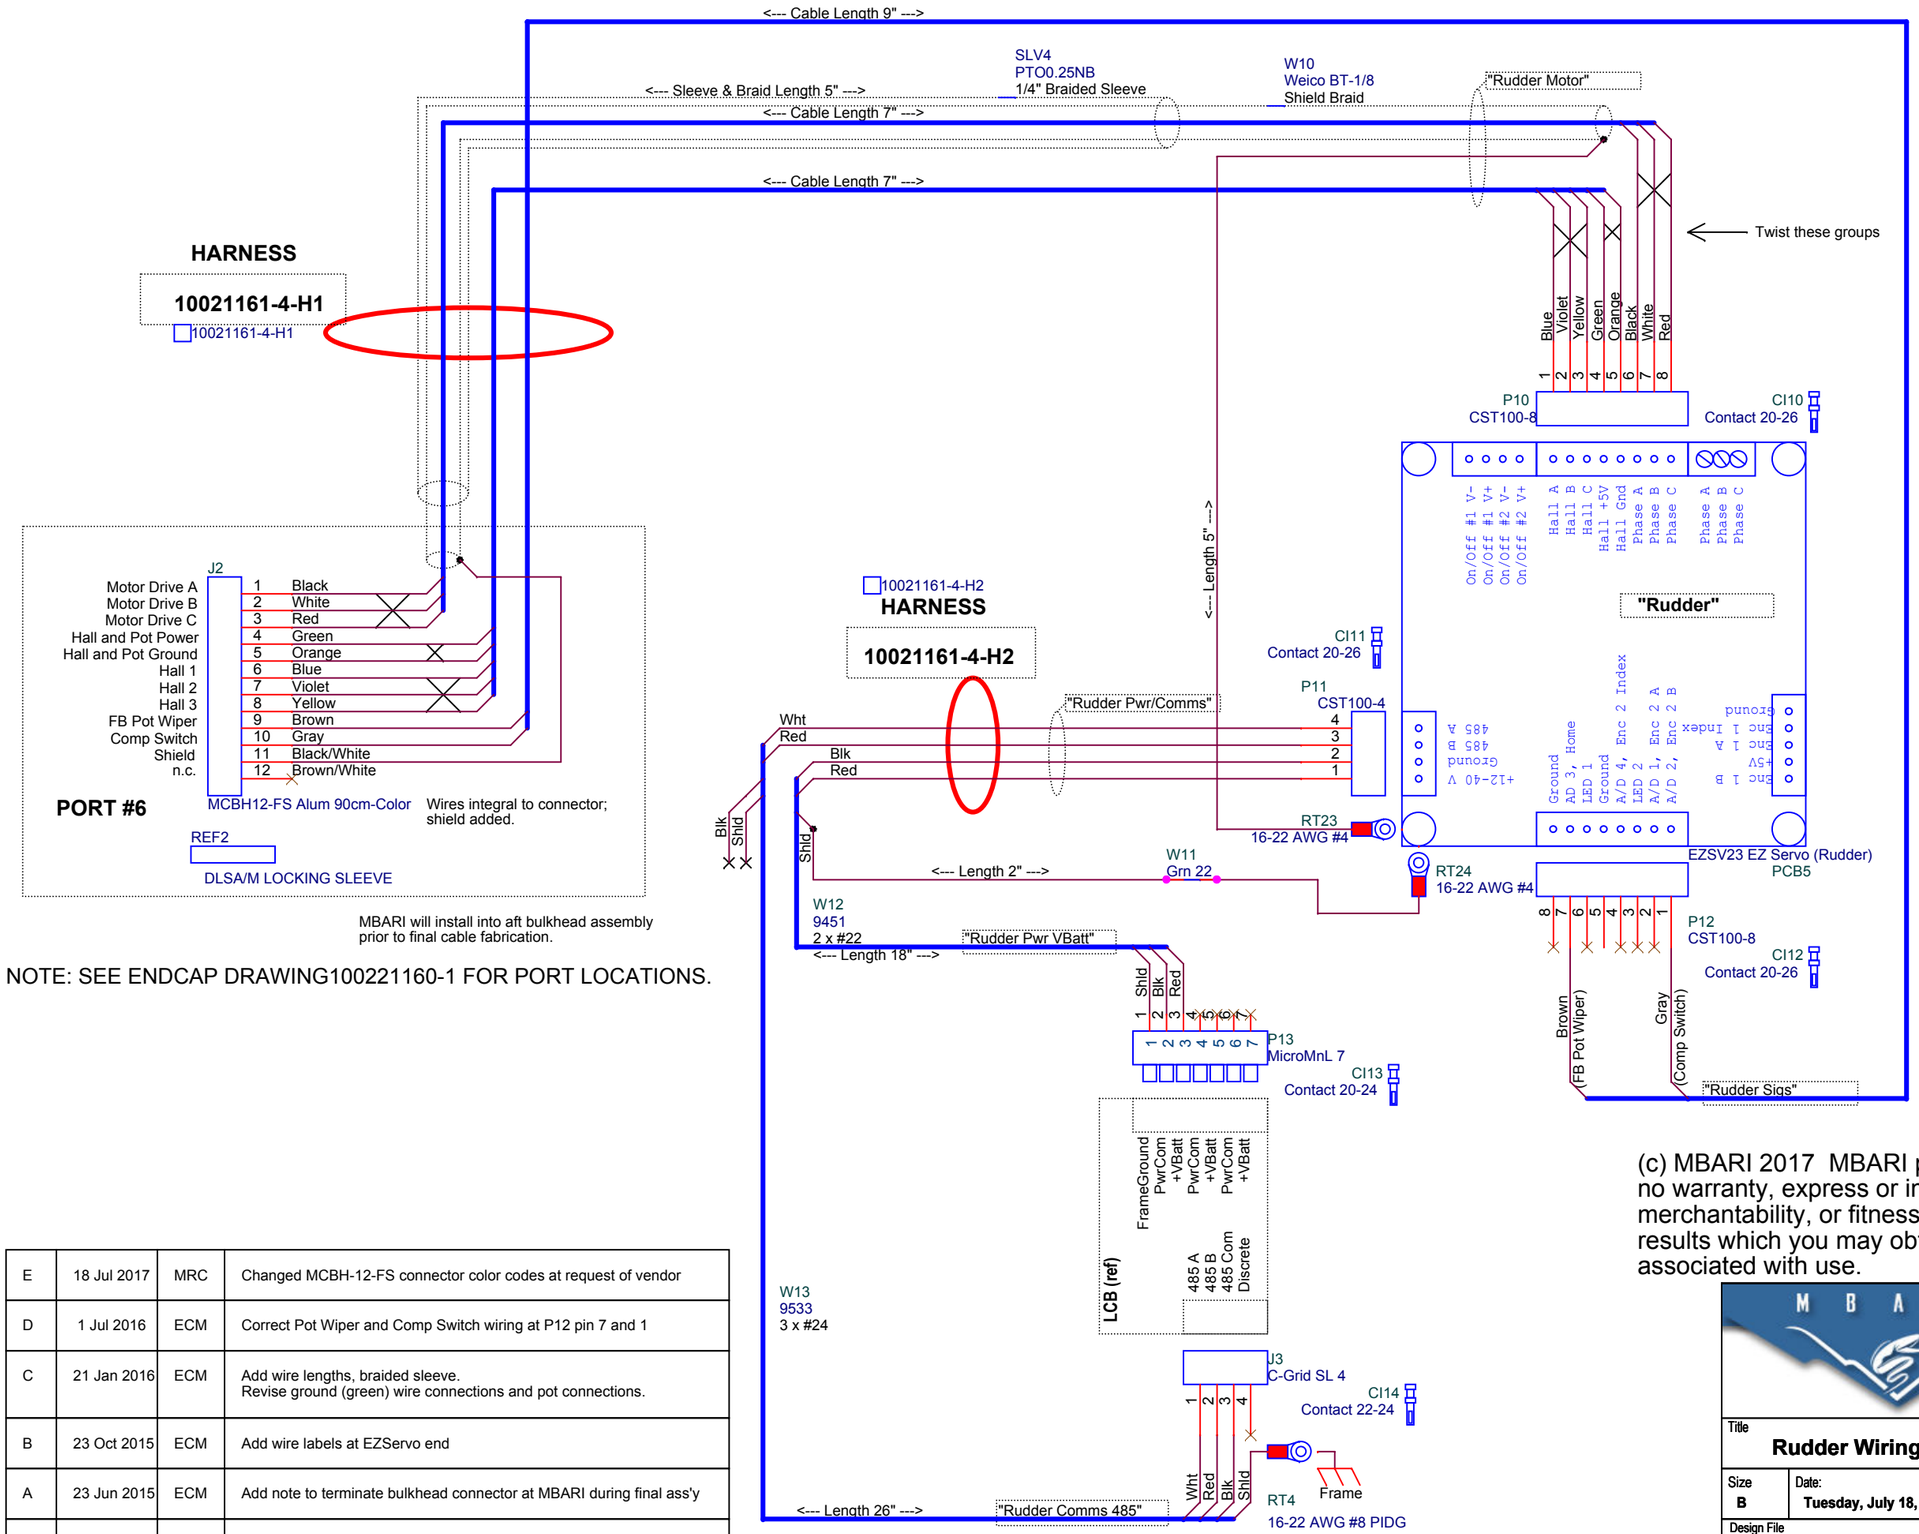

NOTE: SEE ENDCAP DRAWING100221160-1 FOR PORT LOCATIONS.

E	18 Jul 2017	MRC	Changed MCBH-12-FS connector color codes at request of vendor
D	1 Jul 2016	ECM	Correct Pot Wiper and Comp Switch wiring at P12 pin 7 and 1
C	21 Jan 2016	ECM	Add wire lengths, braided sleeve. Revise ground (green) wire connections and pot connections.
B	23 Oct 2015	ECM	Add wire labels at EZServo end
A	23 Jun 2015	ECM	Add note to terminate bulkhead connector at MBARI during final ass'y
--	11 Feb 2015	ECM	Fork from Dwg 10020580 "Makai Pressure Vessel2-5"

(c) MBARI 2017 MBARI provides the documentation and materials "as is", with no warranty, express or implied, as to title, non-infringement of third party rights, merchantability, or fitness for any particular purpose, or the performance or results which you may obtain from their use. You assume the entire risk associated with use.

Monterey Bay Aquarium Research Institute
7700 Sandholdt Road
Moss Landing, CA 95039
(831) 775-1700 www.mbari.org
(c) MBARI 2015

Title: **Rudder Wiring Fab, LRAUV5 Int Press Vess Wiring**		Document Number: **100221161-4-D**	Rev: **E**
Size: **B**	Date: **Tuesday, July 18, 2017**	Engineer: **Mellinger**	Sheet **4** of **14**
Design File: \\ATLAS\PROJECTLIBRARY\LRAUV5\DRAWINGS\EE\LRAUVWIRING\SYSTEMWIRING\100221189_LRAUV_BUILD5_SYSTEMWIRINGDRAWINGSET.DSN			
Schematic Name: **LRAUV5BuildInternalWiring**	Page Name: **04 Rudder Wiring Fab**	Layout File: **<Layout File>**	