


10/9/2015

tie VUSB AND AVDD TO 3.3, add C49 at AVDD
change to PIC32MX575F256H-801/PT
REMOVE LED, ADD J9 FOR EXTERNAL LED
CHANGE TO pic24

10/22/2015

11/24/2015

move 48,49 to 46/47

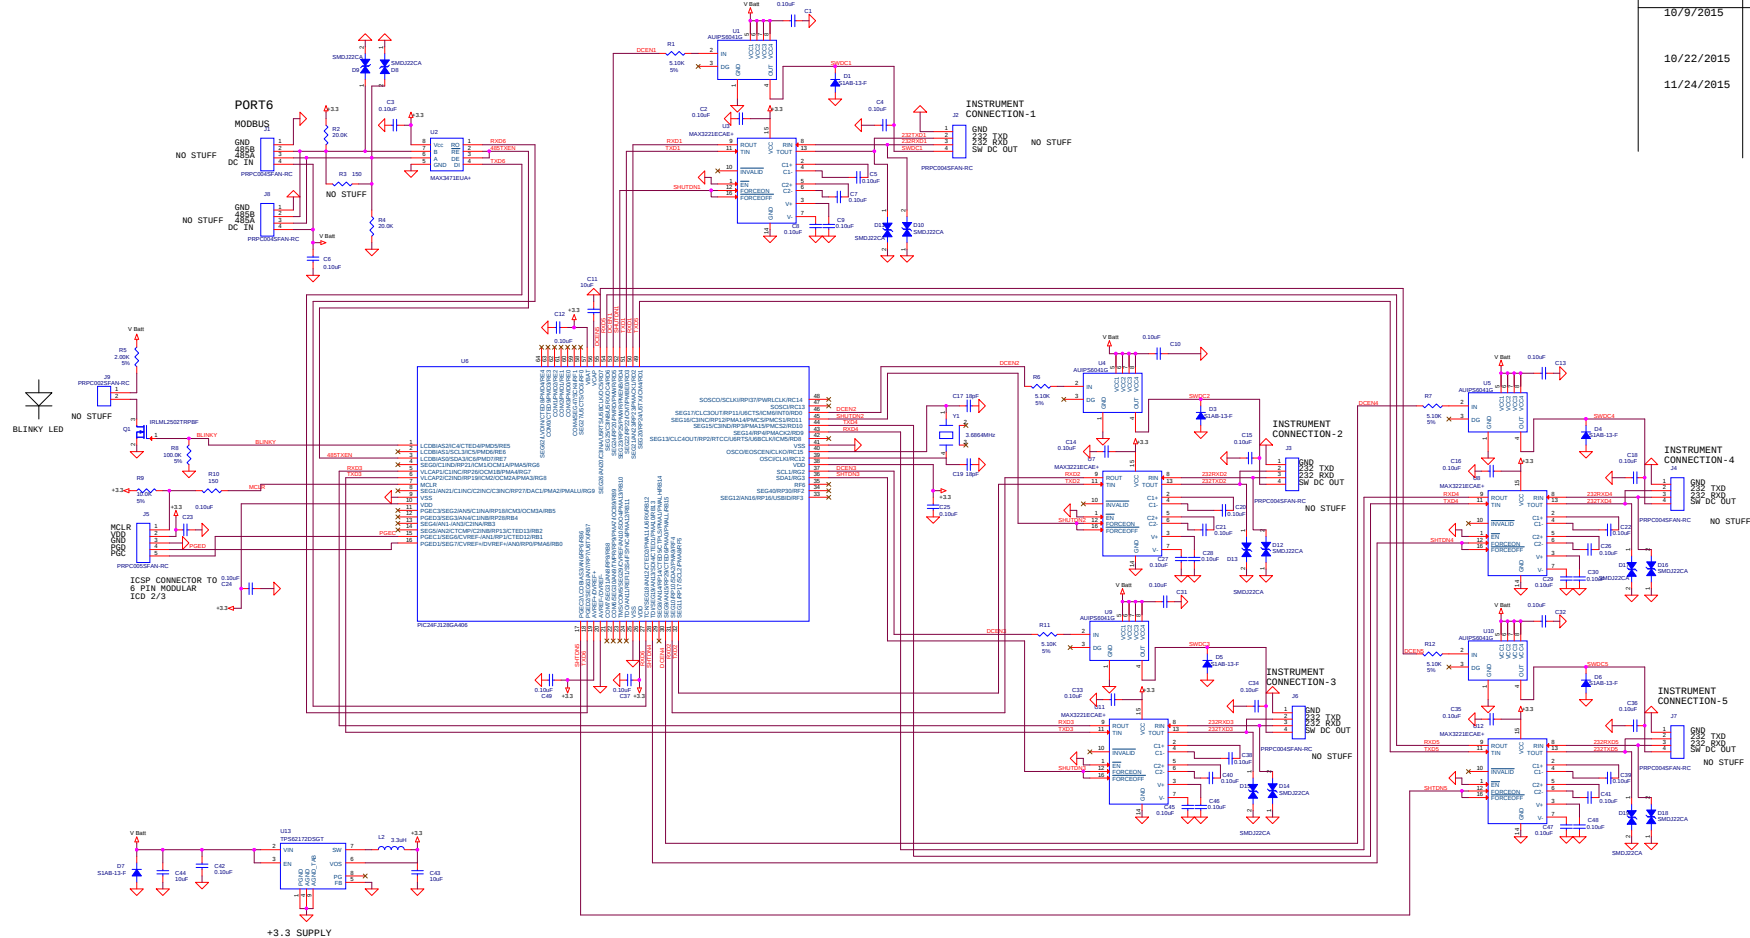

NOTES:

REV C 11/24/2015
REV B 10/24/2015
REV A 10/9/2015
DRAFT 3/25/2015

5-PIN EXPANDER BOARD			
Rev	Document Number	Rev	Doc
1	000	1	000