


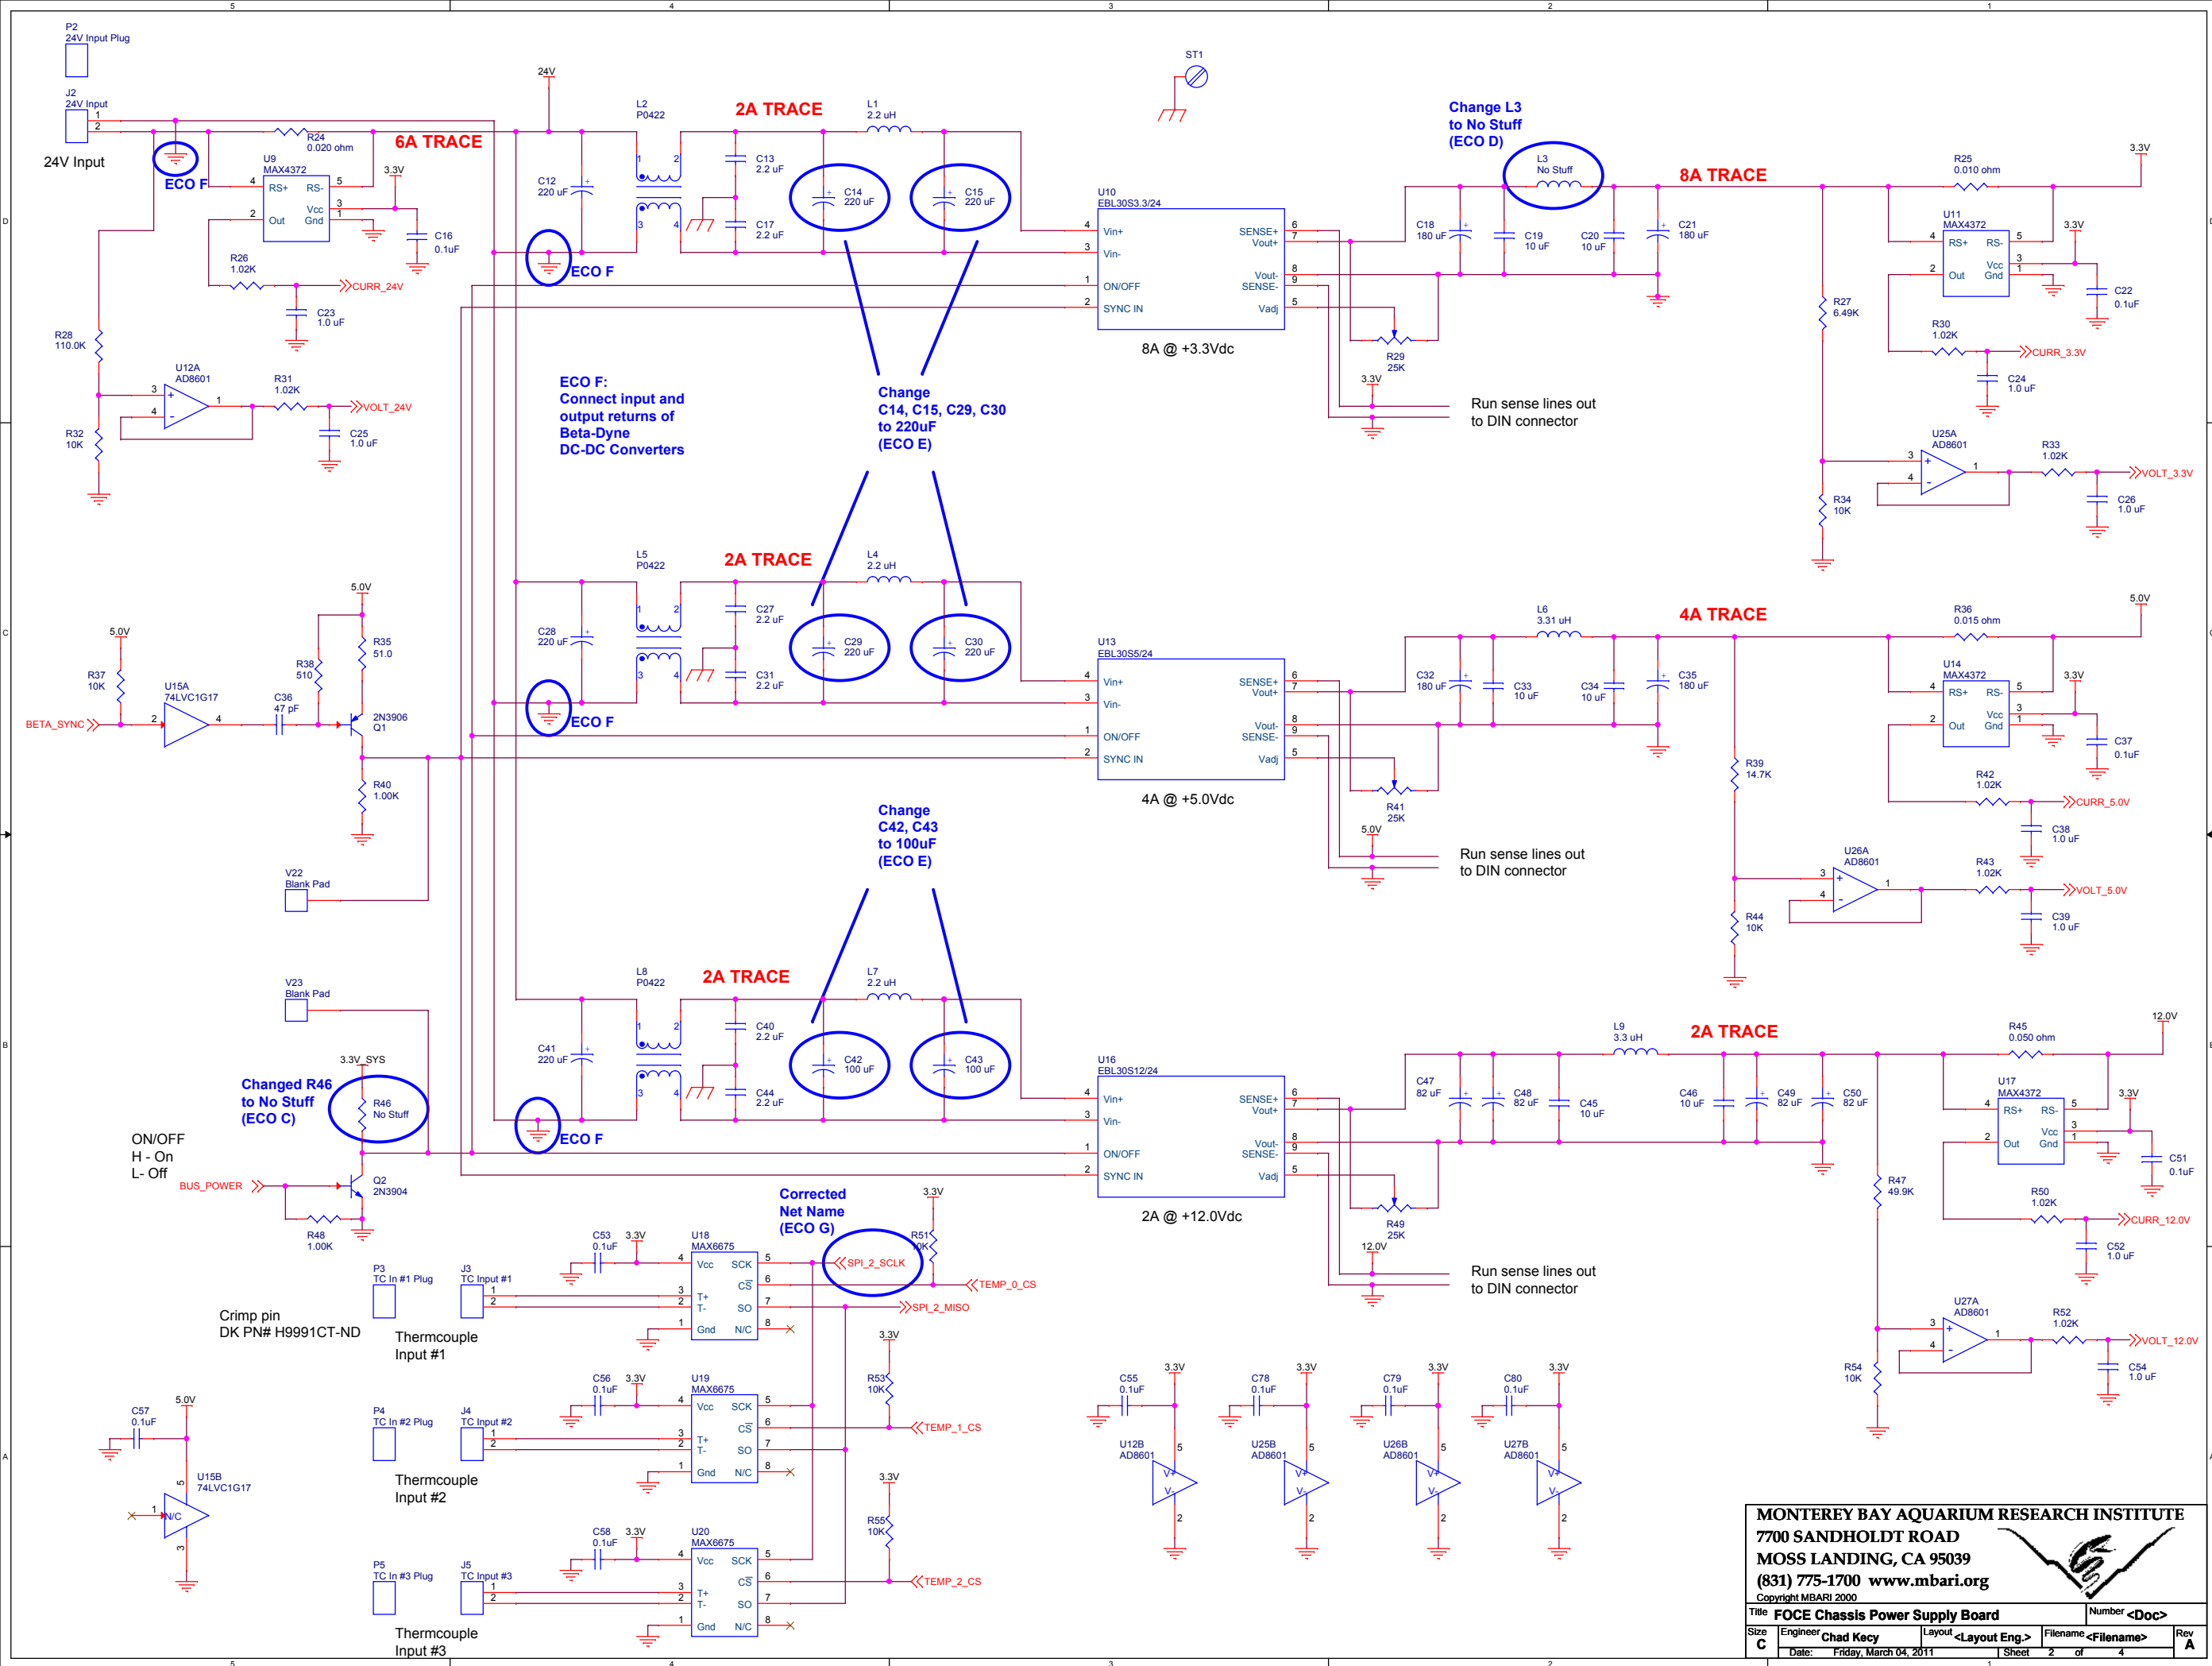

MONTEREY BAY AQUARIUM RESEARCH INSTITUTE
7700 SANDHOLDT ROAD
MOSS LANDING, CA 95039
(831) 775-1700 www.mbari.org
Copyright MBARI 2000

Title		FOCE Chassis Power Supply Board		Number		<Doc>	
Size	Engineer	Chad Kacy	Layout	<Layout Eng.>	Filename	<Filename>	Rev
	C	Date	Friday, March 04, 2011	Sheet	2	of	4