


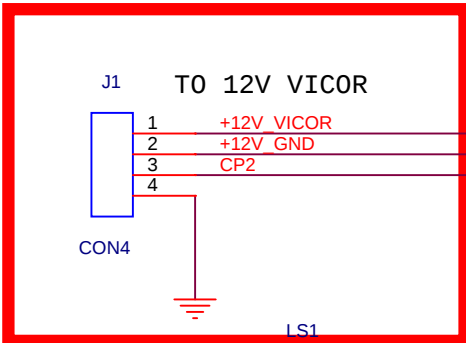
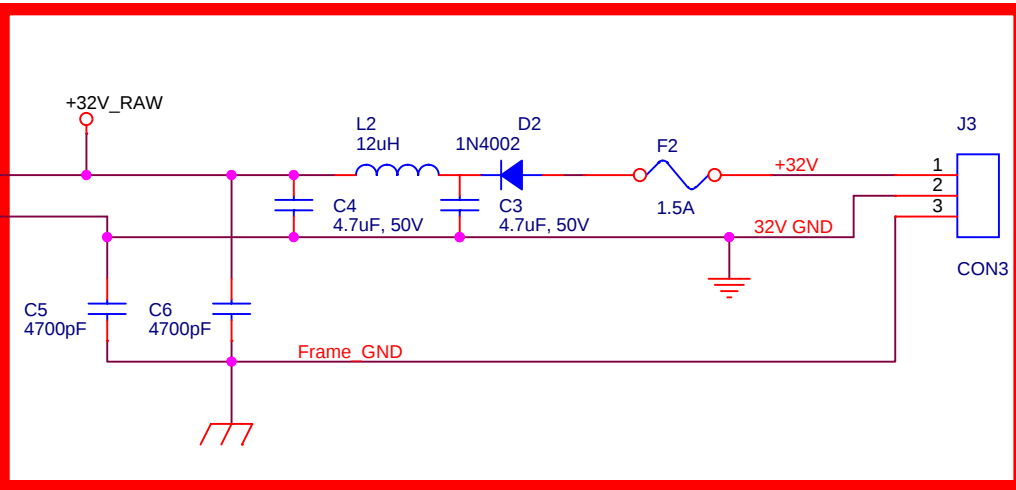
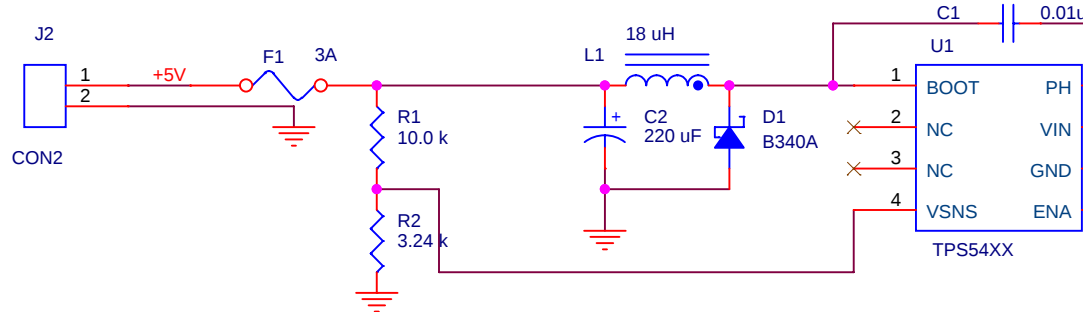


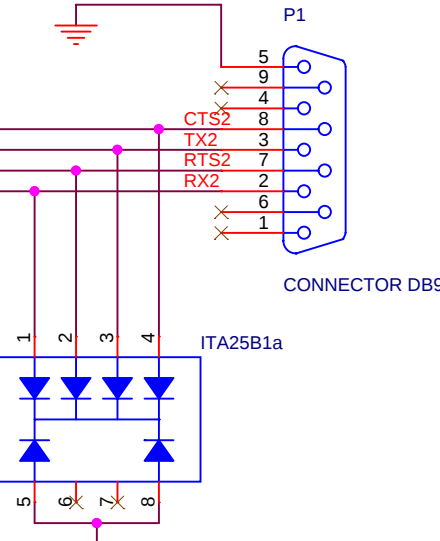




Removed 12V power supply and changed connector to attach to Vicor controller board.

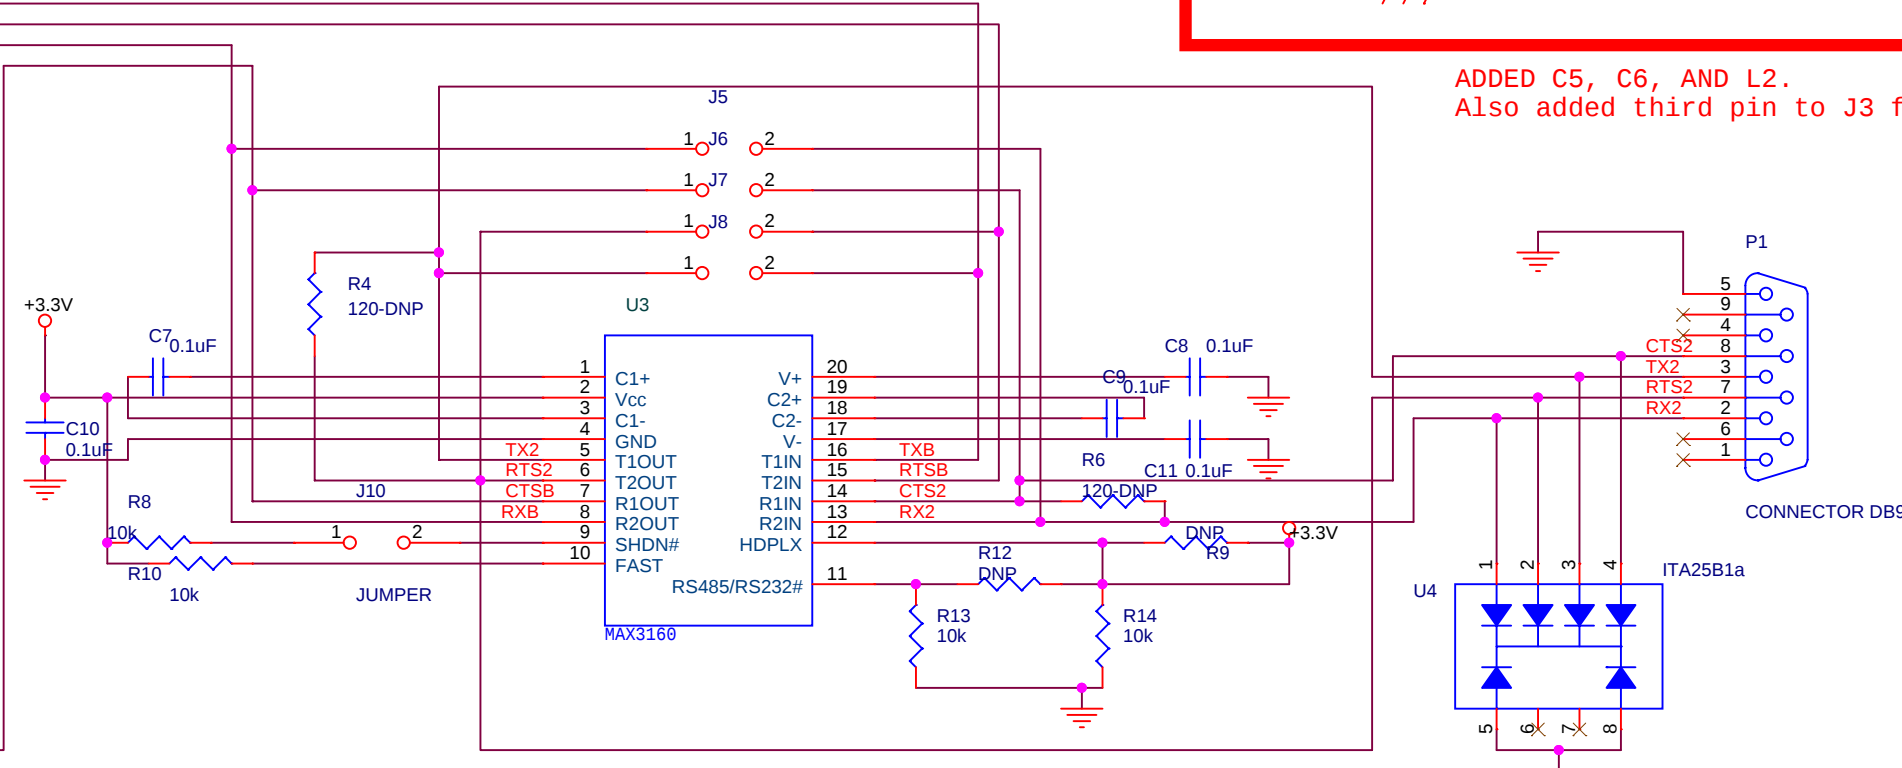





ADDED C5, C6, AND L2. Also added third pin to J3 for Frame GND

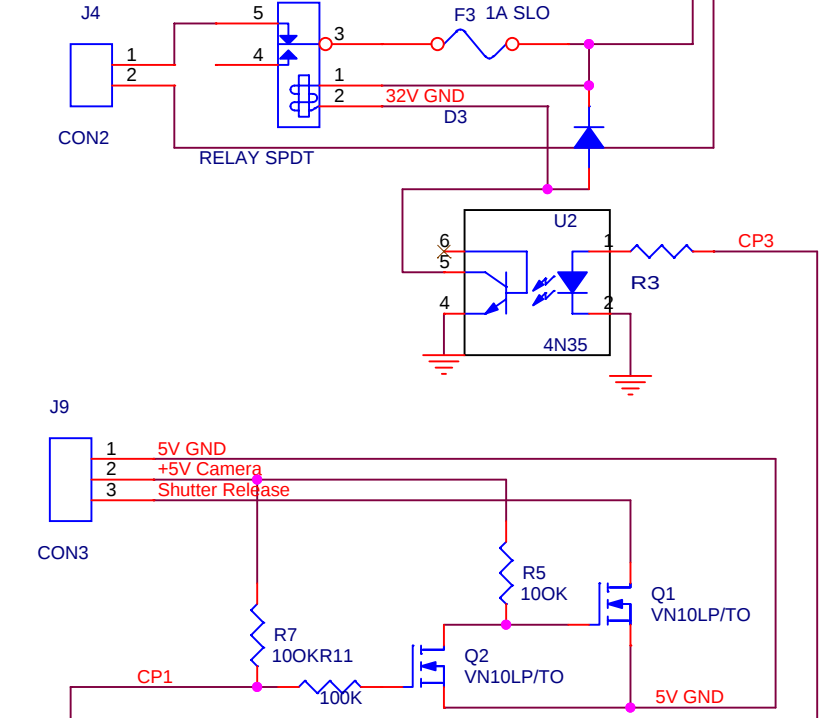

Humidy Sensor to XPort Digital In (Active High)

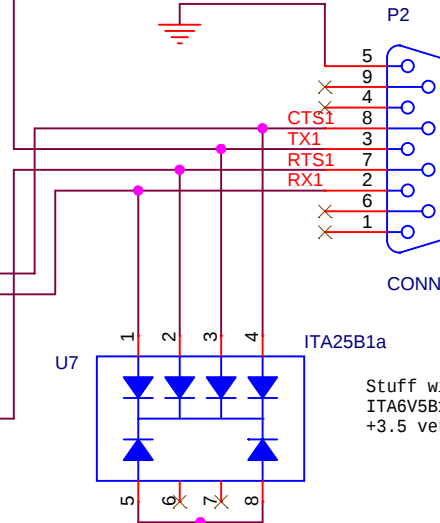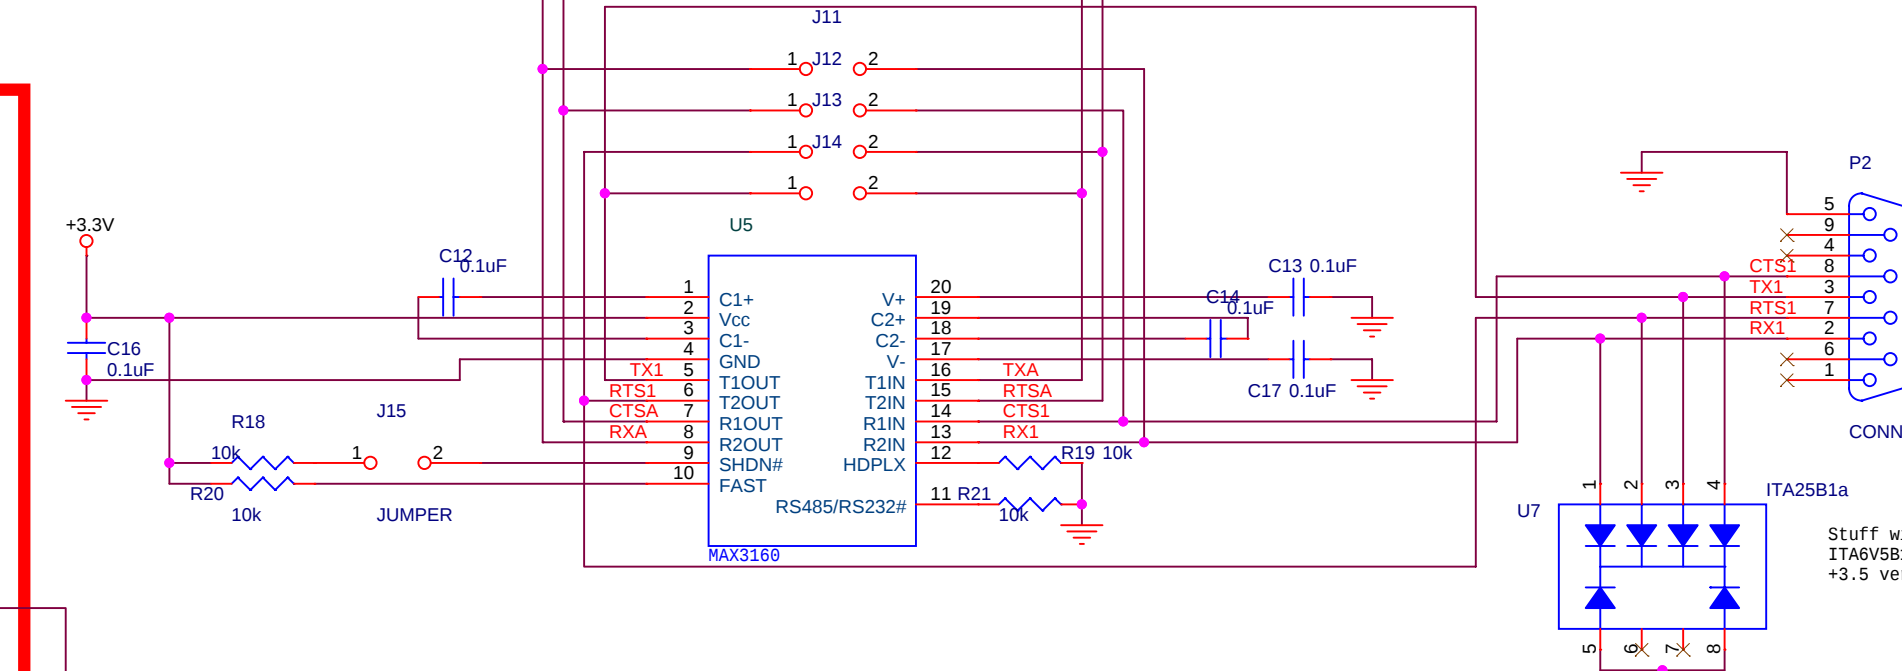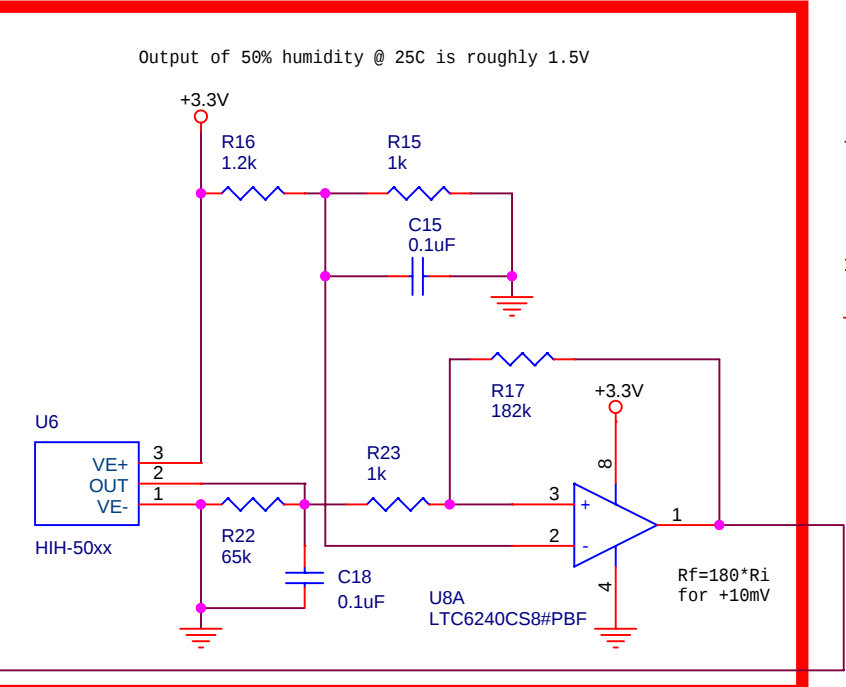

Output to Nikon Logic level

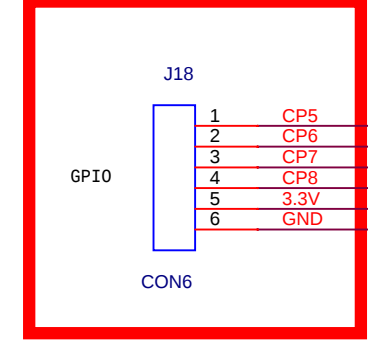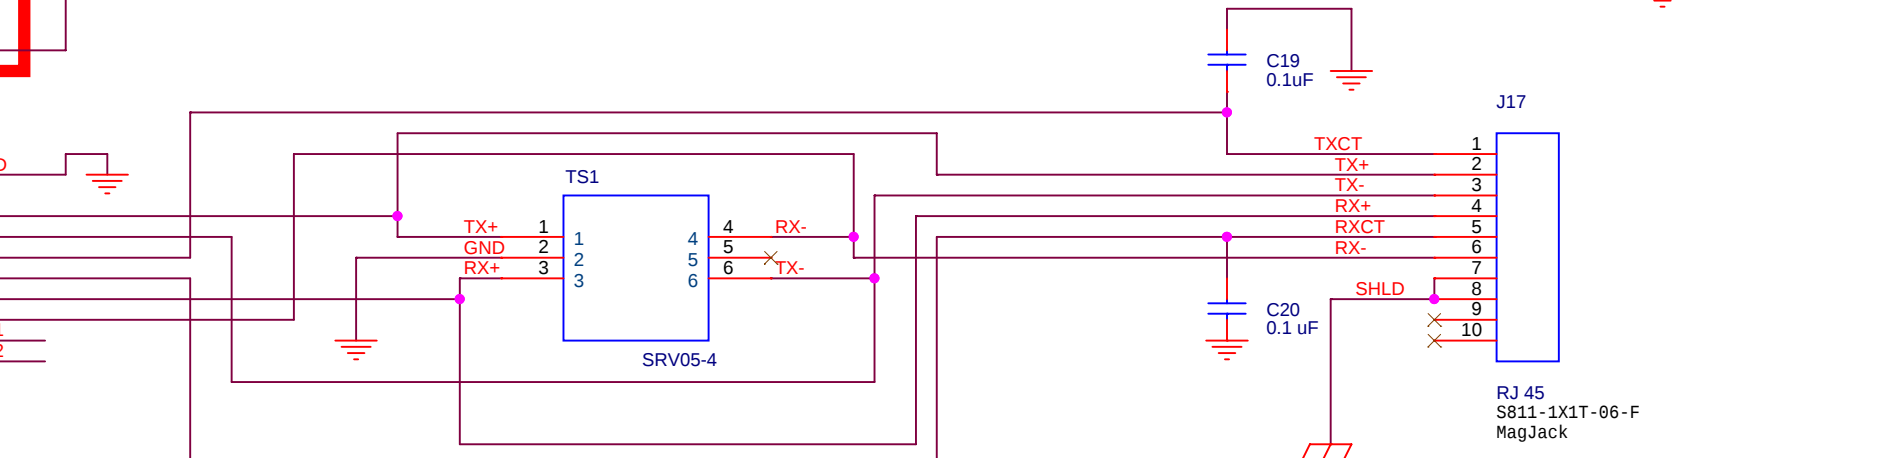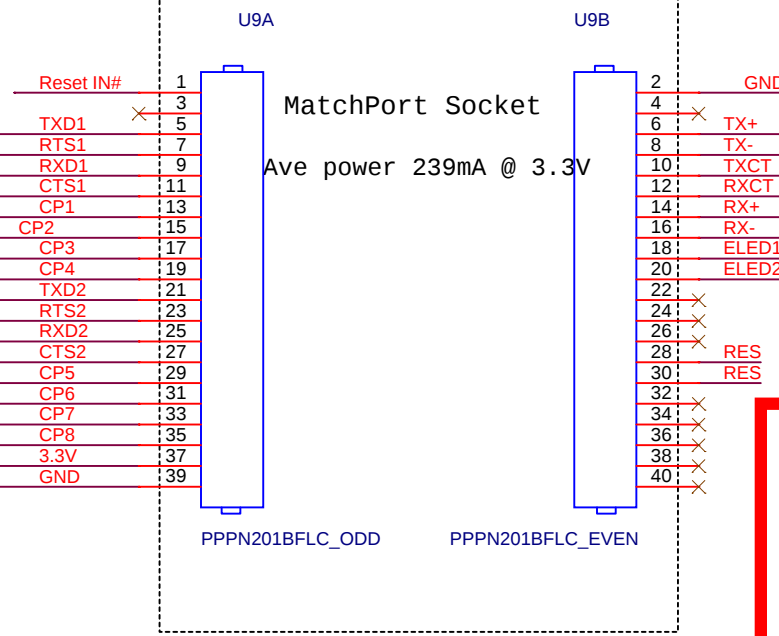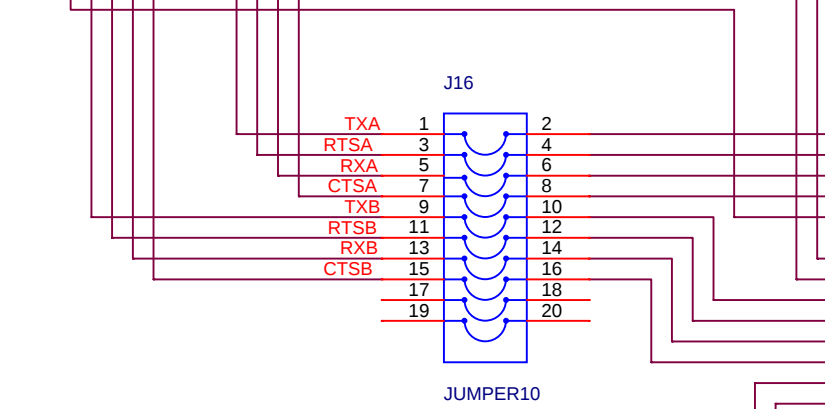

Changed connector size to 6 pins

