

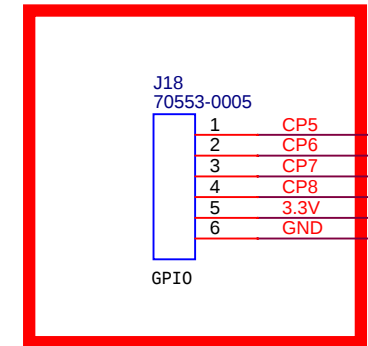
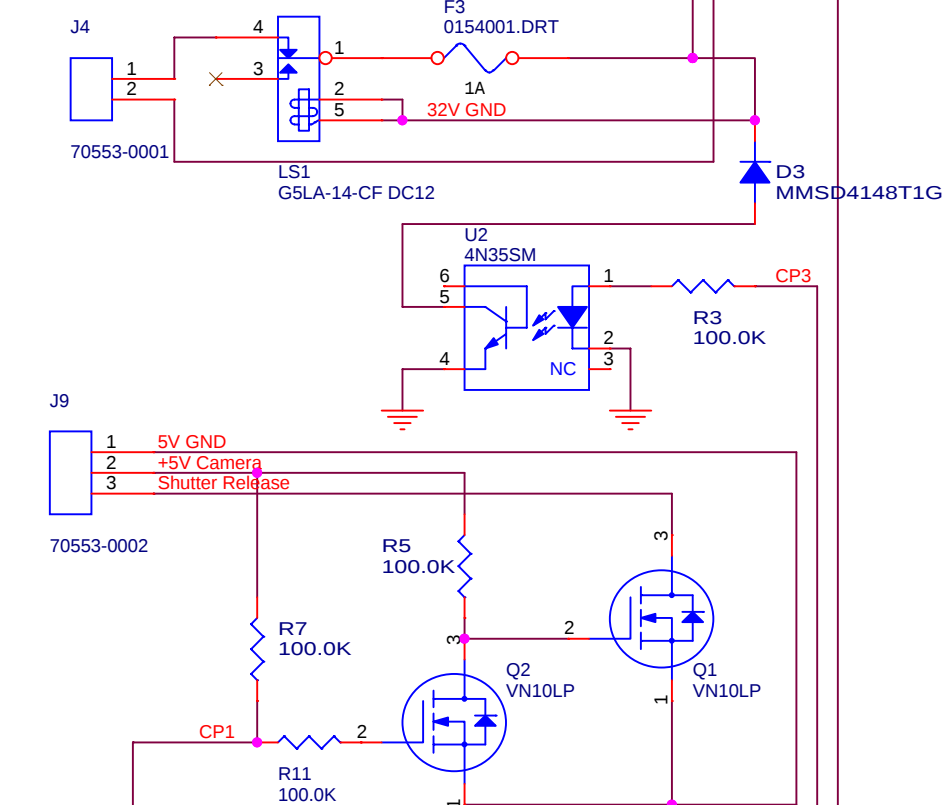


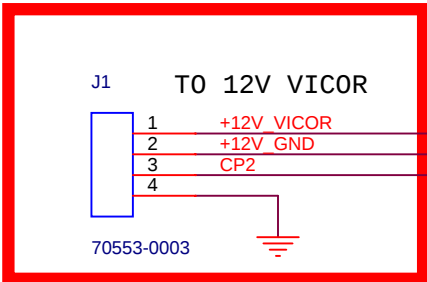


Changed connector size to 6 pins


Removed 12V power supply and changed connector to attach to Vicor controller board.

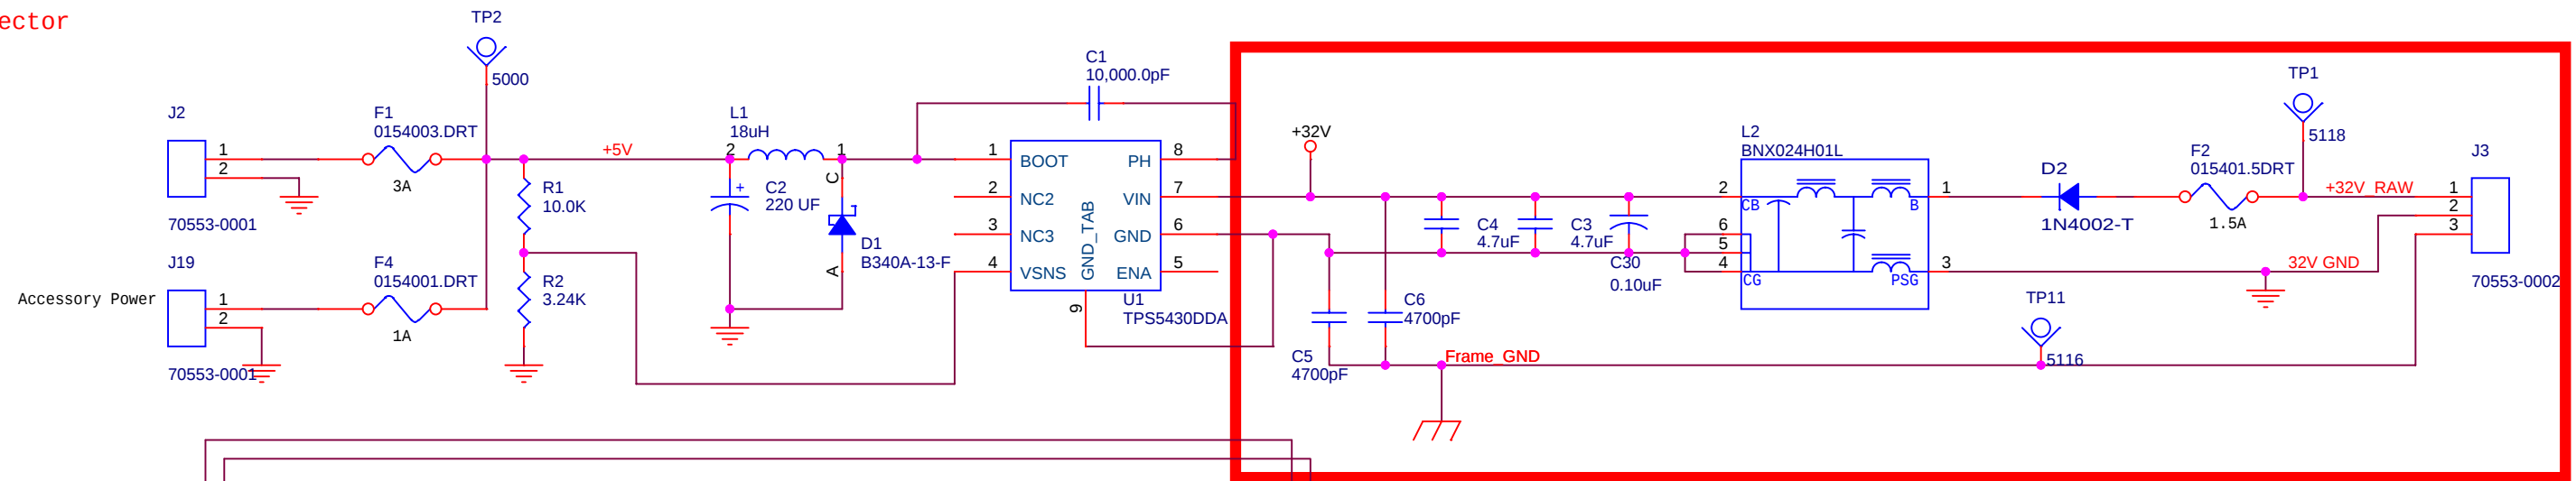


ADDED C5, C6, C30, and L2
Also added third pin to J3 for Frame GND

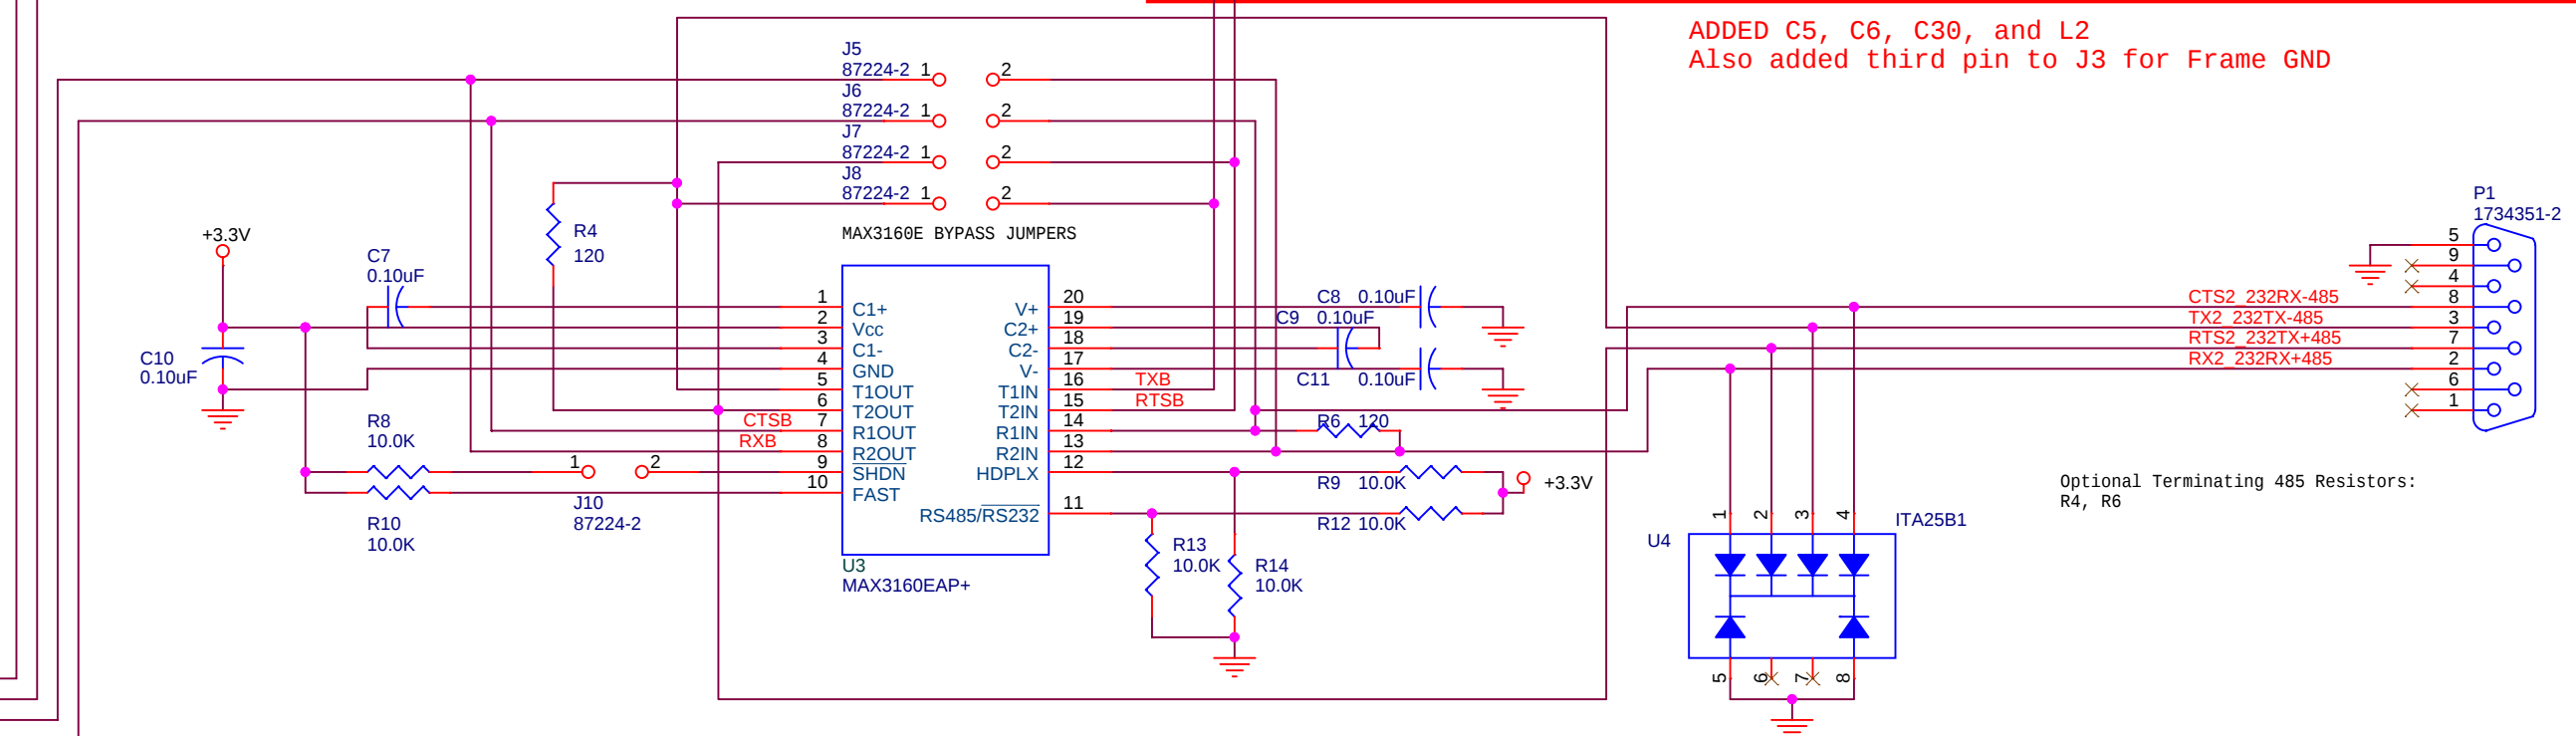

Humidy Sensor to XPort Digital In (Active High)

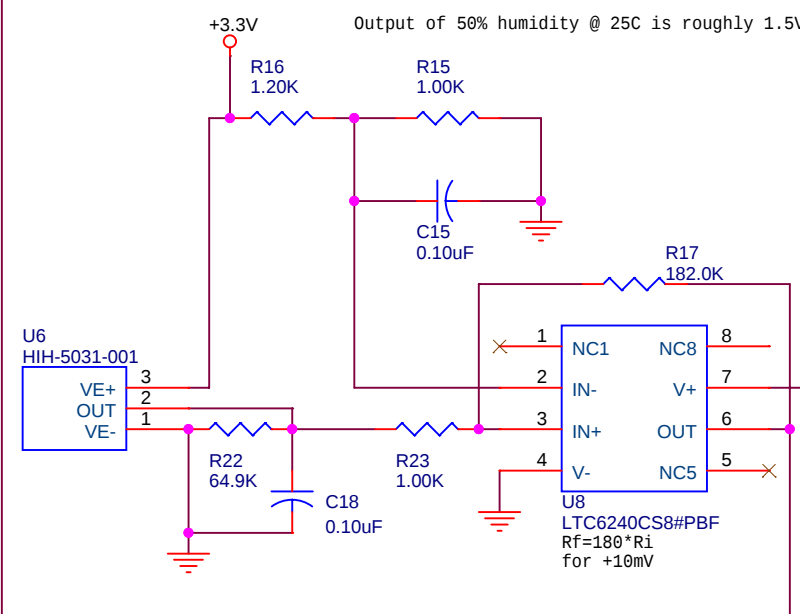




Output to Nikon
Logic level

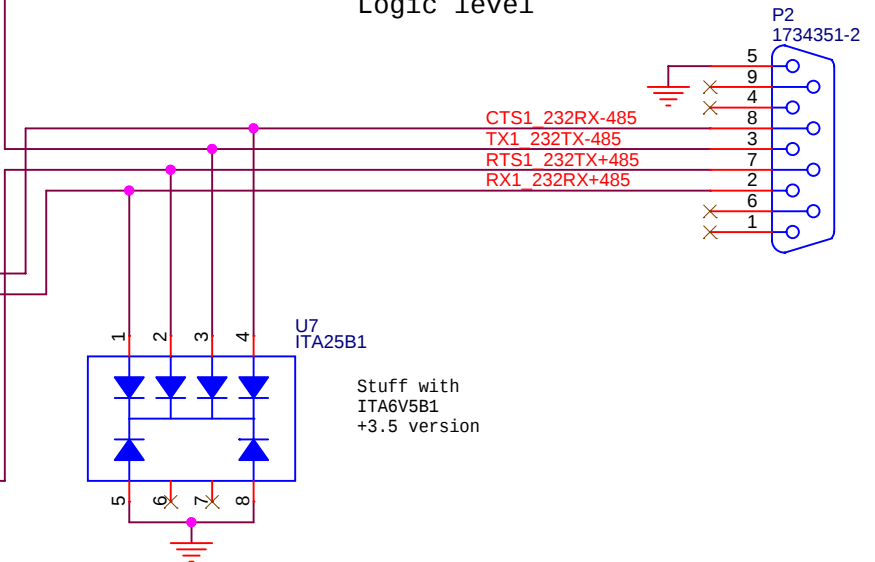

MOD1

MATCHPORT NR

MATCHPORT NR SOCKET

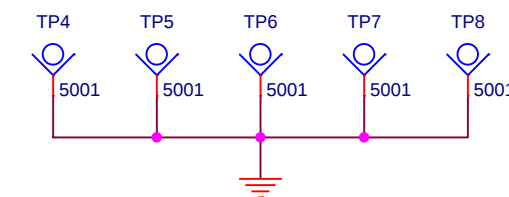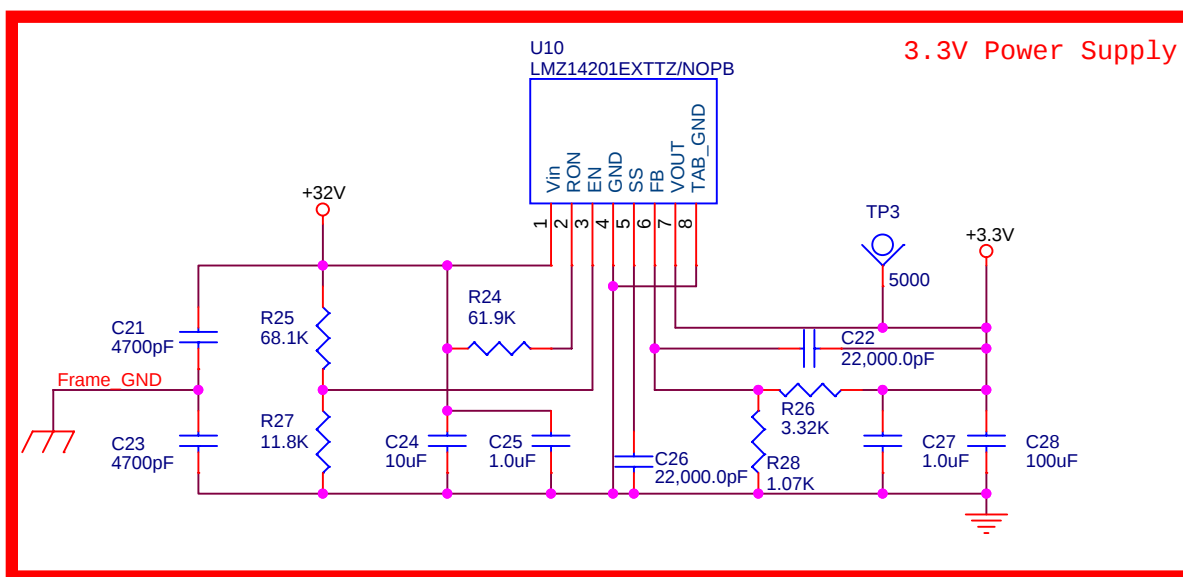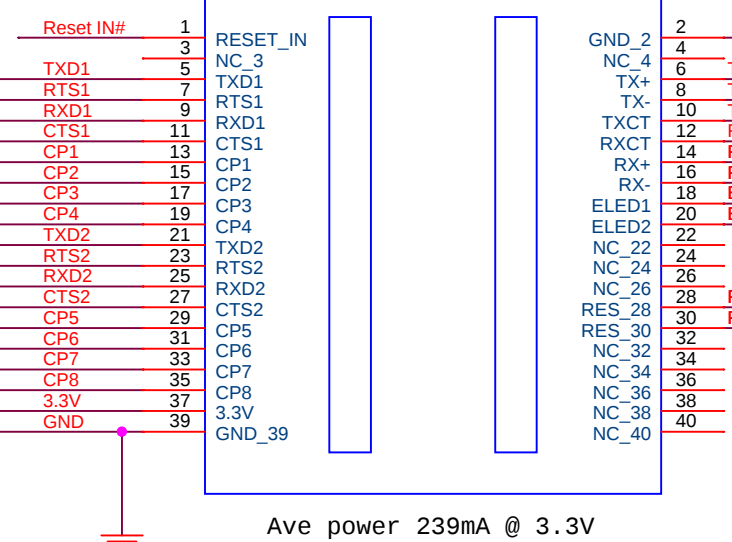

		Monterey Bay Aquarium Research Institute 7700 Sandhold Road, Moss Landing, CA 95039	
Engineer Alana Sherman		Title BIAUV Xport Power Board	
Layout Jose Rosal	Size C	Document Number 10020653	Rev A
Date: Thursday, February 10, 2011	Sheet 1	of 2	