

ADDED C5, C6, C30, and L2
Also added third pin to J3 for Frame GND

Optional Terminating 485 Resistors:
R4, R6





MAX3160E BYPASS JUMPERS

U3 MAX3160EAP+


U4 ITA25B1

P1 1734351-2

CTS2 232RX-485
TX2 232TX-485
RTS2 232TX+485
RX2 232RX+485

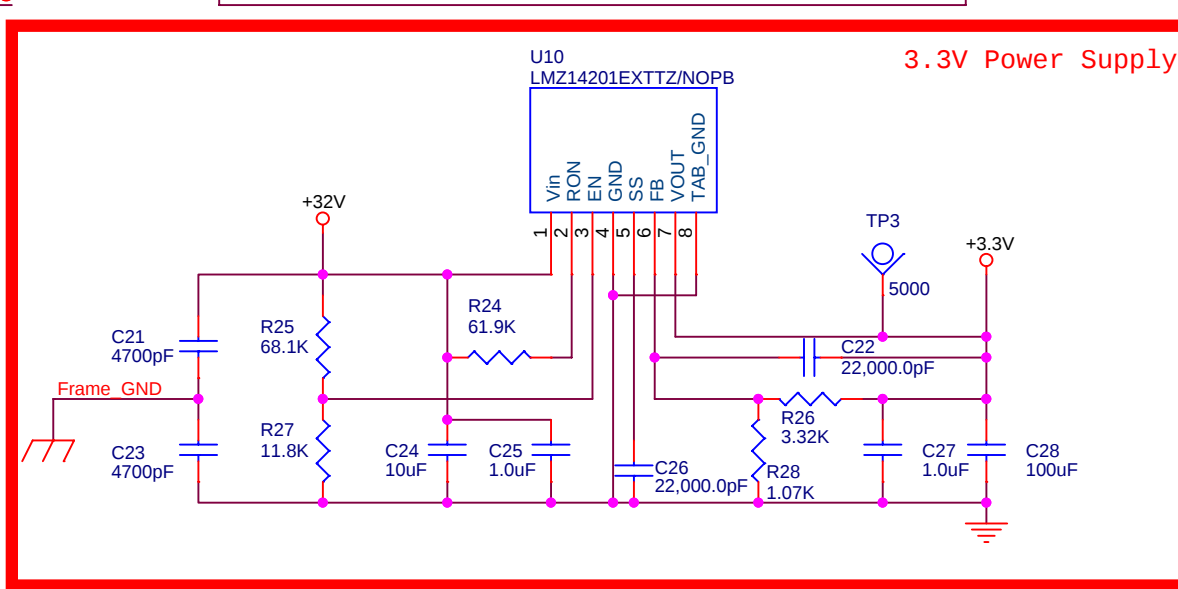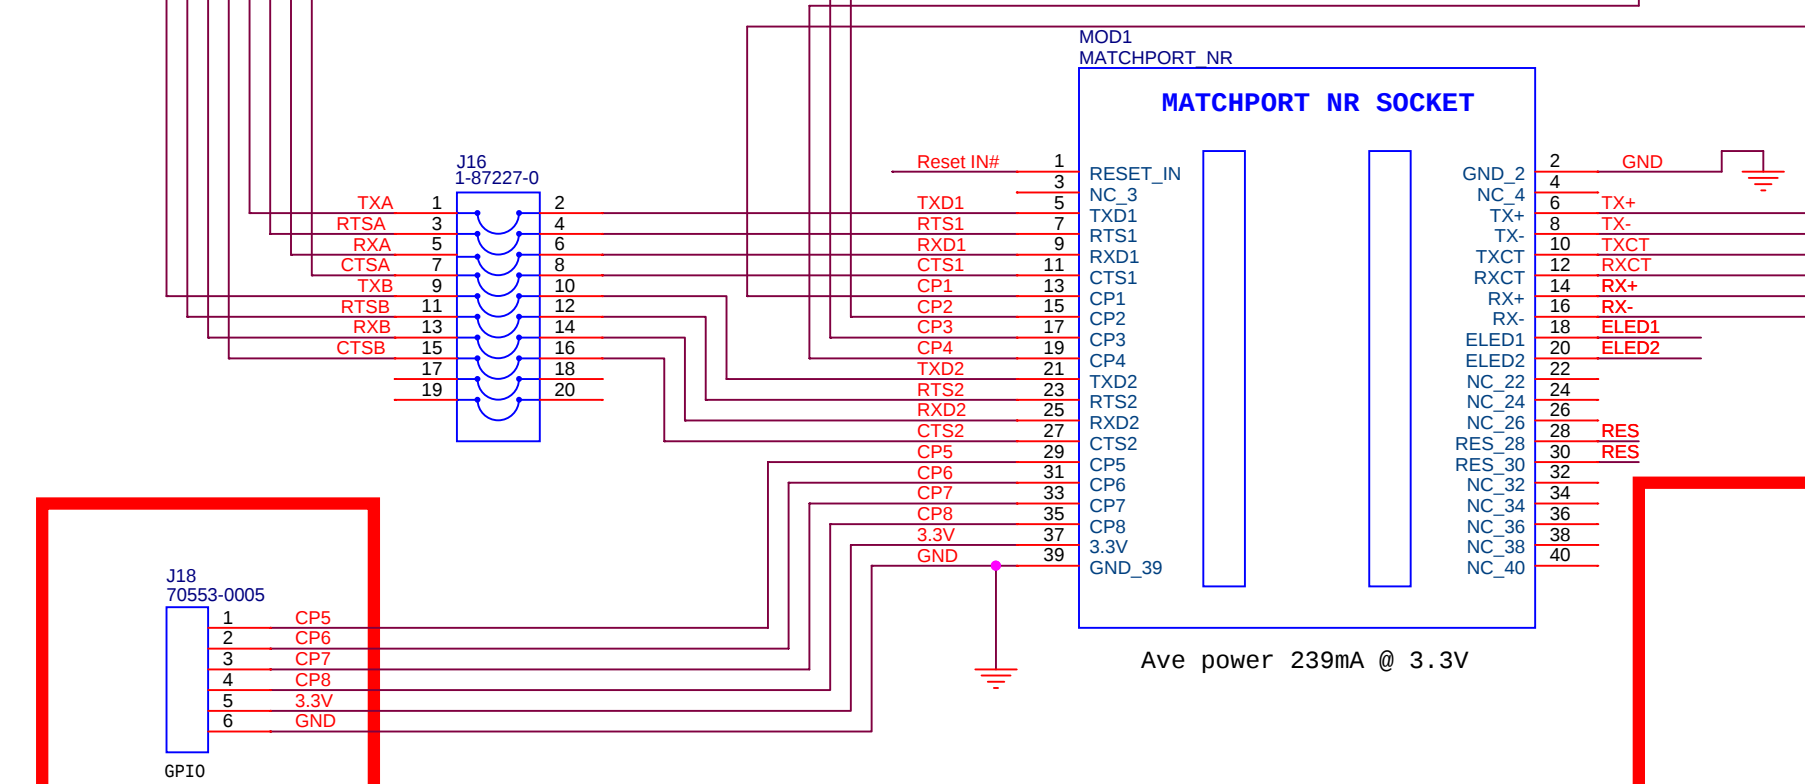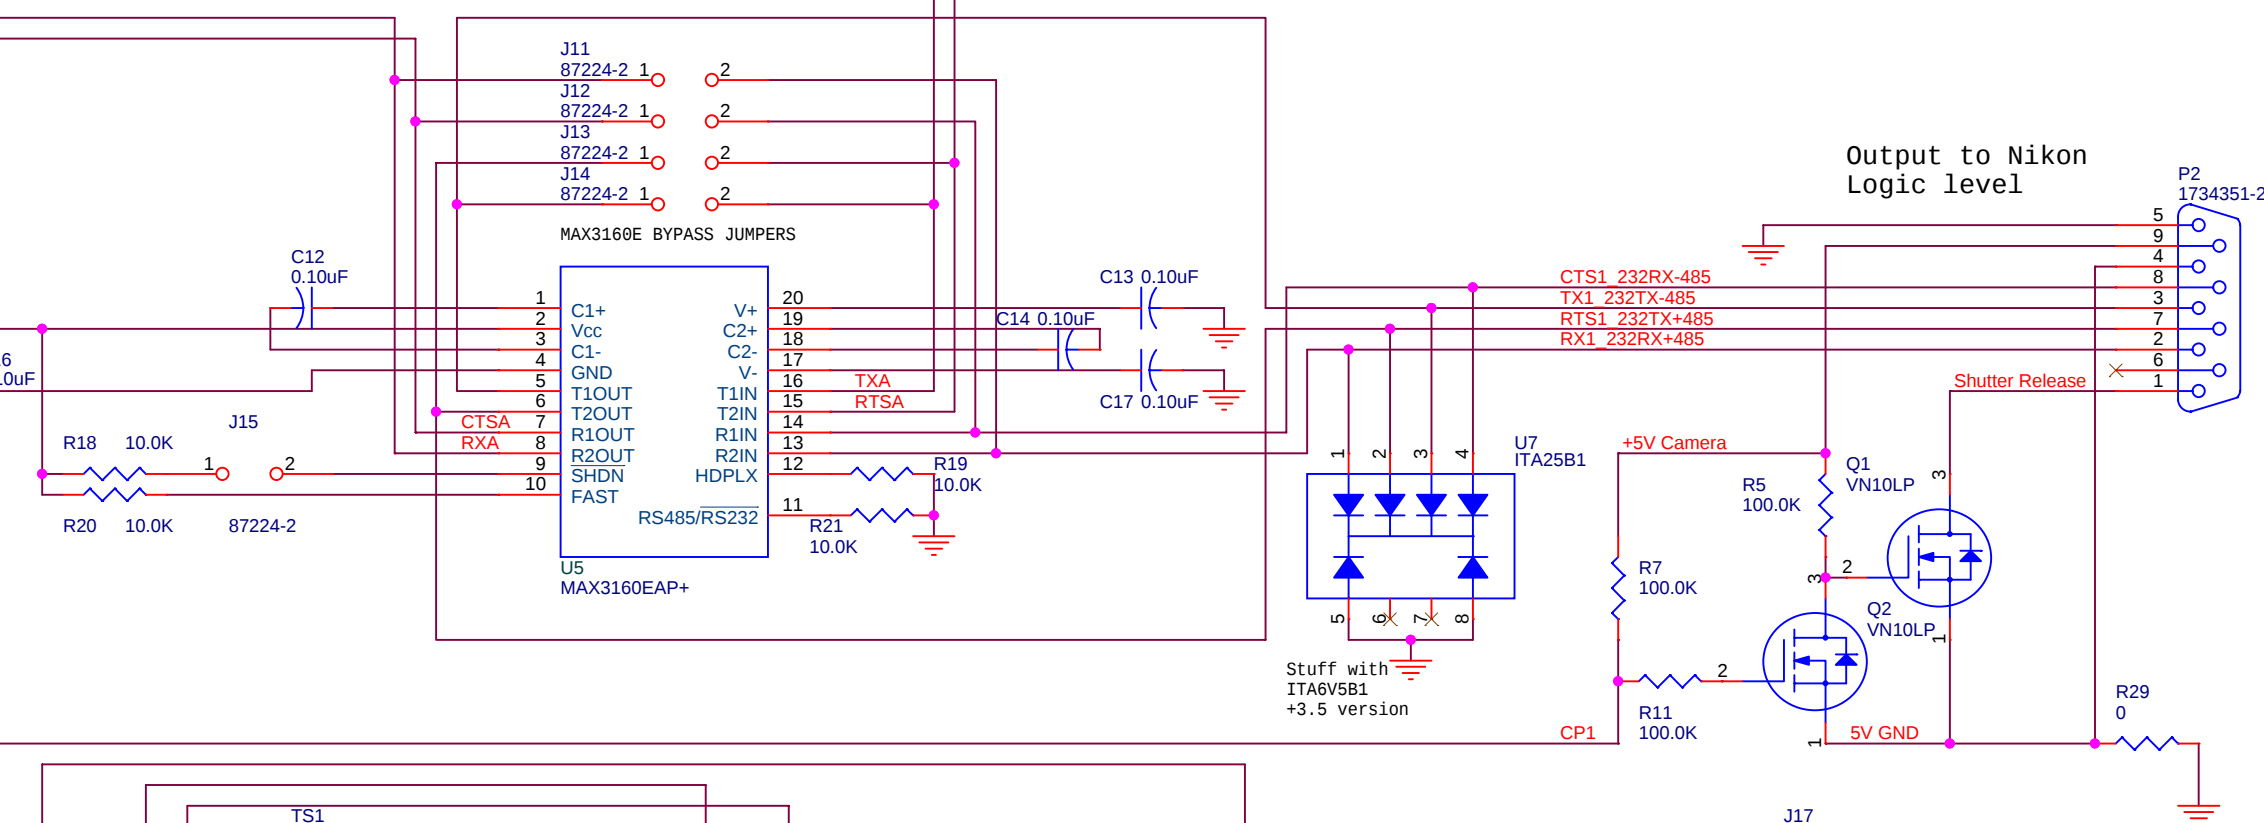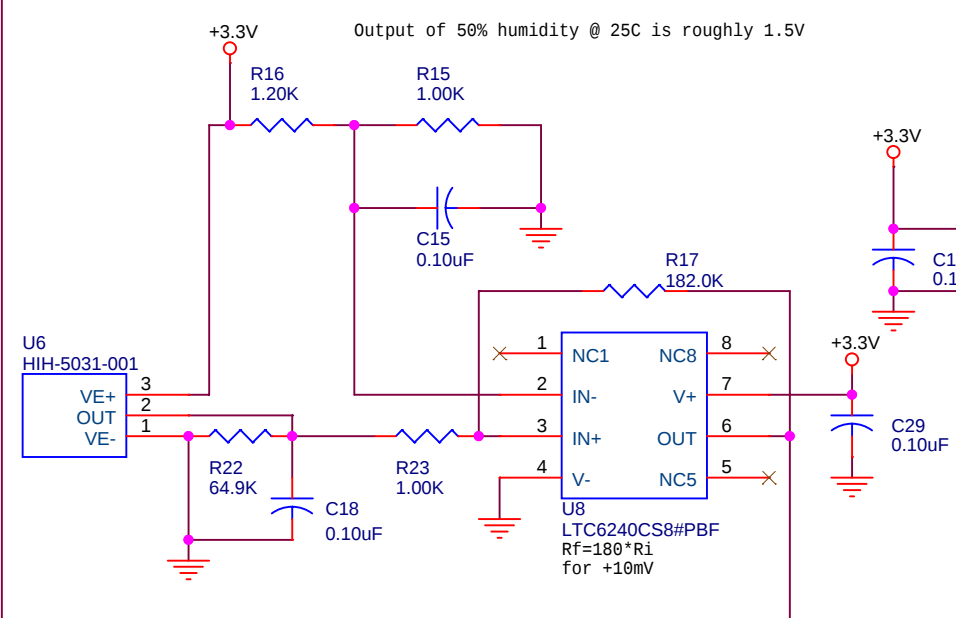

Changed connector size to 6 pins

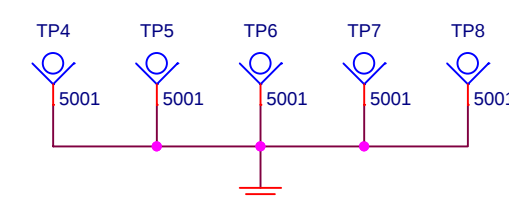

Engineer Alana Sherman	Size C	Document Number 10020653	Layout File <Layout File>	Rev A
Layout Jose Roal	Date:	Thursday, February 10, 2011	Sheet 1 of 2	