

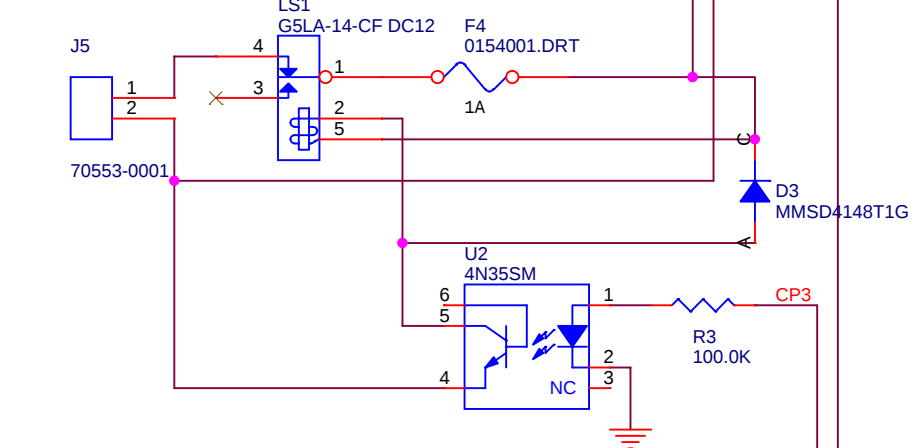
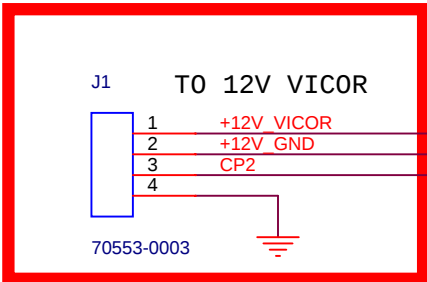
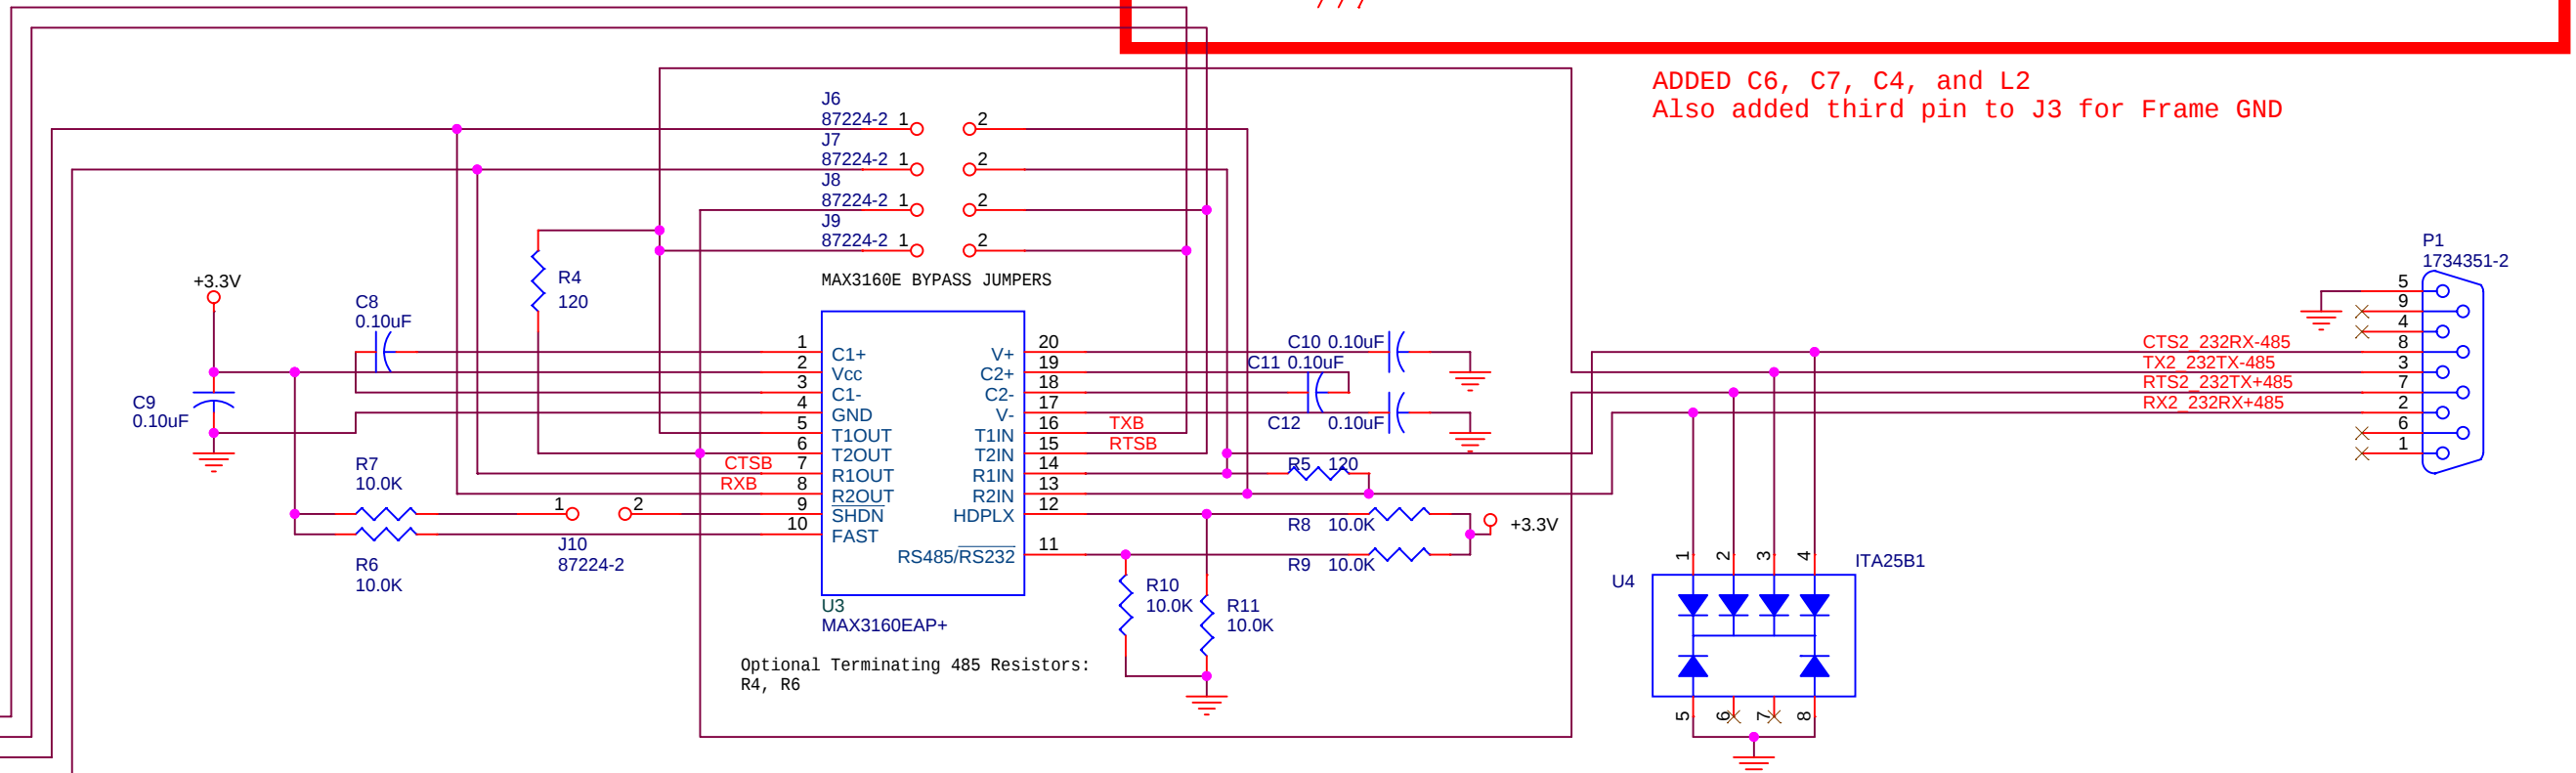
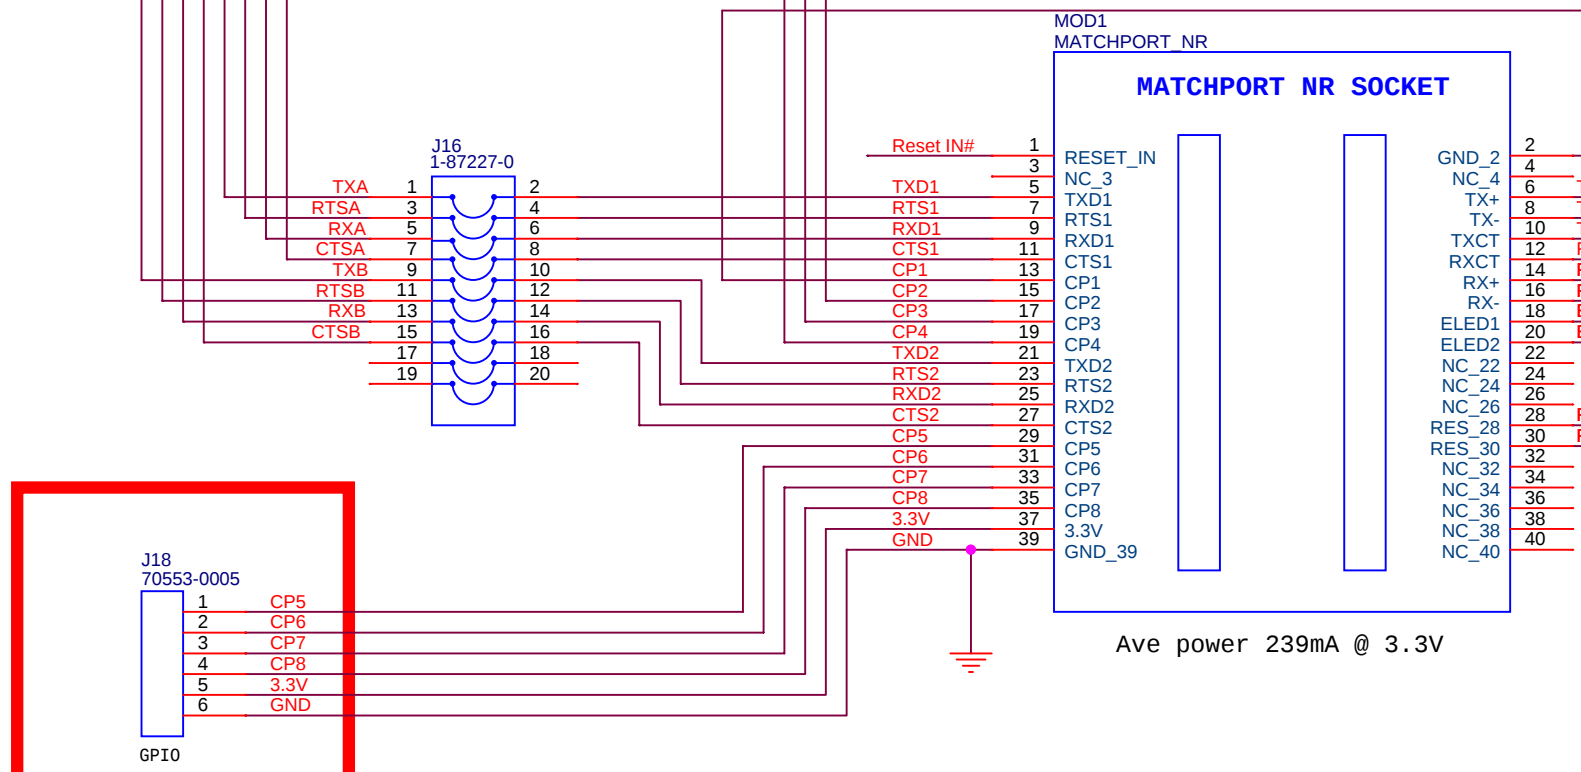




ADDED C6, C7, C4, and L2
Also added third pin to J3 for Frame GND

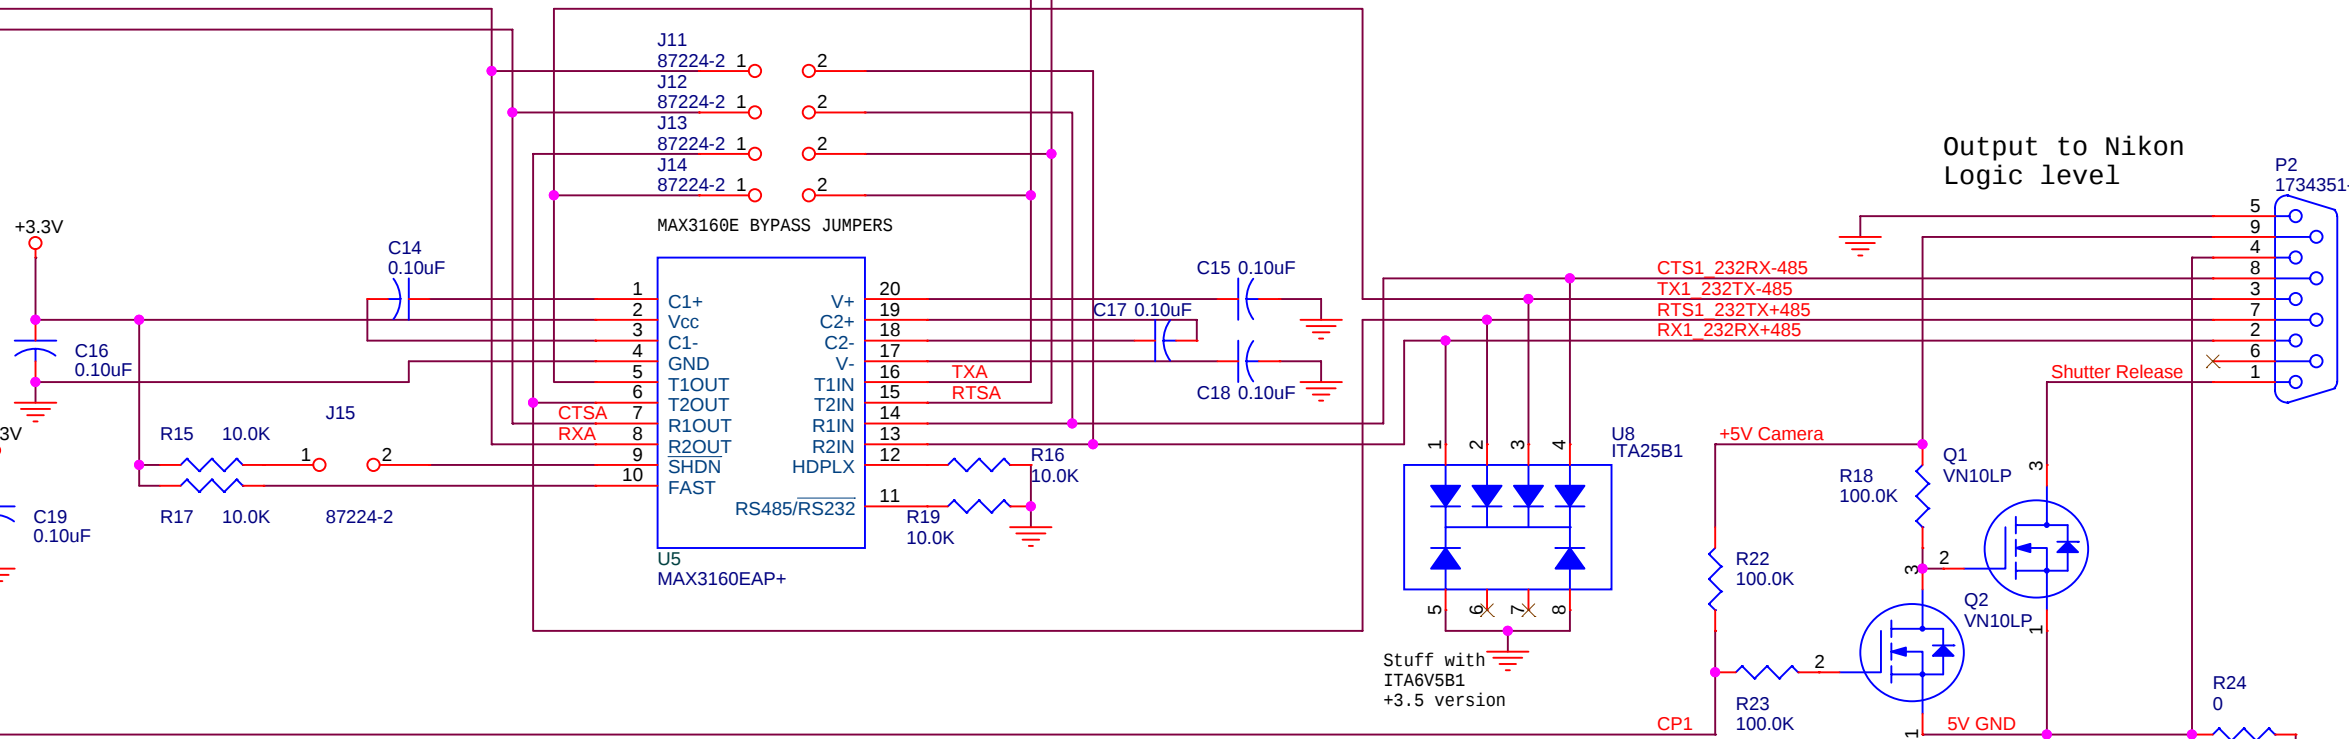

Humidy Sensor to XPort Digital In (Active High)

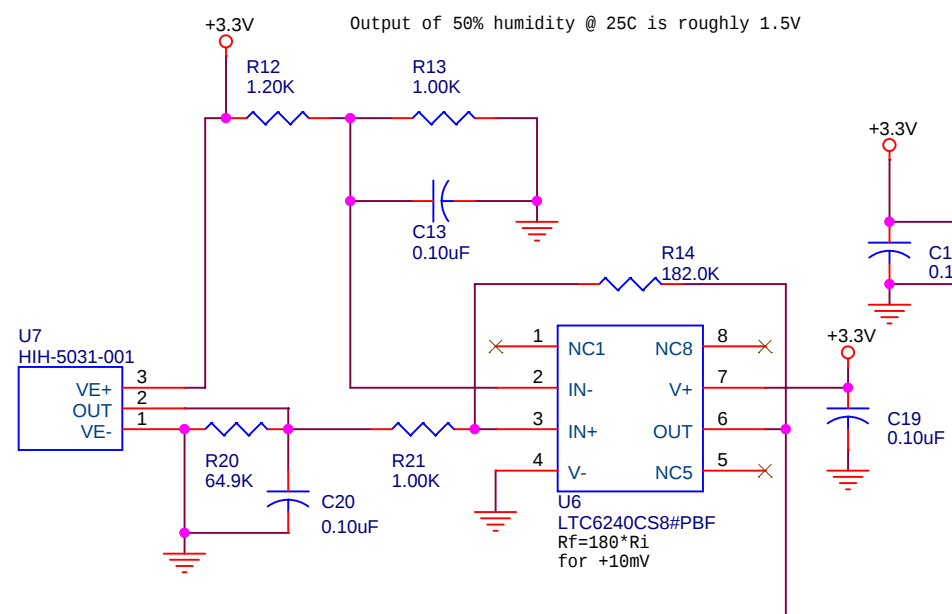

Changed connector size to 6 pins

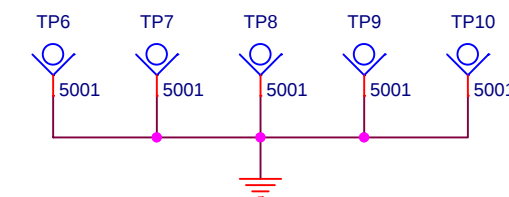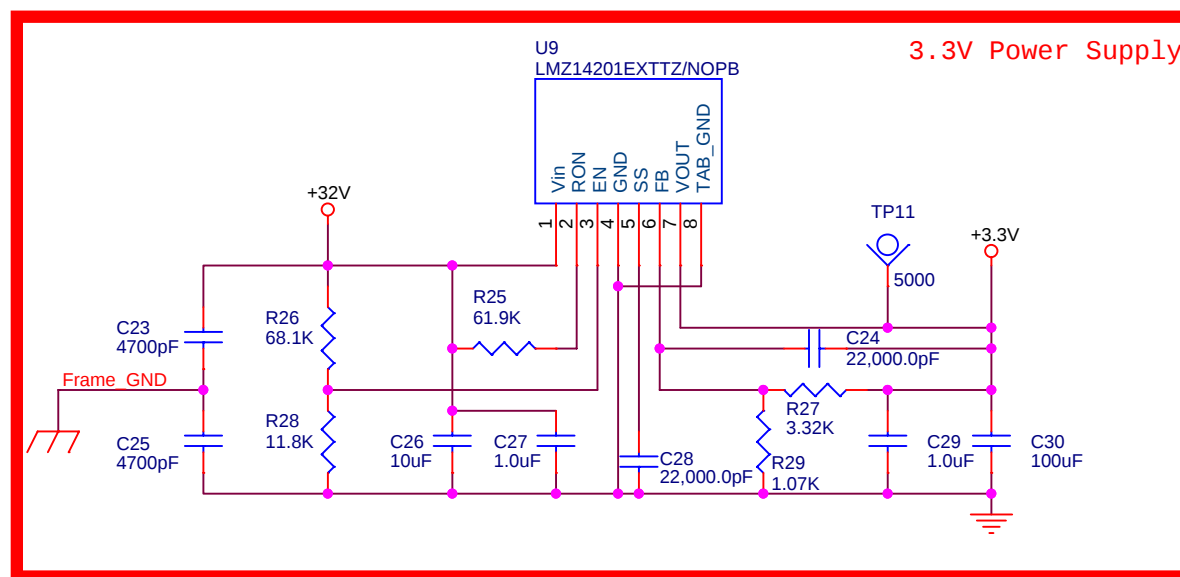

		Monterey Bay Aquarium Research Institute 7700 Sandhold Road, Moss Landing, CA 95039		
		Title BIAUV Xport Power Board		
		Layout File <Layout File>		Rev A
Engineer Alana Sherman	Size C	Document Number 10020653		
Layout Jose Rosal	Date: Monday, February 14, 2011	Sheet 1	of 1	