

HBF


Holewinski Blewens Fedelein & Lukes, Architects

350 Main Street,
San Francisco, California 94101
408/757-8001

Richard J. Fedelein
Thomas R. Lukes
C22891
C28922

Consultants:

RUTHERFORD AND CHEKENE
CONSULTING ENGINEERS
303 SECOND STREET, SAN FRANCISCO, CA 94107 (415) 485-4222

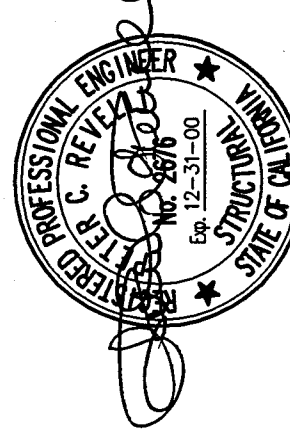

Agency Approvals:

Revisions	Description	Date
No. Add	ADDENDUM ITEM	12/30/99
Δ	REVISION	2/18/00

M B A R I

**EXPANSION
TO BUILDING B
MOSS LANDING FACILITIES
SANDHOLDT ROAD
MOSS LANDING, CA. 95039**

CONCRETE DETAILS

1997
CODES

Drawn by:

Checked:

Approved:

Project No.

Drawing No.

Date

11-11-99

S3.3

0' 1' 2' 


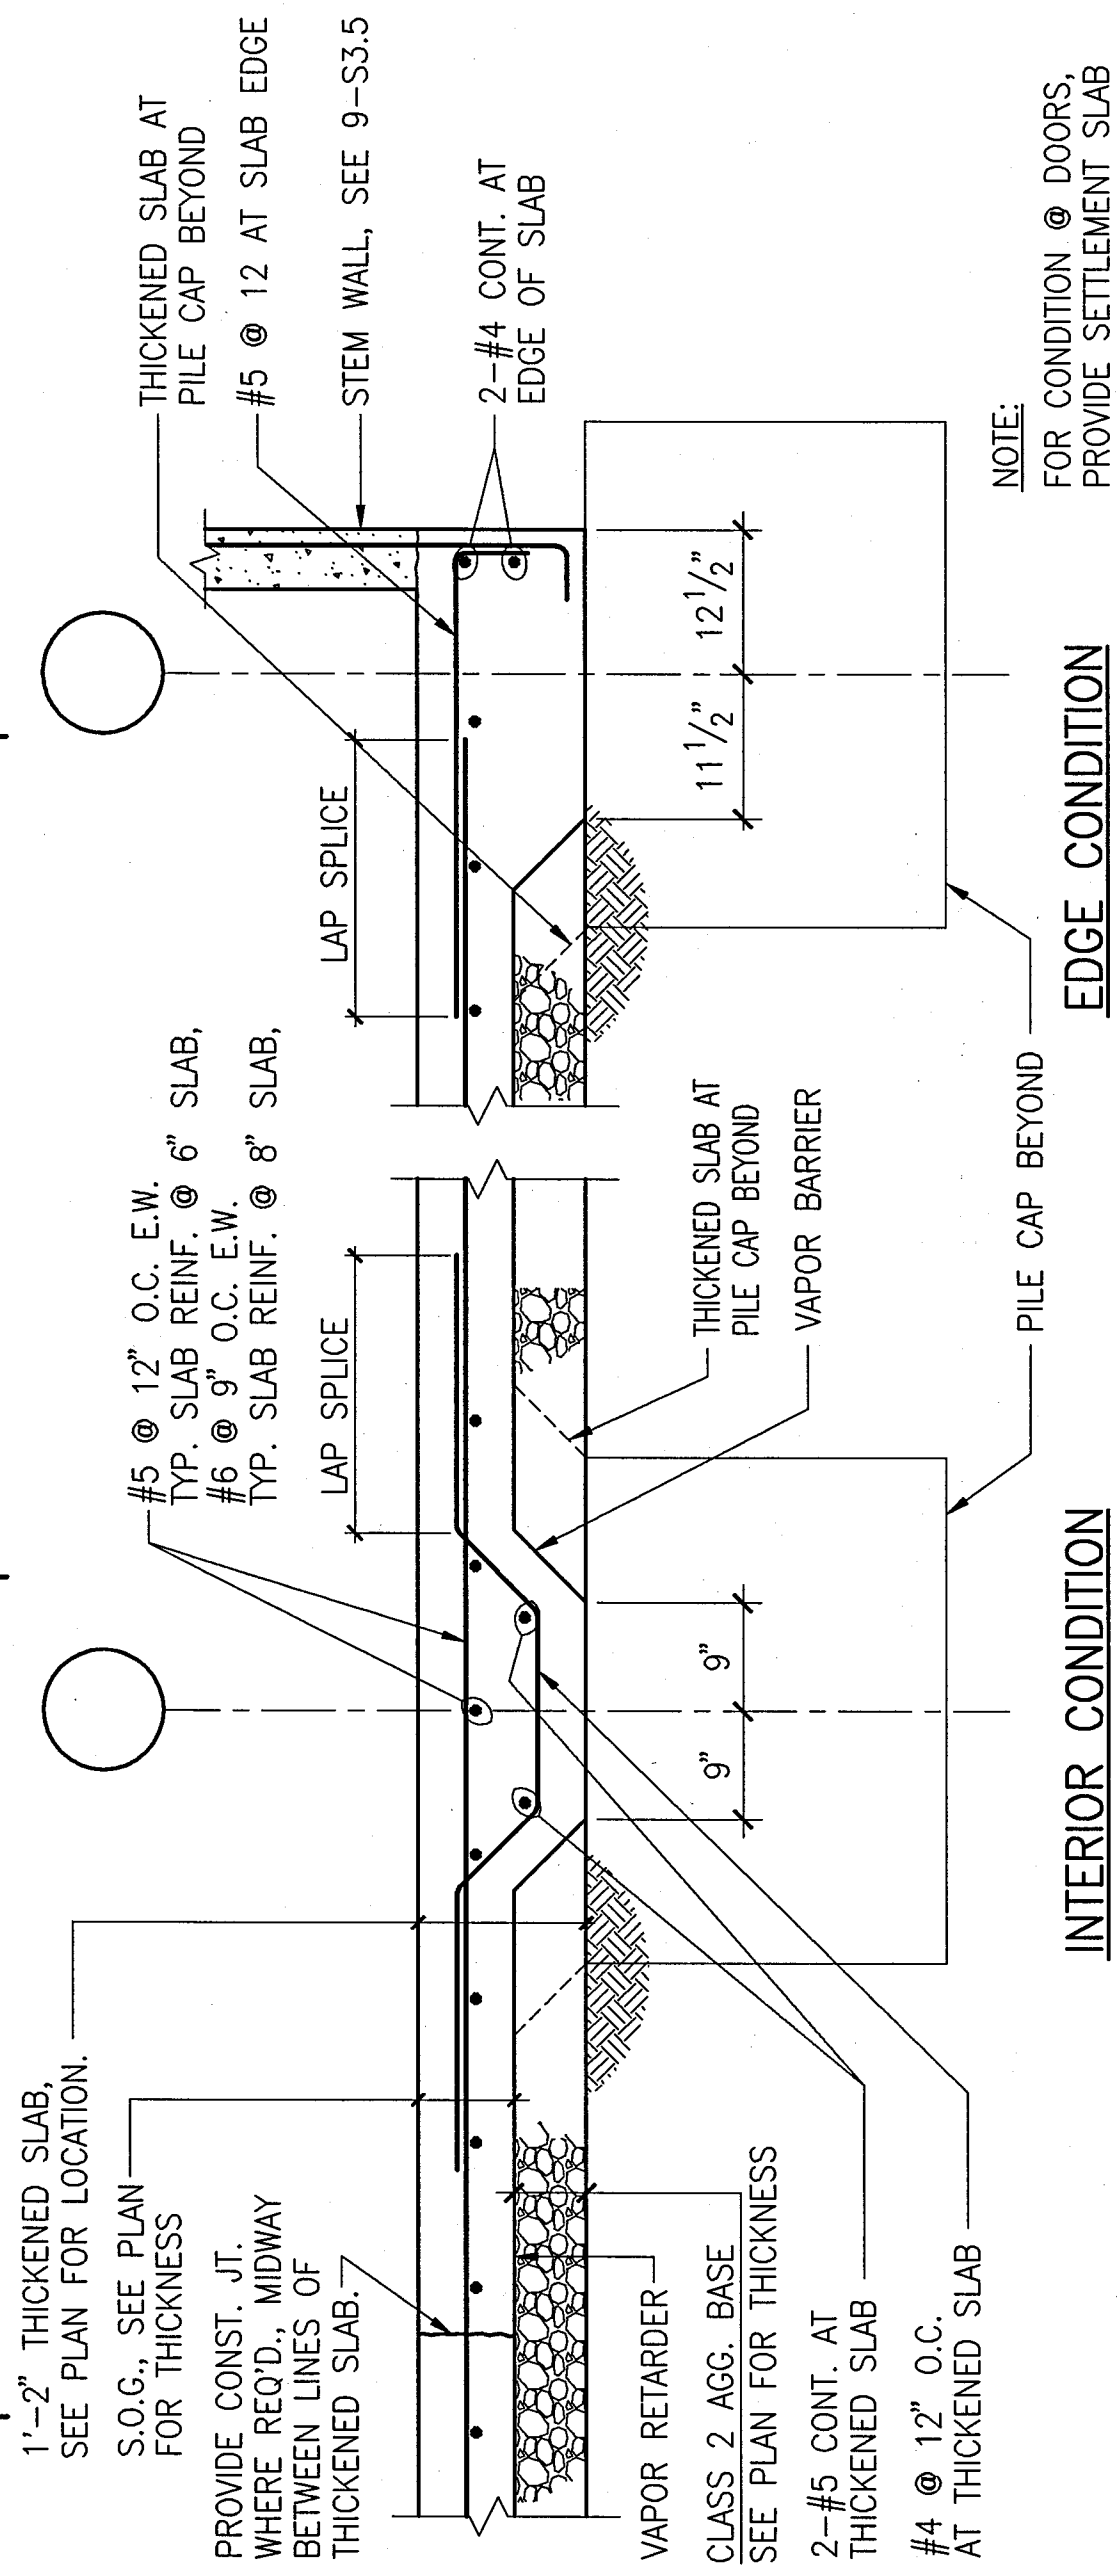

4


TYPICAL SLAB ON GRADE
3/4" = 1'-0"

NOTE:
FOR CONDITION @ DOORS,
PROVIDE SETTLEMENT SLAB
PER SHT. S2.2.

INTERIOR CONDITION


EDGE CONDITION

3/4" = 1'-0"

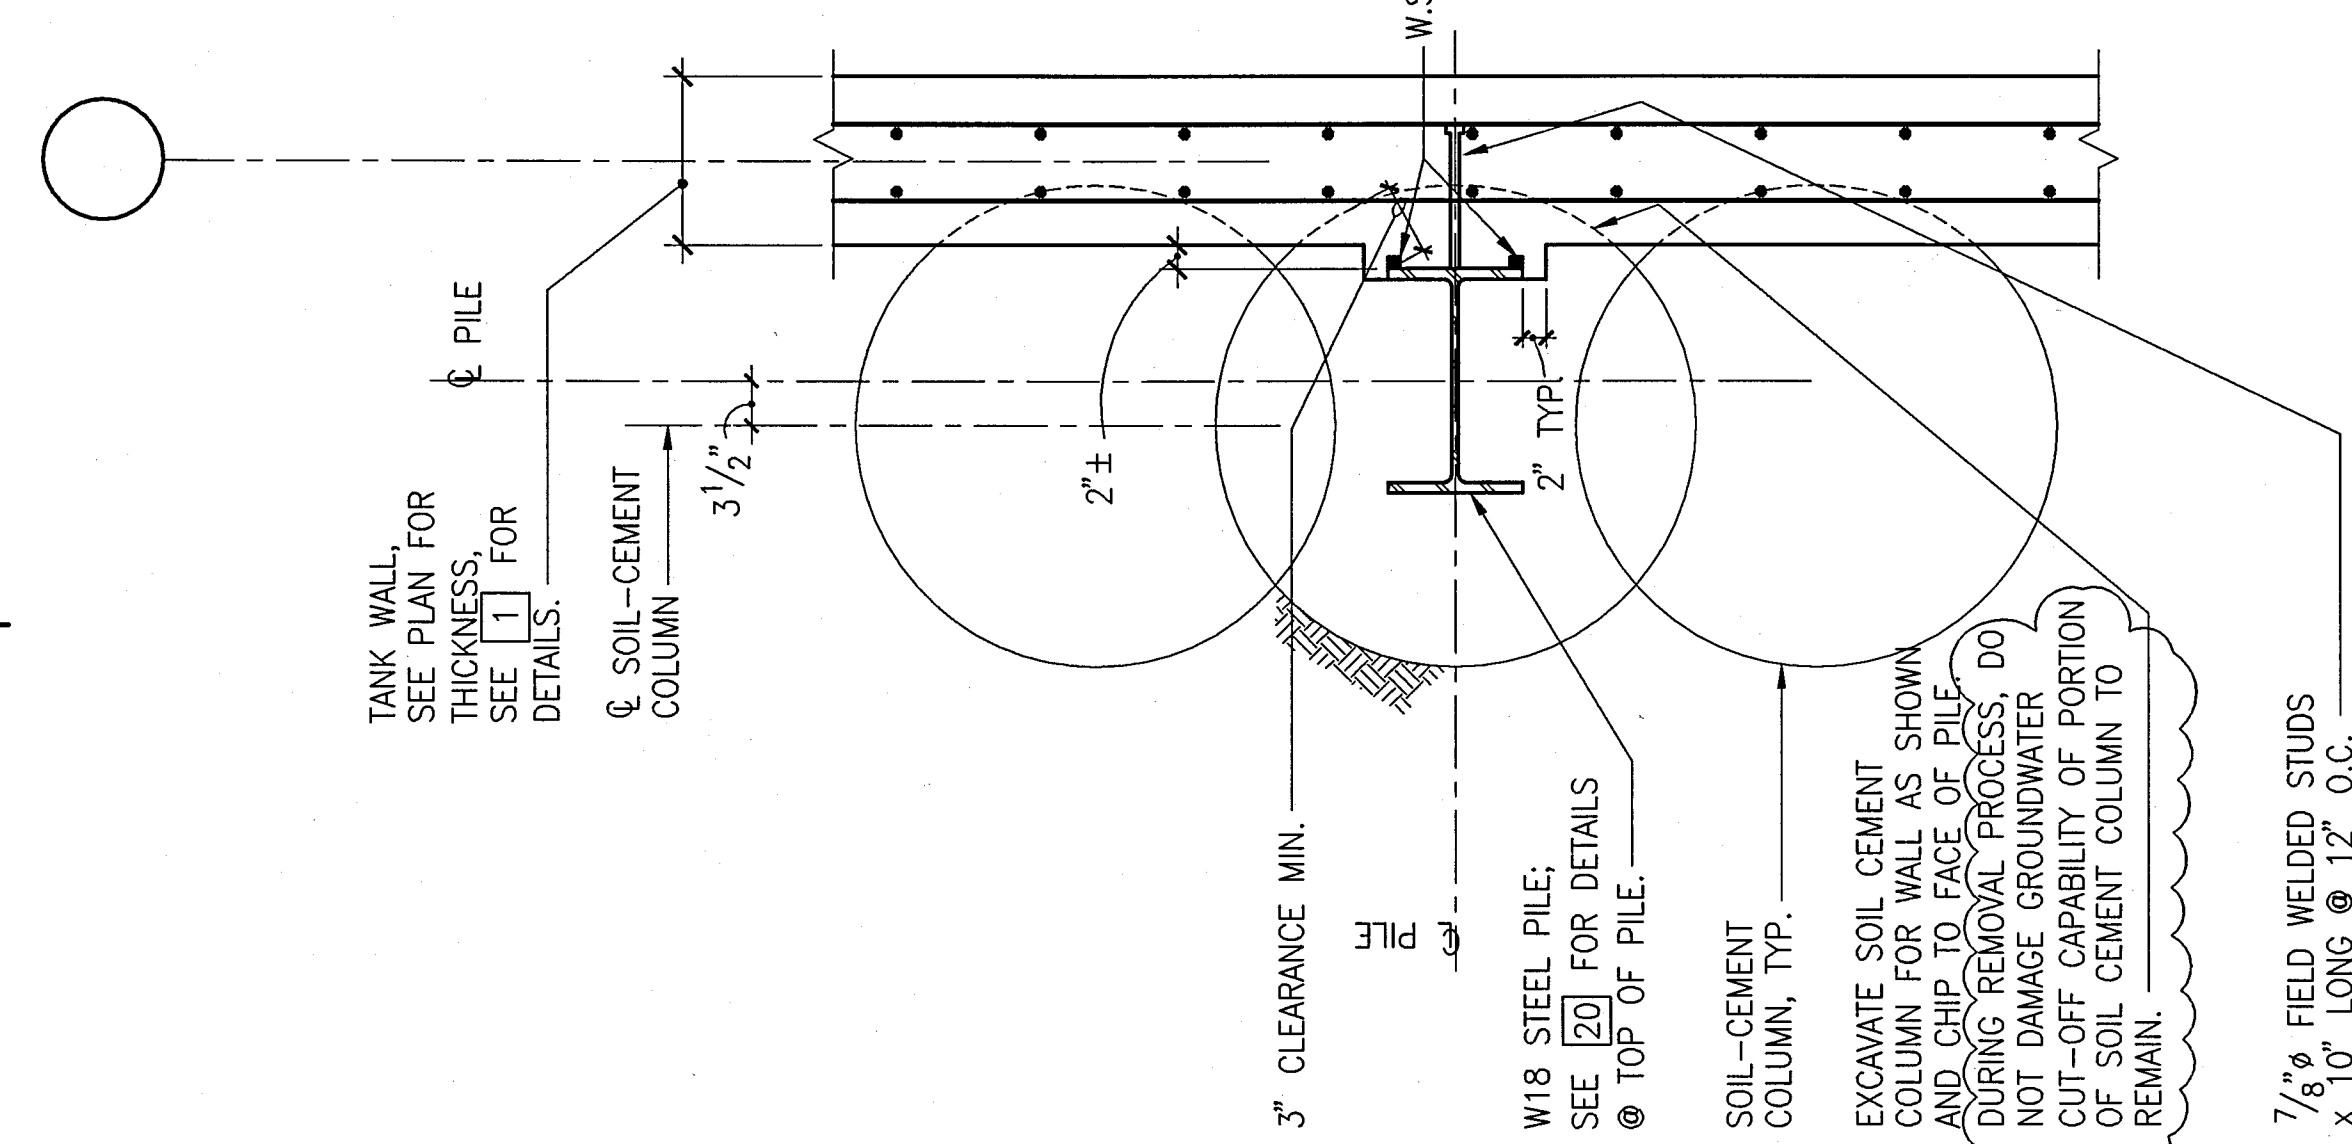


11

PLAN AT TANK PILE
3/4" = 1'-0"

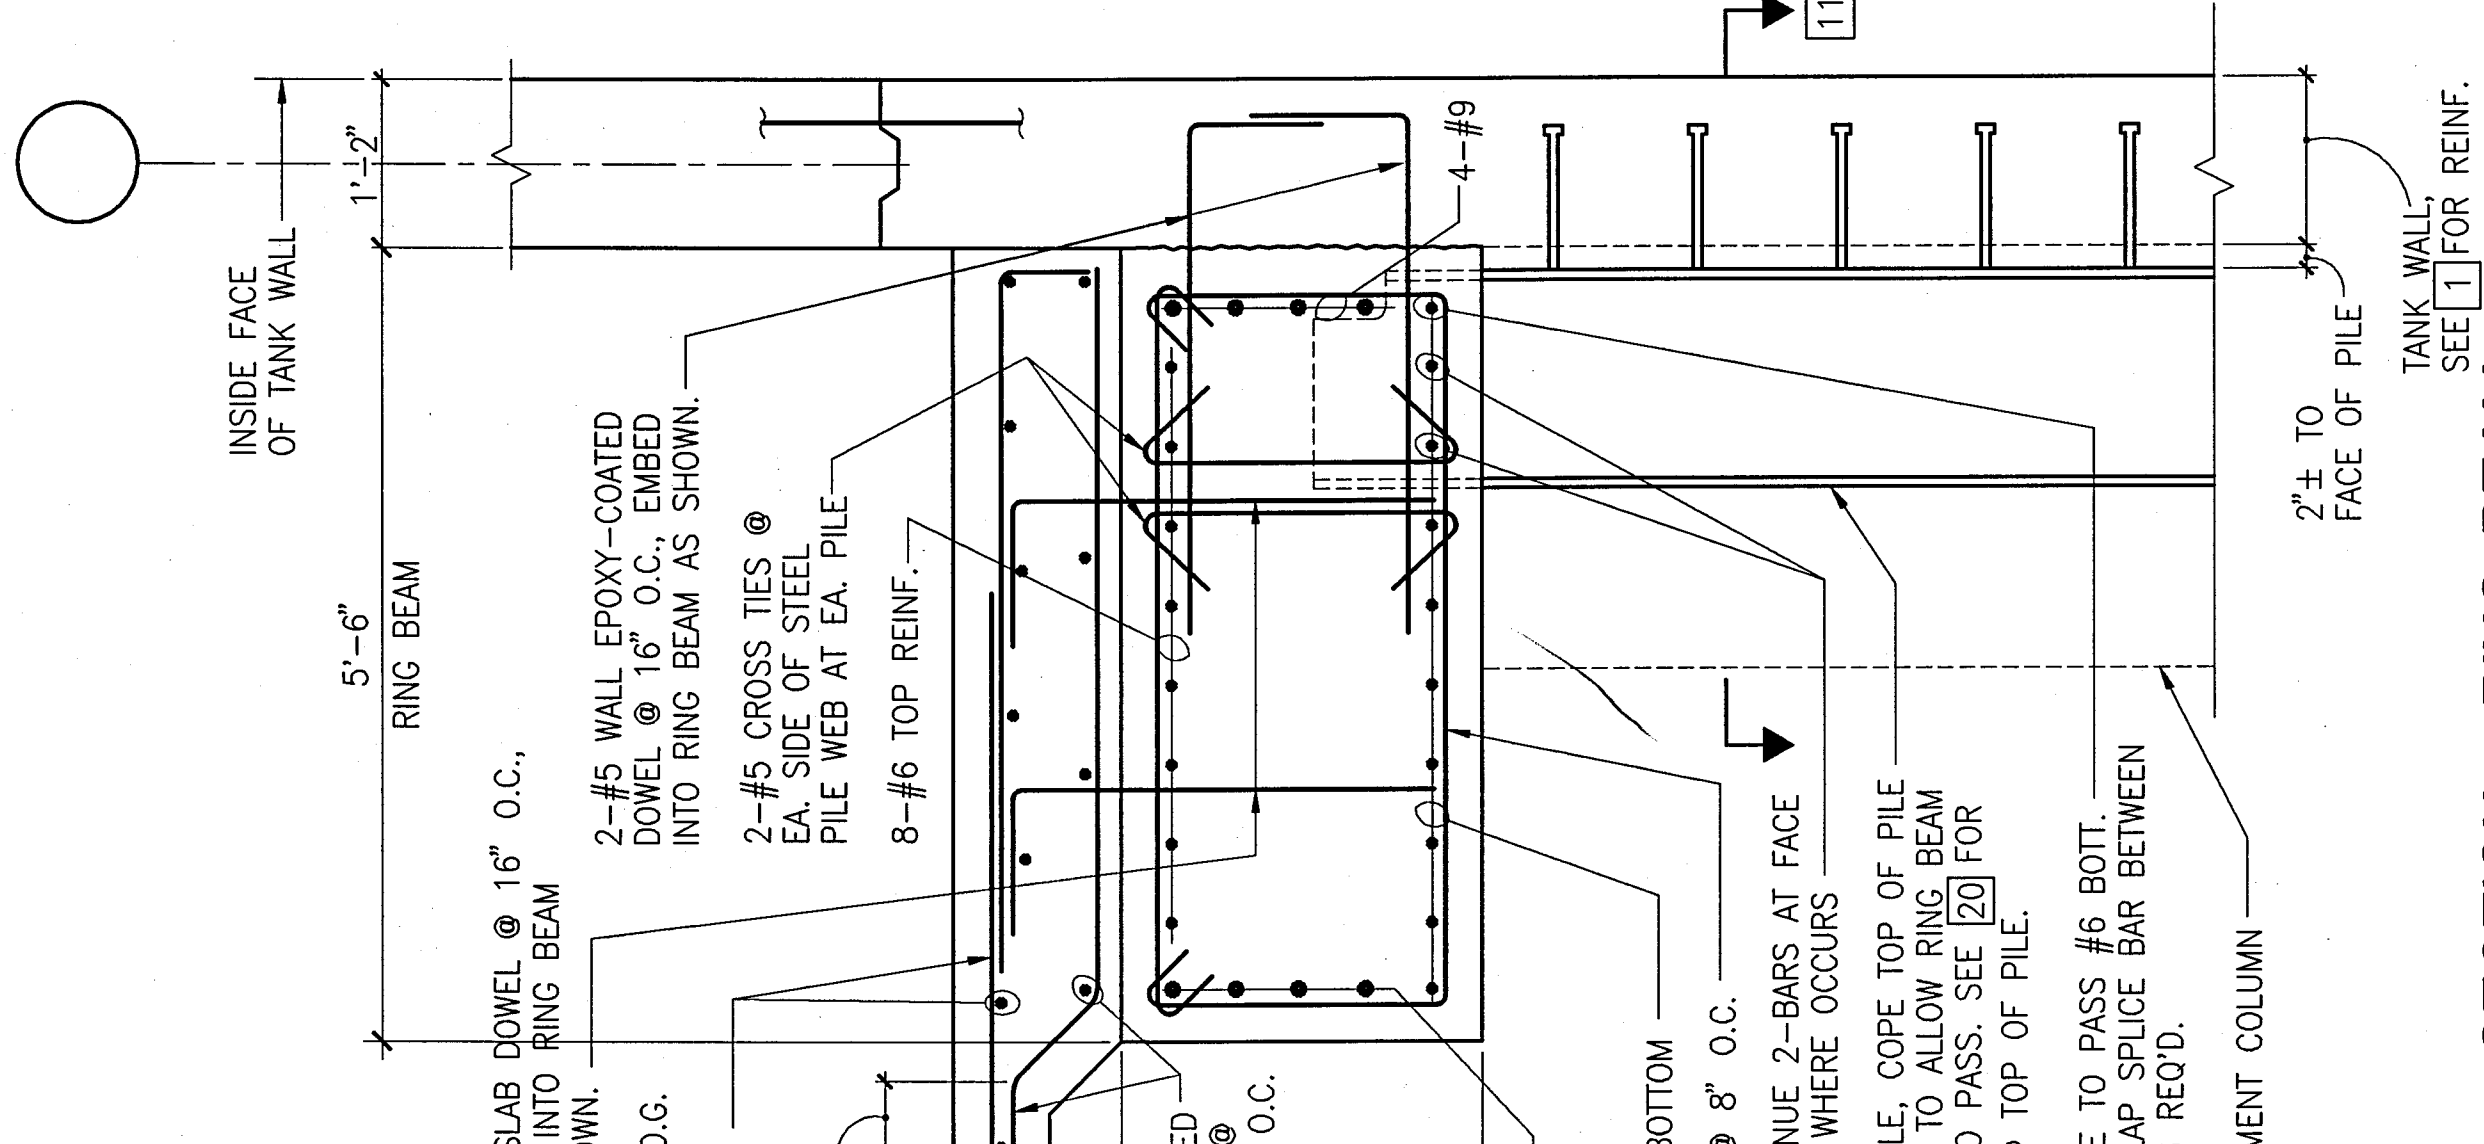


9

SECTION - RING BEAM
3/4" = 1'-0"

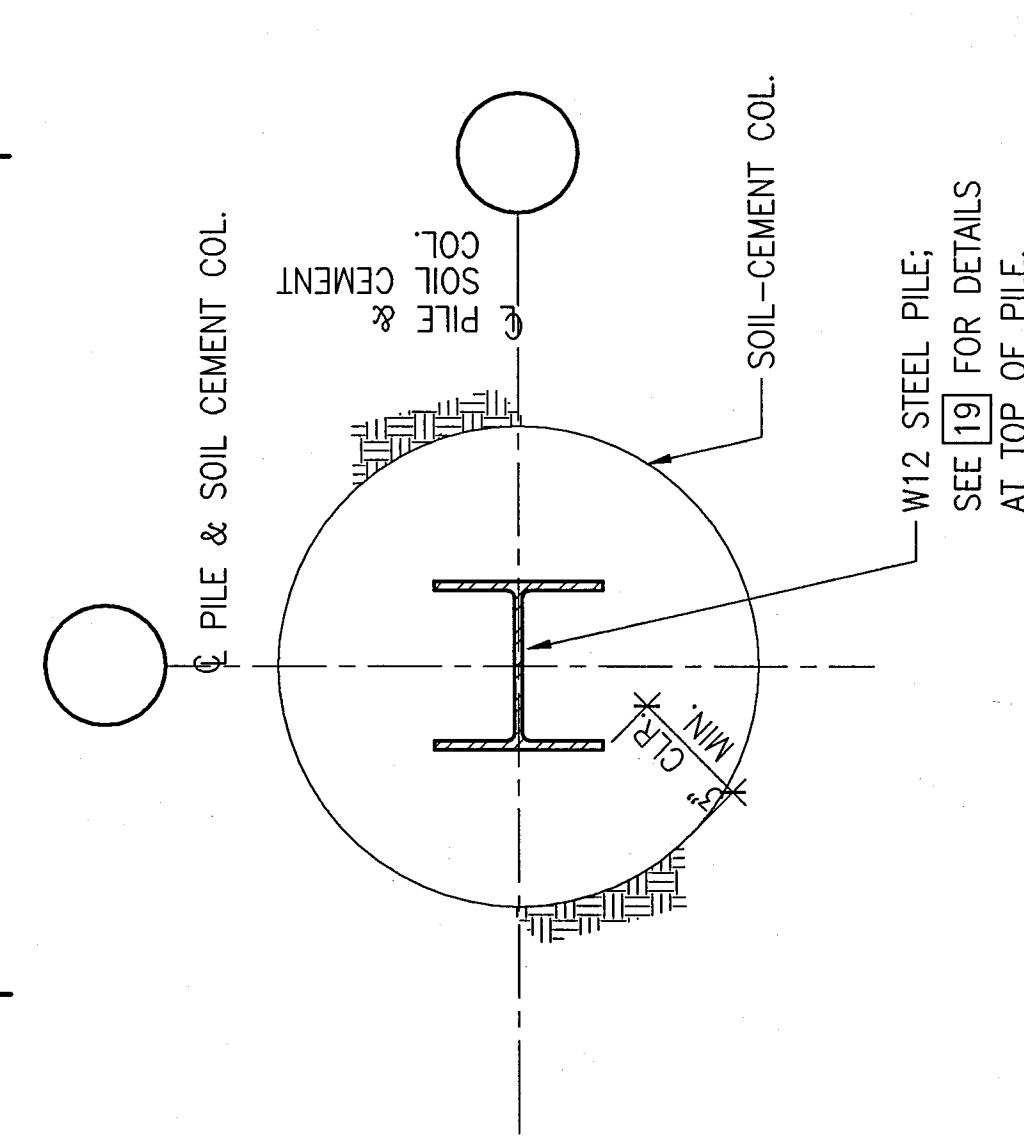


16

PLAN @ TYPICAL PILE
3/4" = 1'-0"

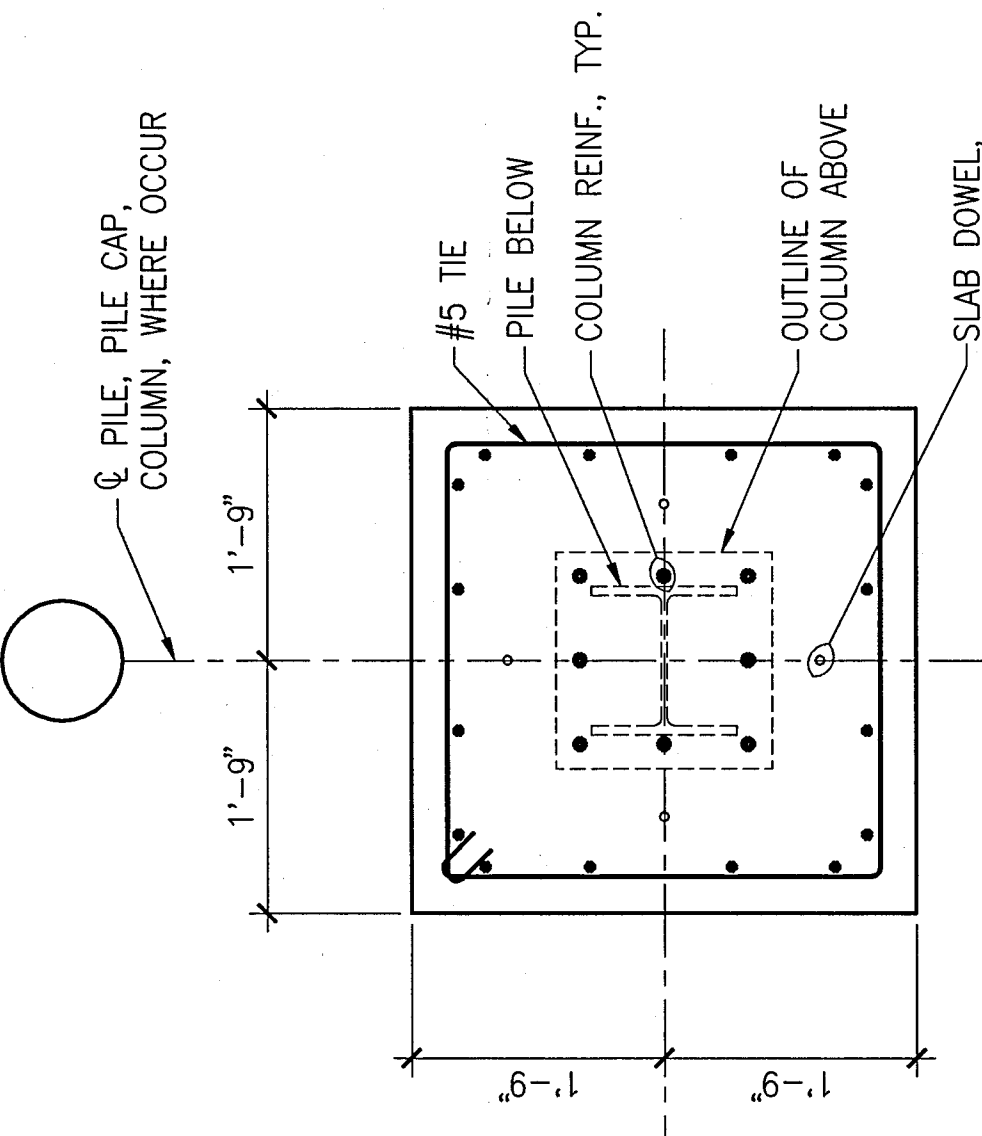


15

PLAN SECTION @ PILE CAP
3/4" = 1'-0"

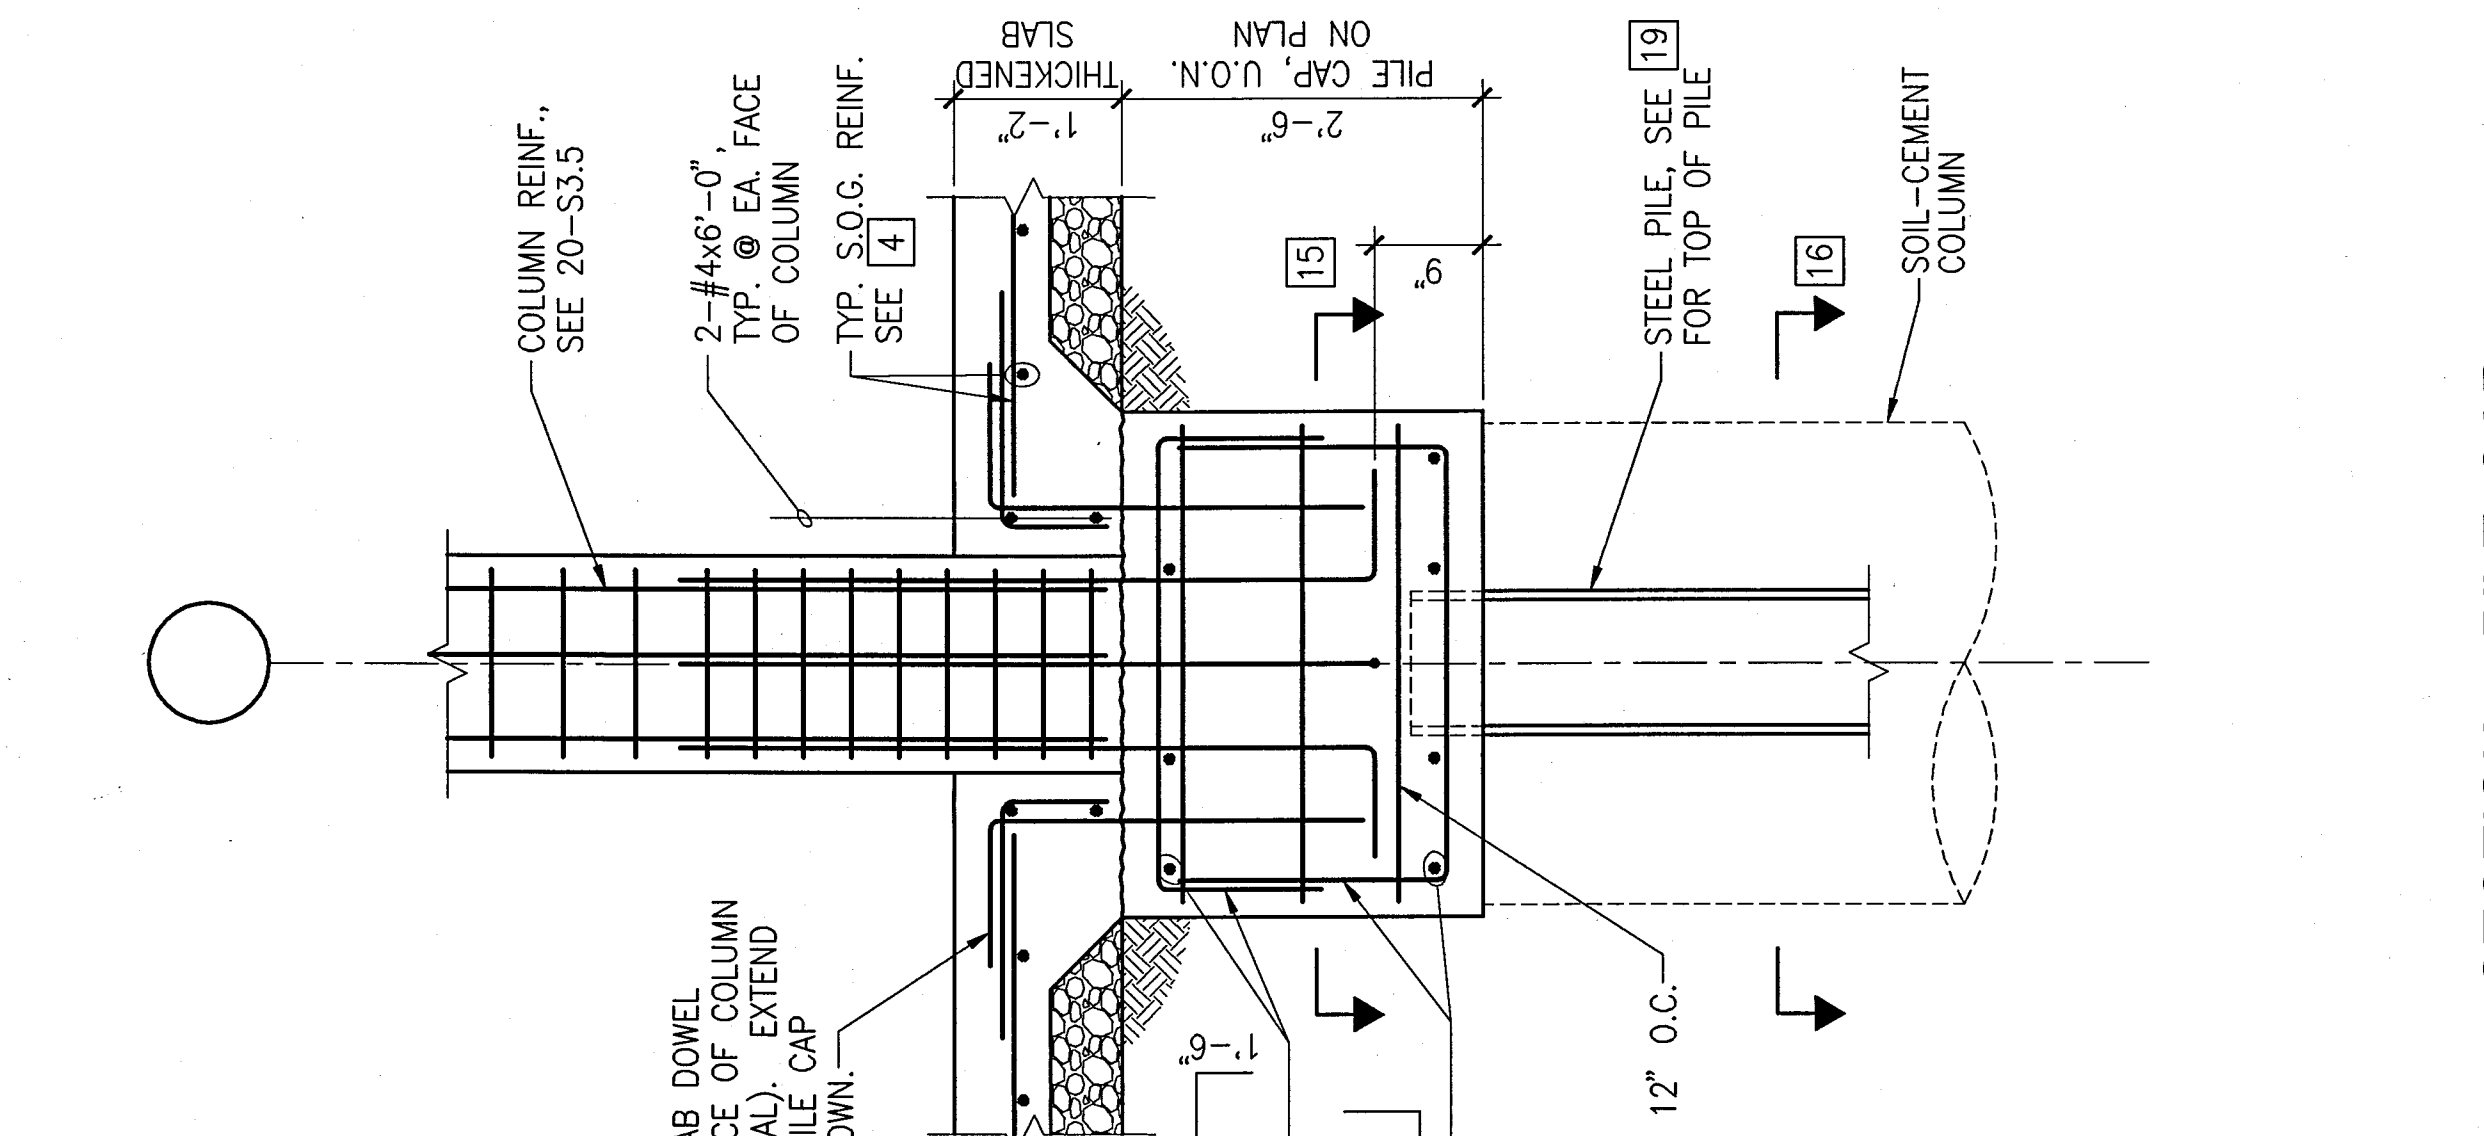


13

SECTION - PILE CAP
3/4" = 1'-0"

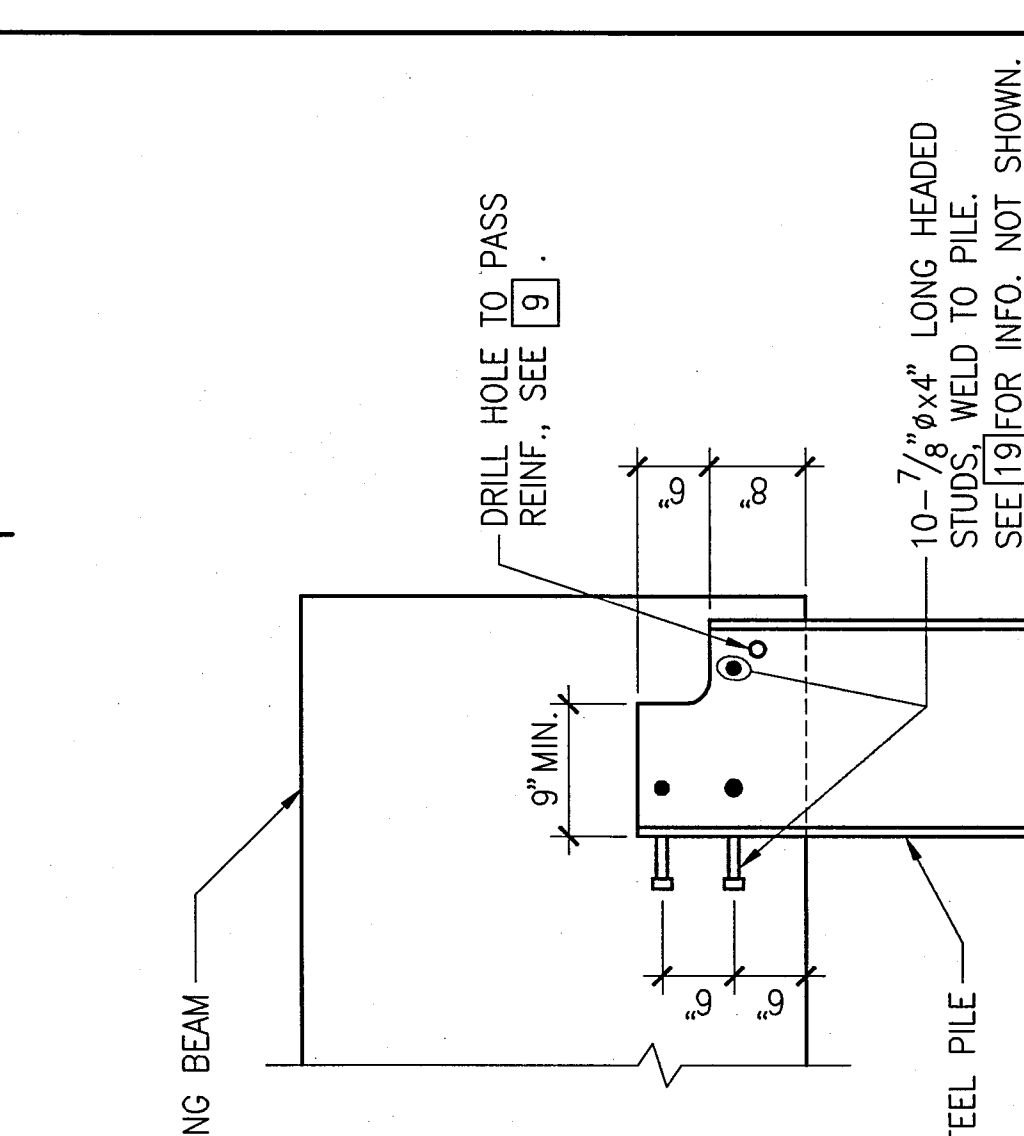


20

TYPICAL W18 PILE BUTT DETAIL
3/4" = 1'-0"

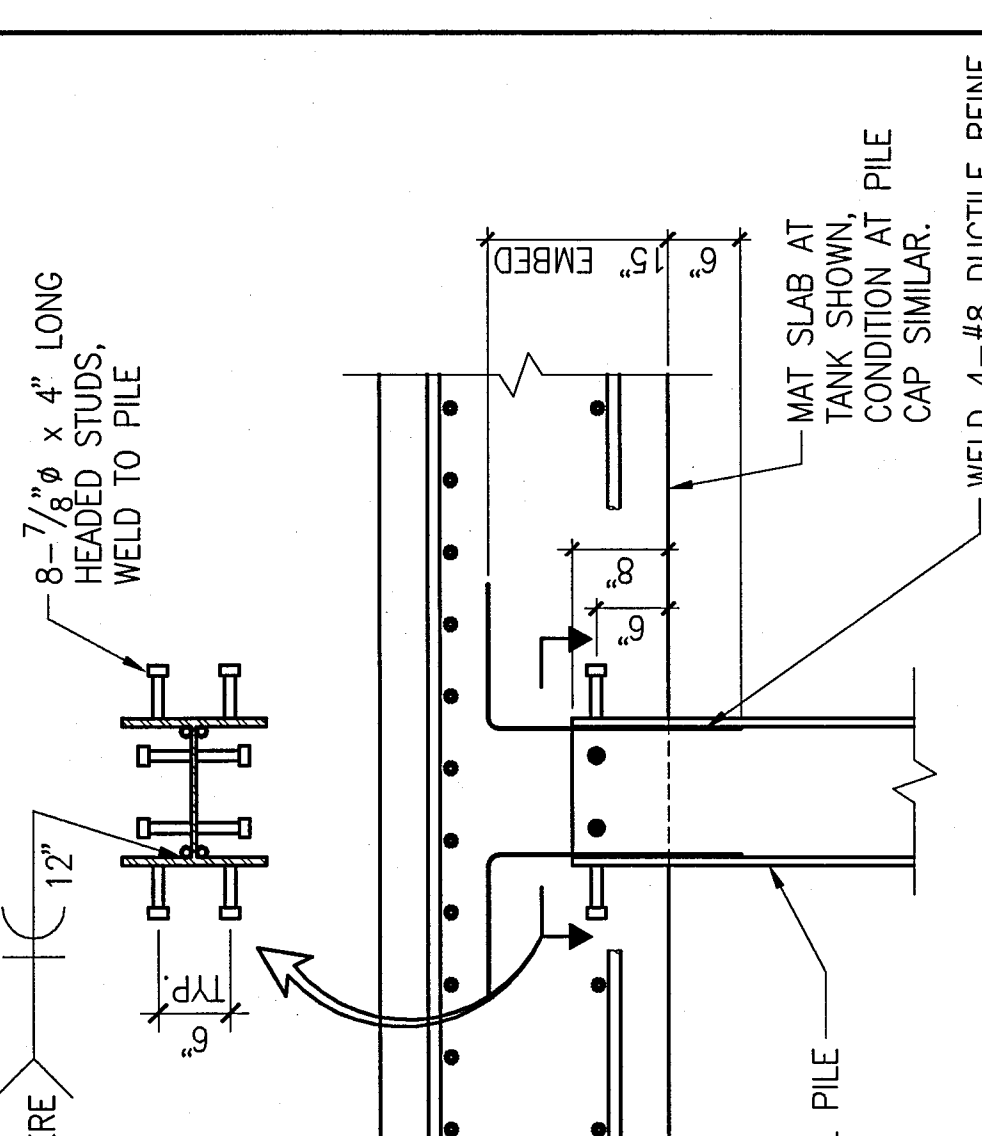

19

TYPICAL W12 PILE BUTT DETAIL
3/4" = 1'-0"

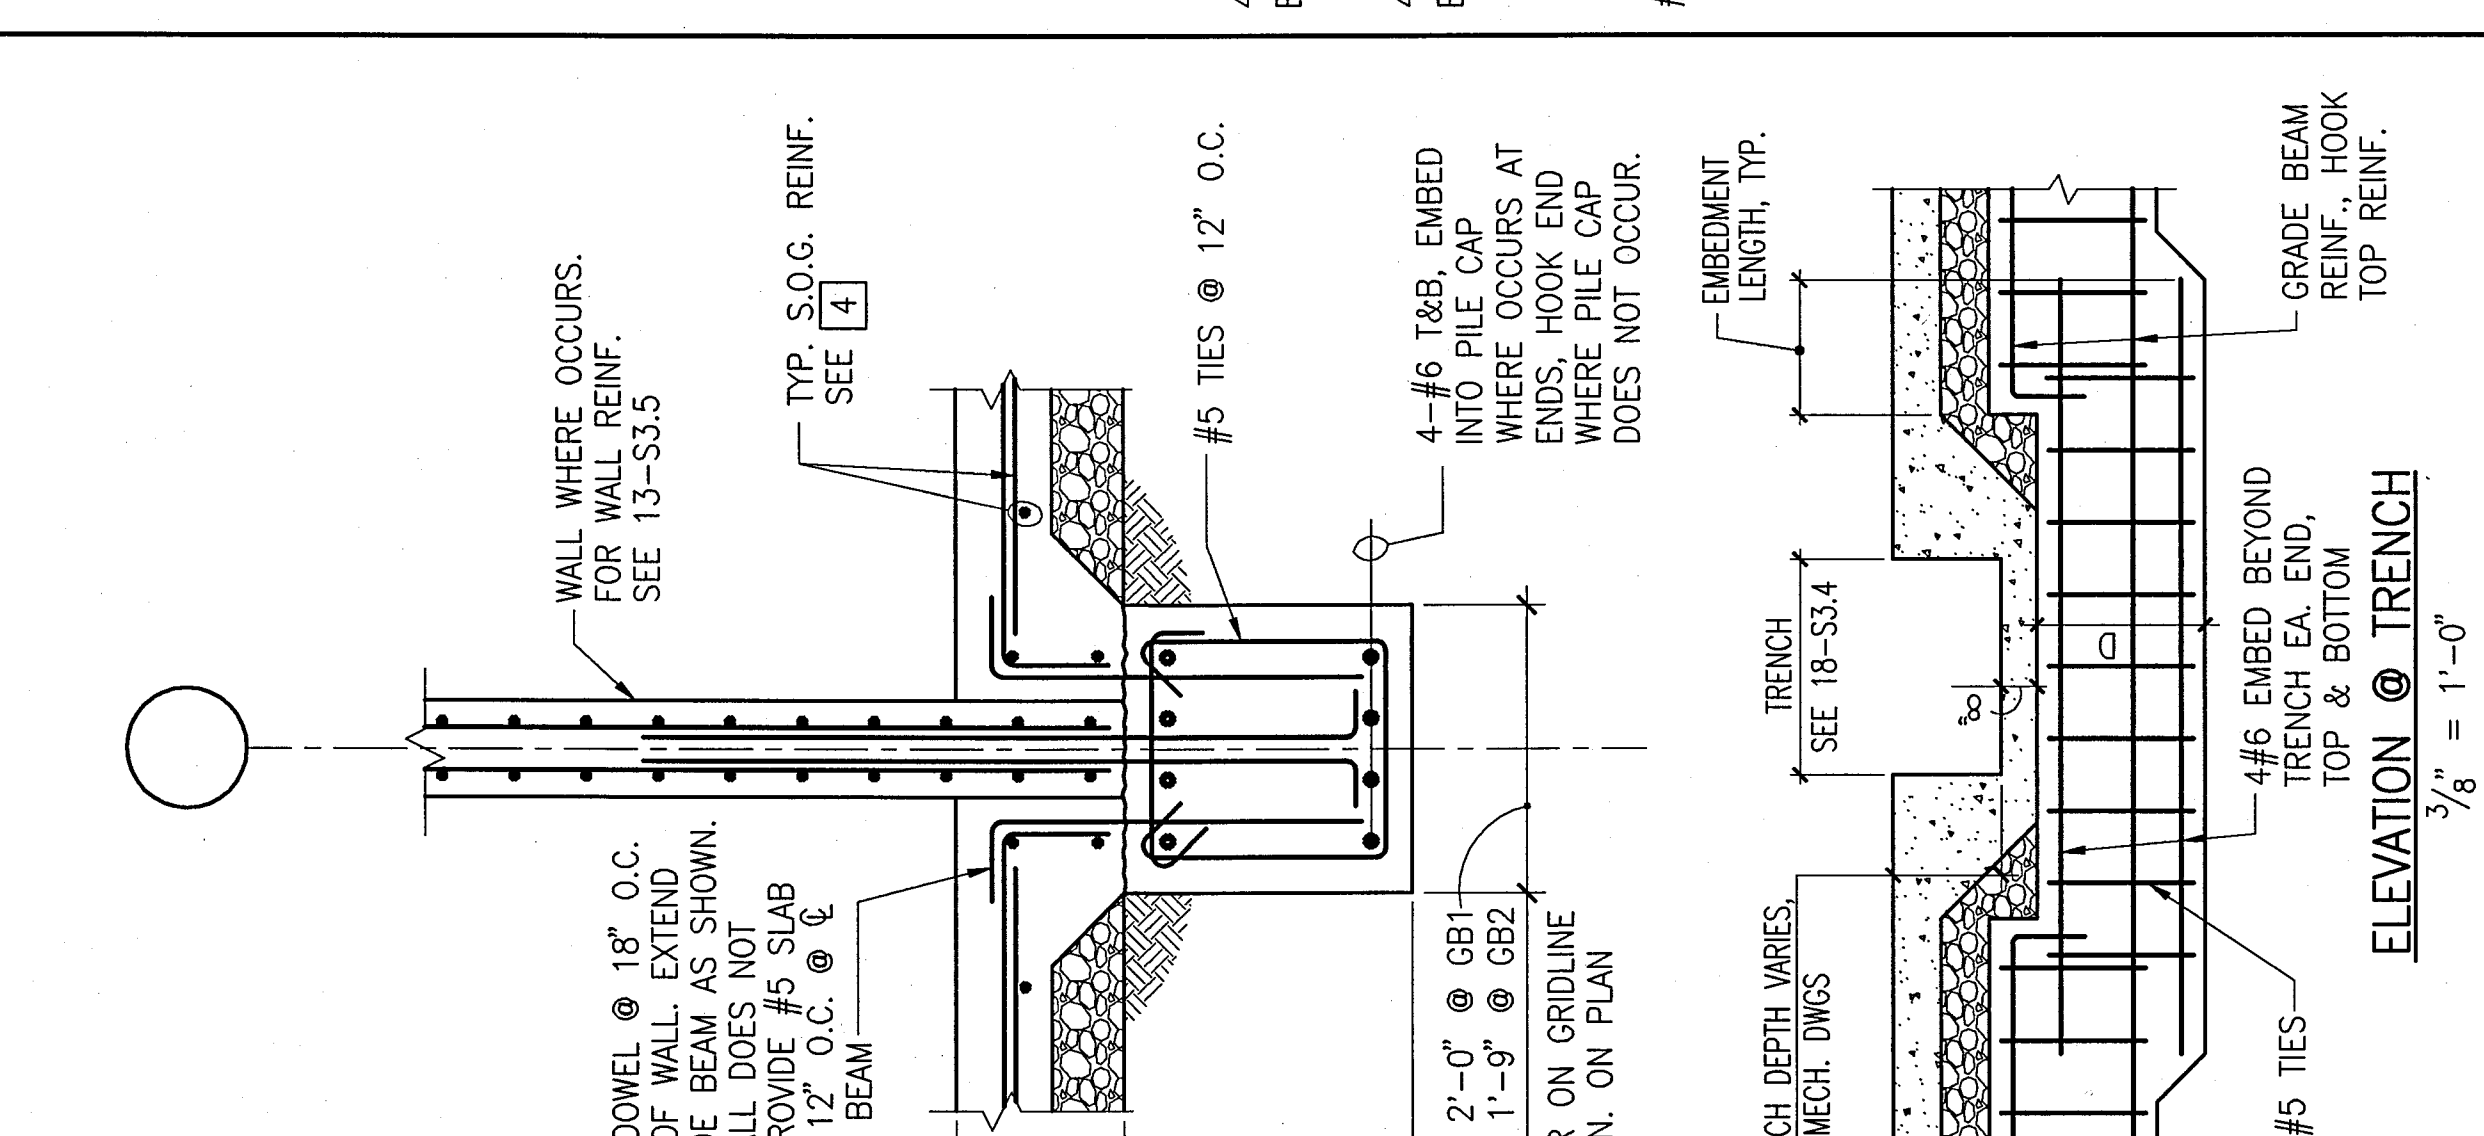

17

SECTION - GRADE BEAM
3/4" = 1'-0"