

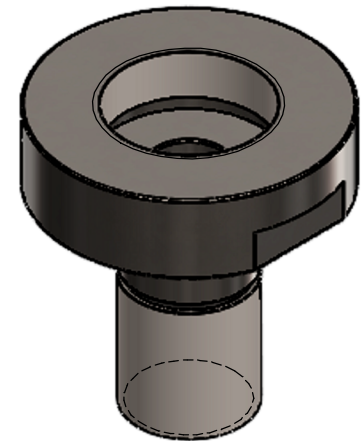


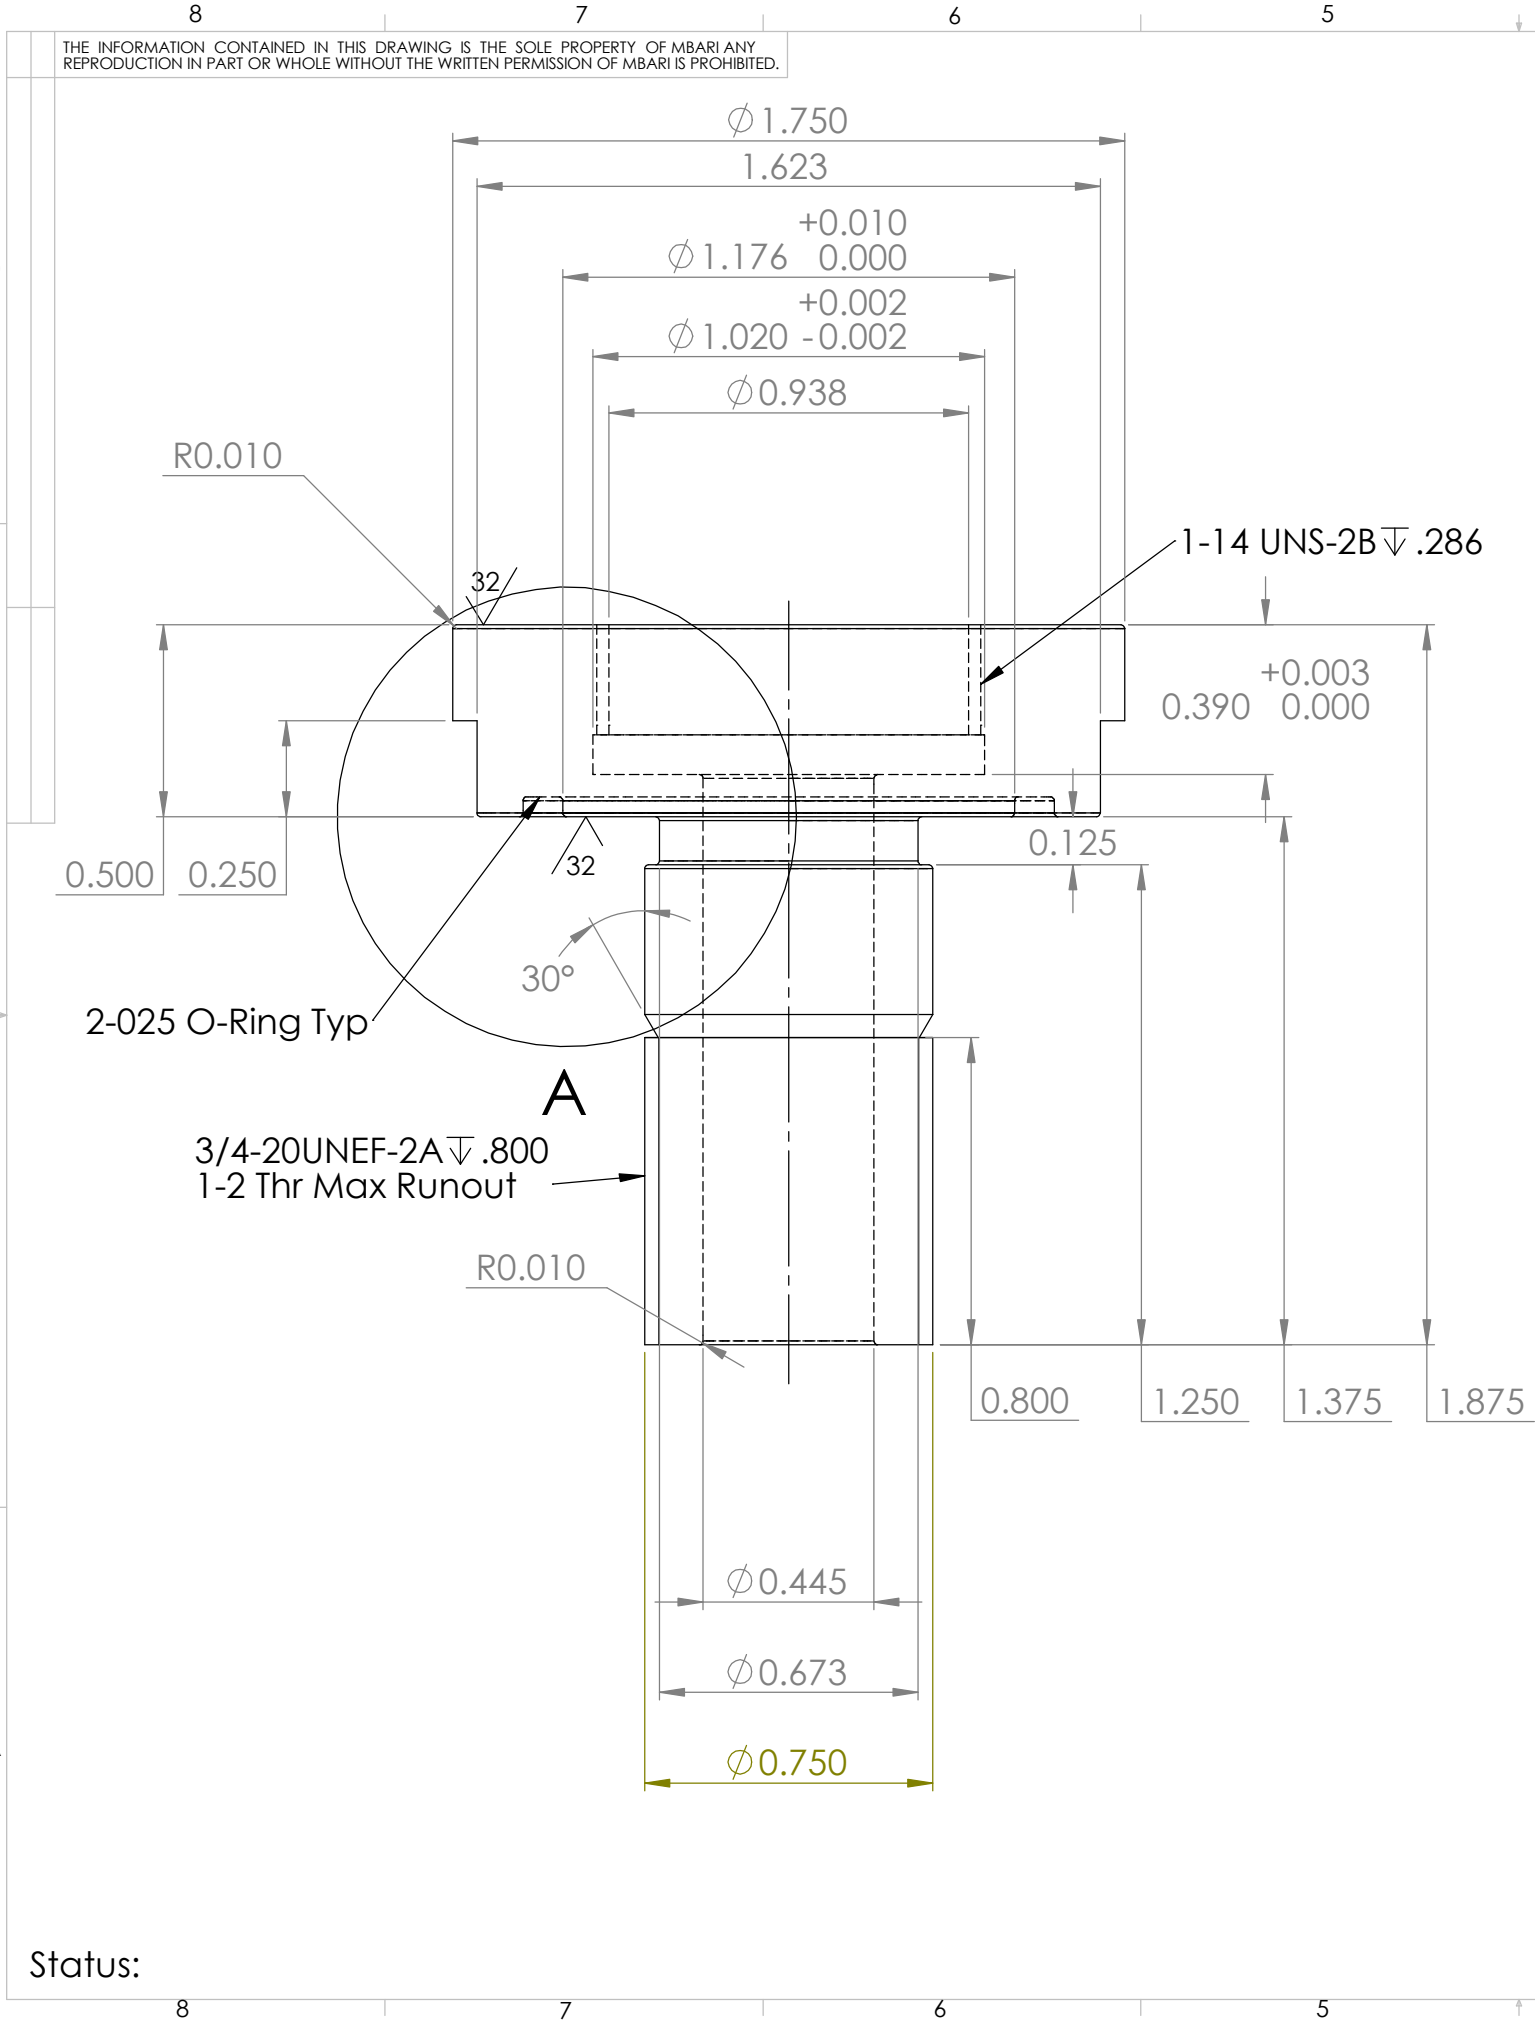

1 Increase depth of thread relief bore from .380 to .390. Keep R.010 Fillet.

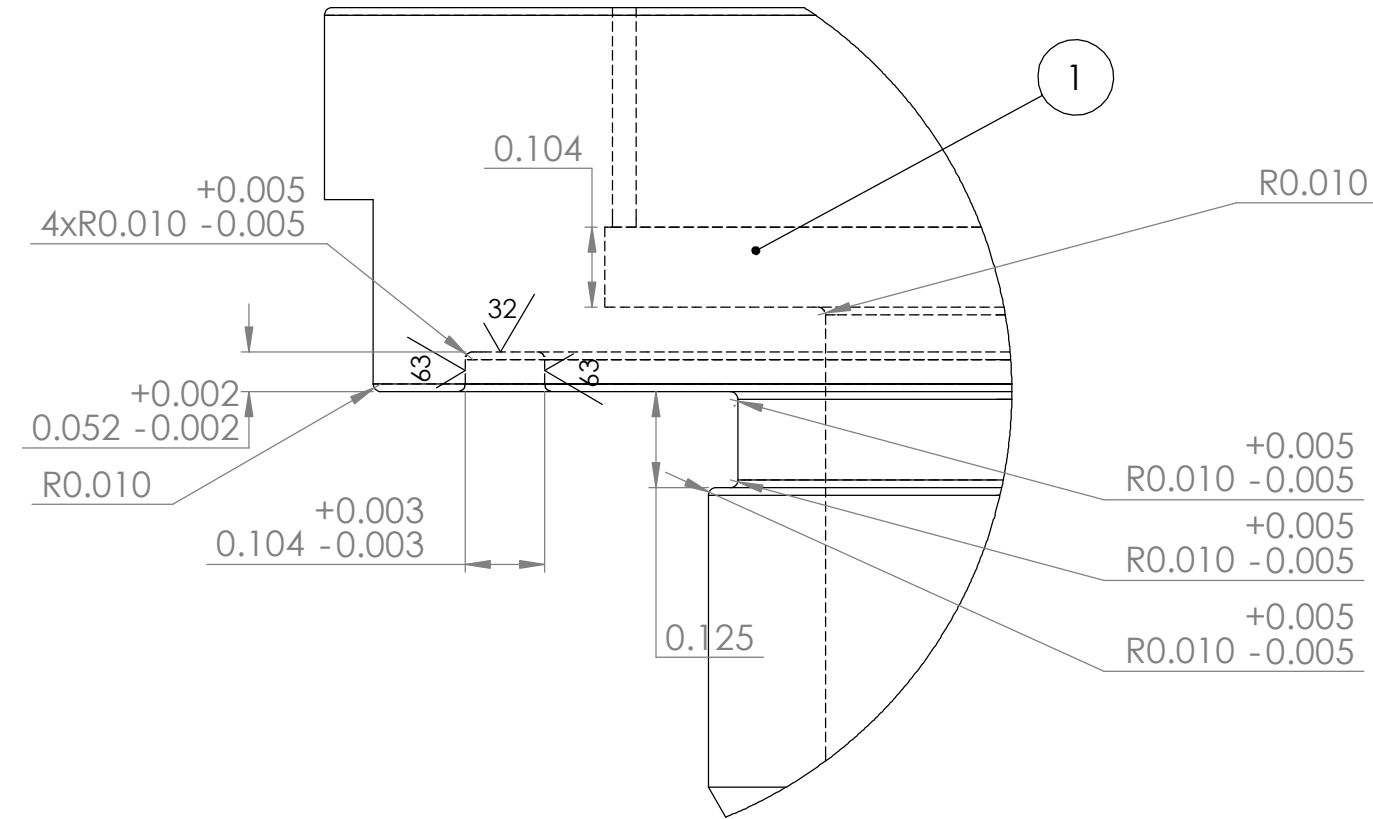

DETAIL A

SCALE 4 : 1

Material: 316 Stainless Steel passivated per QQ-P-35 Type VI

BILL OF MATERIALS									
NEXT ASSY Description		NEXT ASSY Number		UNLESS OTHERWISE SPECIFIED TOLERANCES ARE:				APPROVALS DATE	
				1 PLACE DIM $\pm 1/16$	2 PLACE DIM $\pm .02$	3 PLACE DIM $\pm .005$	ANGLES $\pm 1^\circ$	DRAWN 12/9/2014	Monterey Bay Aquarium Research Institute MBARI 7700 Sandholdt RD. Moss Landing, CA 95039 PH: (831) 775-1700
								ENGINEER H. Thomas	
								CHECKED	
								PROJECT NO. 368000	Adapter, 1.0in PNA to .75in PNA
								PROJECT DMO AUV Operations	
								WEIGHT	
								SCALE 2:1	DWG. NO.
								CAD FILE:	
								SHEET 1 OF 1	REV. REV

Status: