



THE INFORMATION CONTAINED IN THIS DRAWING IS THE SOLE PROPERTY OF MBARI ANY REPRODUCTION IN PART OR WHOLE WITHOUT THE WRITTEN PERMISSION OF MBARI IS PROHIBITED.

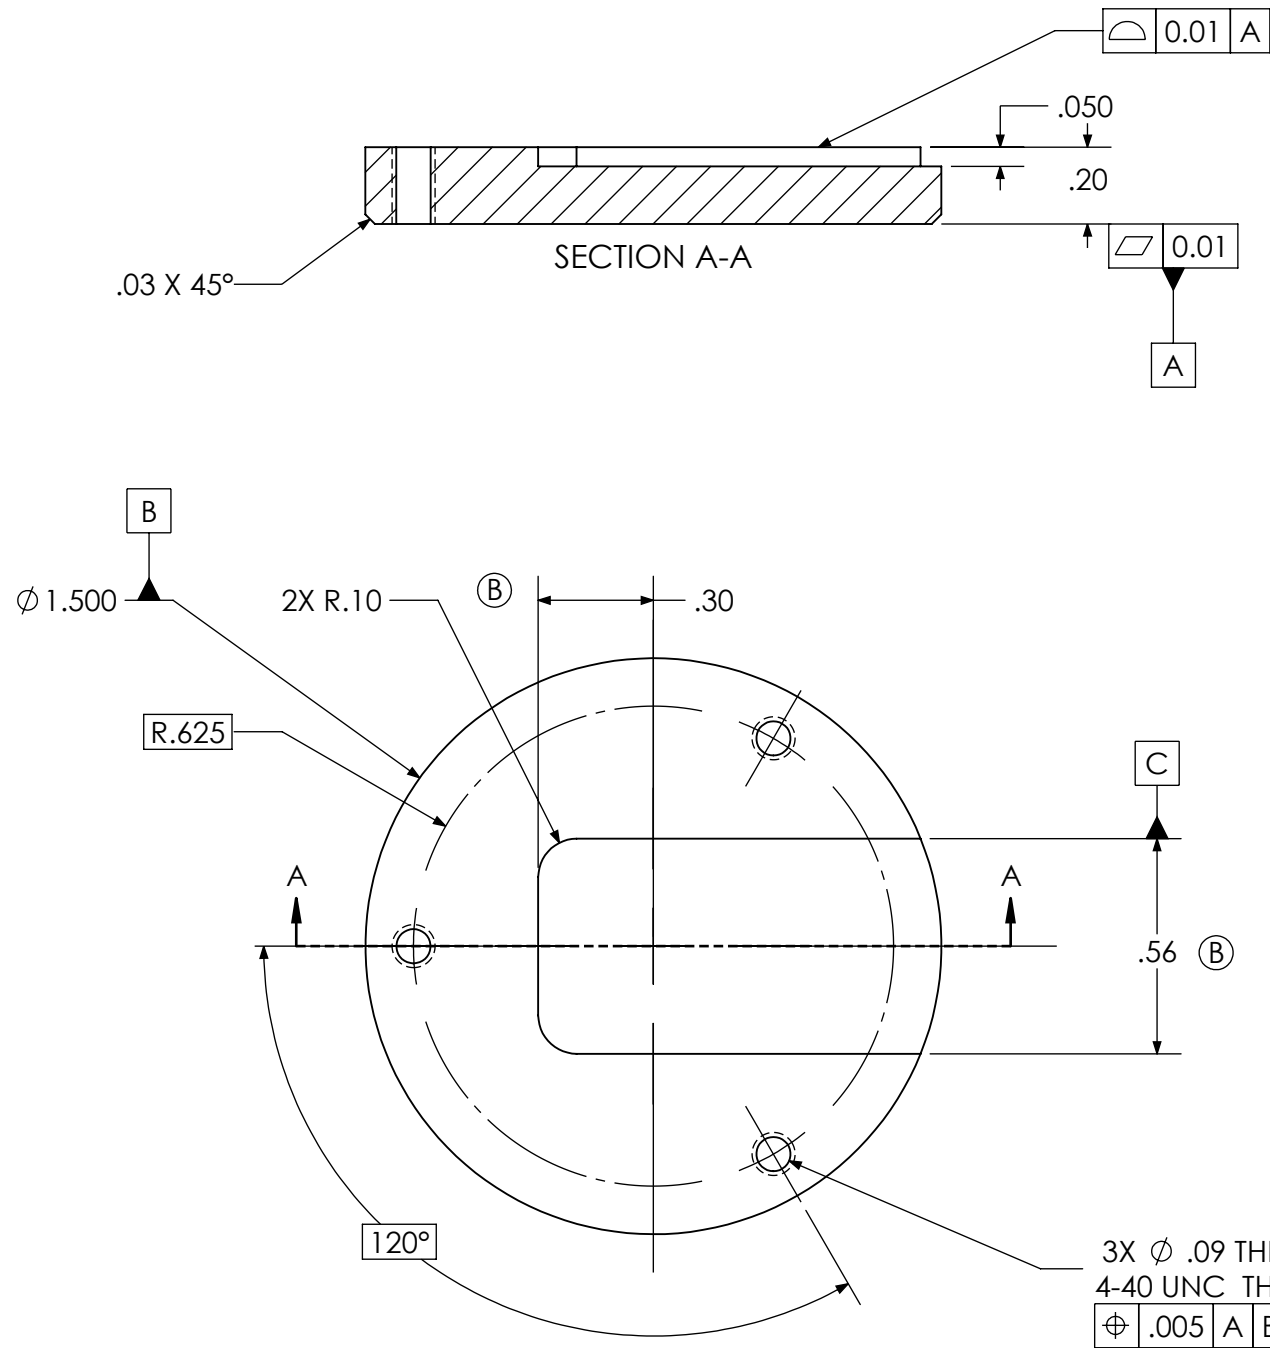

REVISIONS				
ZONE	REV.	DESCRIPTION	DATE	APPROVED
	A	ORIGINAL RELEASE	5/4/2023	E. NICHOLSON
A2, B3	B	MODIFIED SENSOR SLOT TO FIT SELECTED SENSOR GEOMETRY. ADDED PN, PROJECT, AND NHA INFO.	5/18/2023	E. NICHOLSON

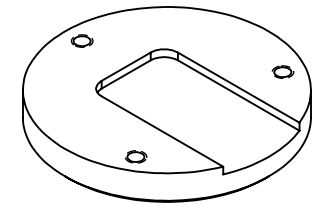

ACTUAL SIZE

NOTES:

1. MATERIAL: AL 6061-O.

UNLESS OTHERWISE SPECIFIED TOLERANCES ARE:				APPROVALS		DATE		MONTEREY BAY AQUARIUM RESEARCH INSTITUTE			
1 PLACE DIM ±1/16	2 PLACE DIM ±.02	3 PLACE DIM ±.005	ANGLES ±1°	DRAWN: ENOCH NICHOLSON		05/04/2023		MBARI 7700 SANDHOLDT RD. MOSS LANDING, CA 95039 PH: (831) 775-1700			
1. DIMENSIONS ARE IN INCHES 2. DIMENSION LIMITS HELD AFTER PLATING. 3. REMOVE BURRS AND SHARP EDGES .015 MAX. 4. MACHINED FILLET RADII .0150-.030. 5. MACHINED DIAMETERS ON A COMMON CENTERLINE CONCENTRIC WITHIN .005 6. PERPENDICULARITY & PARALLELISM OF MACHINED SURFACES .002 PER INCH. MAX .012 INCHES FOR SINGLE SURFACE.				ENGINEER: ENOCH NICHOLSON		05/04/2023					
				CHECKED: X		XX/XX/XXXX					
				PROJECT NO: 706008							
				PROJECT: READI-NET							
				NHA: 100221873				SIZE B		DWG. NO. 100221880	
DO NOT SCALE DRAWING				WEIGHT: 0.01 LB.				SCALE 2:1		SHEET 1 OF 1	