

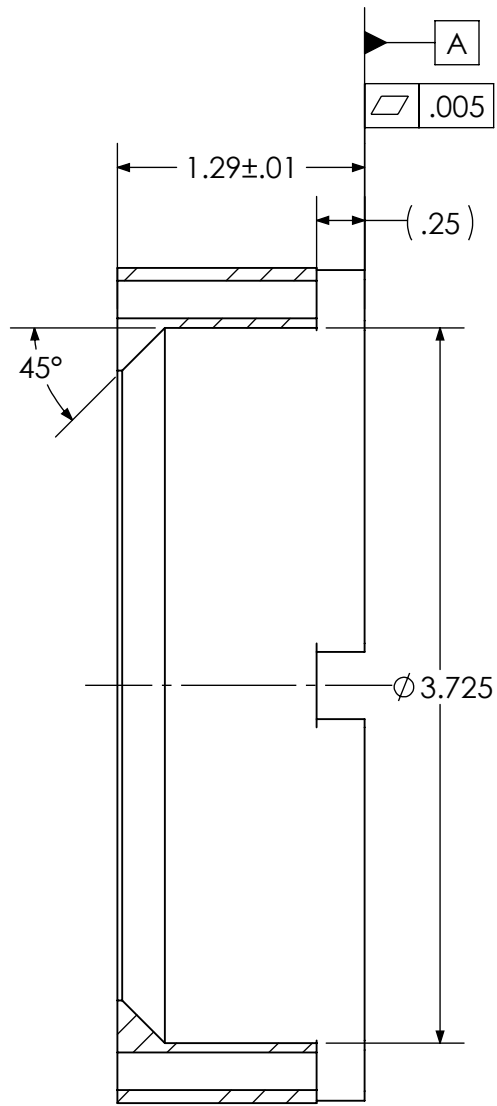


THE INFORMATION CONTAINED IN THIS DRAWING IS THE SOLE PROPERTY OF MBARI ANY REPRODUCTION IN PART OR WHOLE WITHOUT THE WRITTEN PERMISSION OF MBARI IS PROHIBITED.

REVISIONS				
ZONE	REV.	DESCRIPTION	DATE	APPROVED
	A	ORIGINAL RELEASE	9/5/2023	E.NICHOLSON
	B	ADJUSTED FIT WITH VIEWPORTS, REMOVED CBORE SLOT FROM TOP SURFACE, EXTENDED 6-32 HOLES.	1/1/2024	E.NICHOLSON

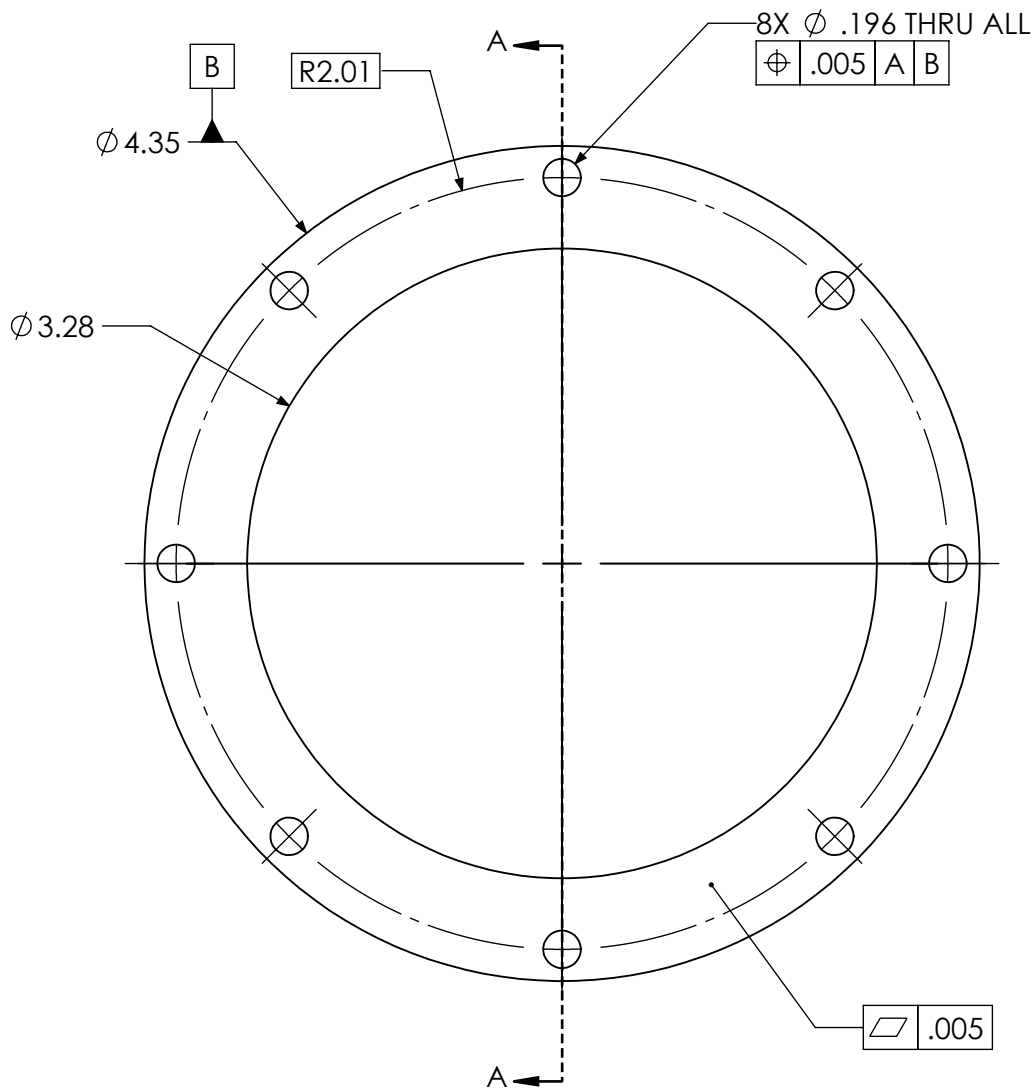

SECTION A-A

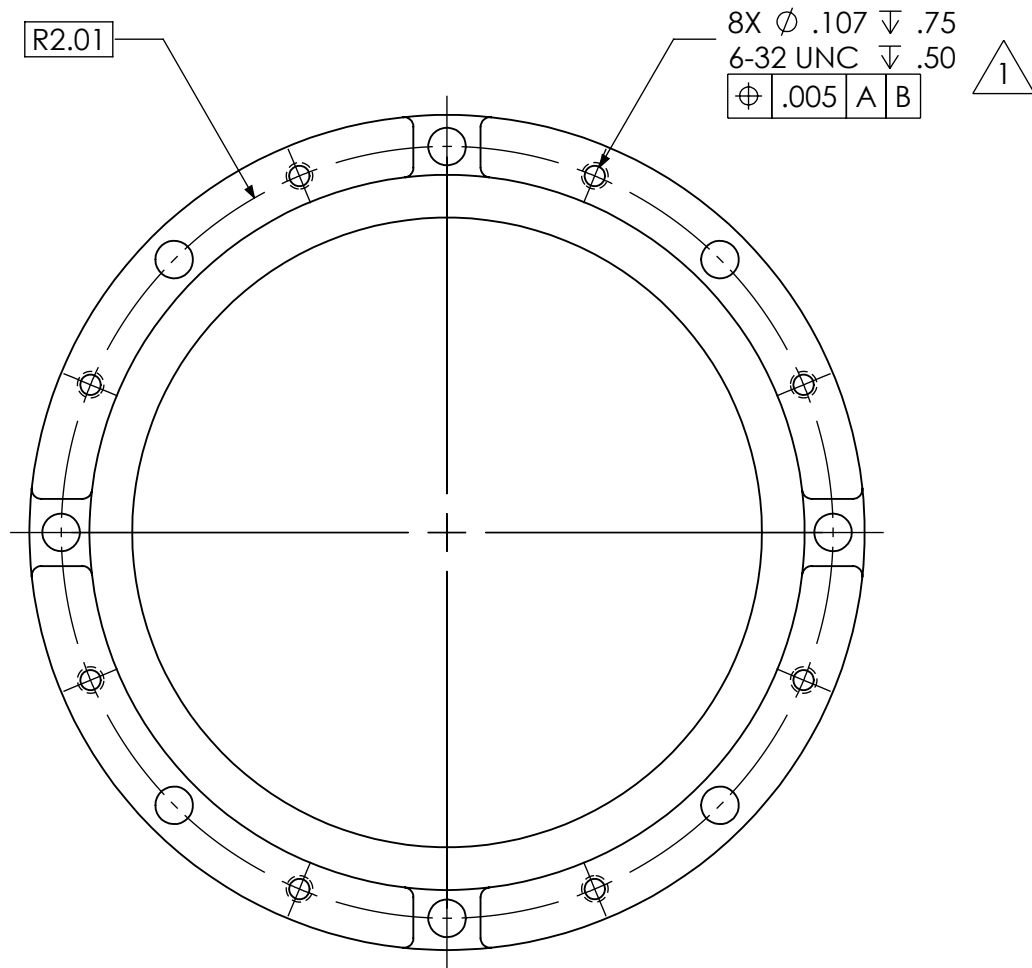

NOTES:

A triangle with the number 1 inside.

CLEAR HOLES WITH TAP DRILL PRIOR TO TAPPING.

UNLESS OTHERWISE SPECIFIED				APPROVALS		DATE		MONTEREY BAY AQUARIUM RESEARCH INSTITUTE 			
1 PLACE DIM ±1/16	2 PLACE DIM ±.02	3 PLACE DIM ±.005	ANGLES ±1°	DRAWN: ENOCH NICHOLSON		2023-09-01		MBARI 7700 SANDHOLDT RD. MOSS LANDING, CA 95039 PH: (831) 775-1700			
DIMENSIONS ARE IN INCHES. - DIMENSION LIMITS HELD AFTER PLATING. - REMOVE BURRS AND SHARP EDGES .015 MAX. - MACHINED FILLET RADII .015-0.30. - $\pm .005$ FOR MACHINED DIAMETERS SHARING A C. - $\perp$ & $\parallel$ OF MACHINED SURFACES .002 PER INCH. MAX .012 INCHES FOR SINGLE SURFACE. - $\sqrt{R}$ ON MACHINED SURFACES - $\sqrt{D}$ ON DRILLED HOLES				ENGINEER: ENOCH NICHOLSON		2023-09-01					
				CHECKED:							
				PROJECT: SINKER 902306				HOUSING A VIEWPORT RETAINING RING			
				MATERIAL: PA-12							
				NHA: 100221995				SIZE B DWG. NO. 100221988		REV. B	
DO NOT SCALE DRAWING				WEIGHT: 0.18 LB.		SCALE 1:1		SHEET 1 OF 1			