

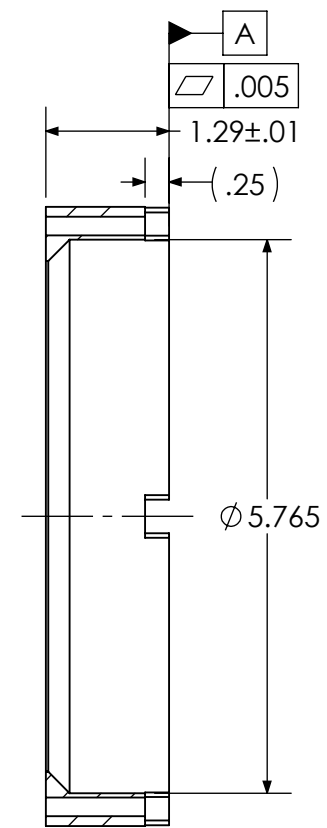


THE INFORMATION CONTAINED IN THIS DRAWING IS THE SOLE PROPERTY OF MBARI ANY REPRODUCTION IN PART OR WHOLE WITHOUT THE WRITTEN PERMISSION OF MBARI IS PROHIBITED.

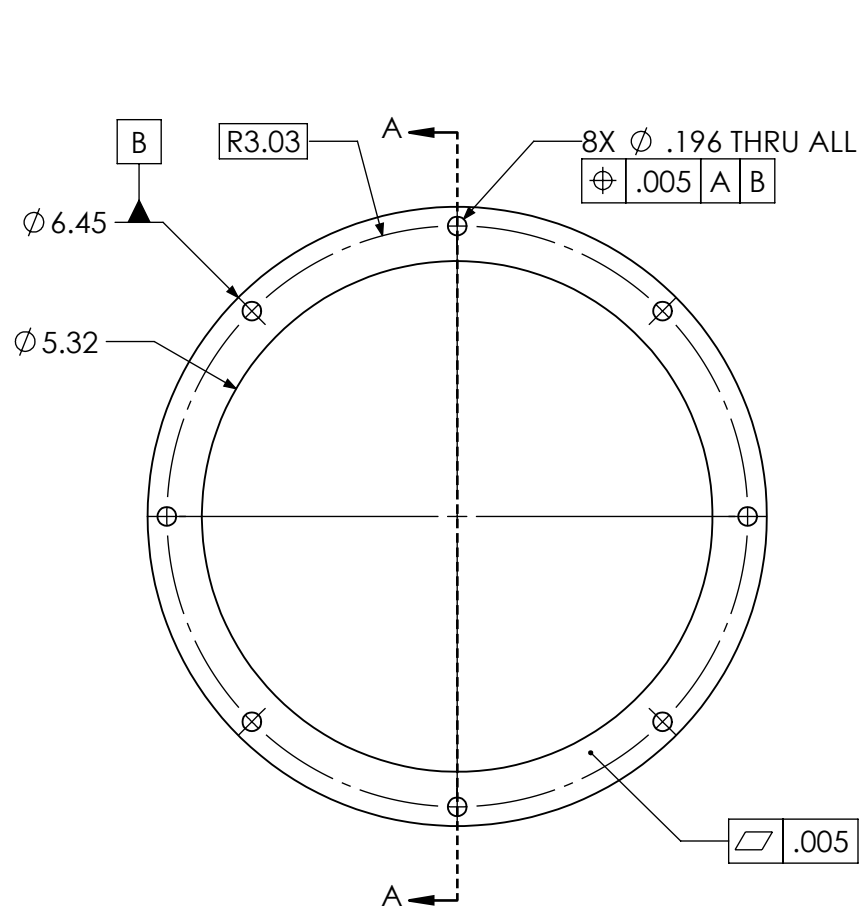

SECTION A-A

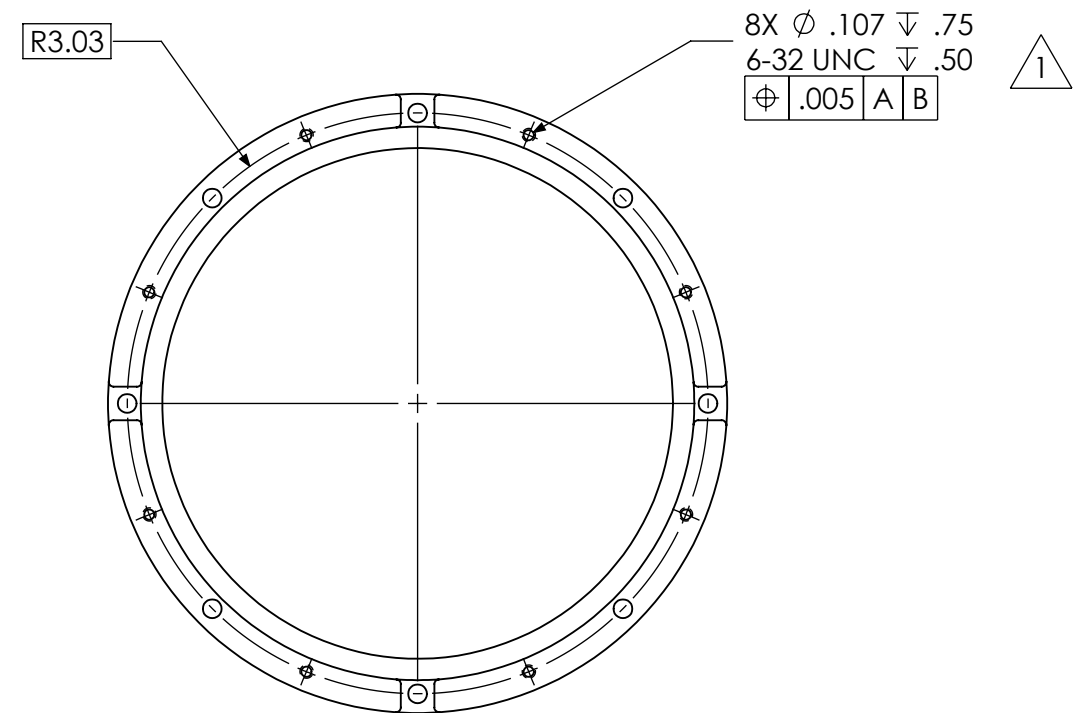

NOTES:

 CLEAR HOLES WITH TAP DRILL PRIOR TO TAPPING.

REVISIONS				
ZONE	REV.	DESCRIPTION	DATE	APPROVED
	A	ORIGINAL RELEASE		
	B	ADJUSTED FOT WITH VIEWPORT, REMOVED CBORE SLOT FROM THE TOP SURFACE, EXTENDED 6-32 HOLES	1/1/2024	E. NICHOLSON

UNLESS OTHERWISE SPECIFIED				APPROVALS		DATE		MONTEREY BAY AQUARIUM RESEARCH INSTITUTE			
1 PLACE DIM ±1/16	2 PLACE DIM ±.02	3 PLACE DIM ±.005	ANGLES ±1°	DRAWN: ENOCH NICHOLSON		2023-09-01		MBARI 7700 SANDHOLDT RD. MOSS LANDING, CA 95039 PH: (831) 775-1700			
- DIMENSIONS ARE IN INCHES. - DIMENSION LIMITS HELD AFTER PLATING. - REMOVE BURRS AND SHARP EDGES .015 MAX. - MACHINED FILLET RADII .015-.030. - ⌀ .005 FOR MACHINED DIAMETERS SHARING A C. - +/- .005 OF MACHINED SURFACES .002 PER INCH. MAX .012 INCHES FOR SINGLE SURFACE. - ✓ ON MACHINED SURFACES - ✓ ON DRILLED HOLES				ENGINEER: ENOCH NICHOLSON		2023-09-01		HOUSING B VIEWPORT RETAINING RING			
				CHECKED: X		XX/XX/XXXX					
				PROJECT: SINKER 902306							
MATERIAL: PA-12				NHA: 100222002		SIZE B		DWG. NO. 100222005		REV. C	
DO NOT SCALE DRAWING				WEIGHT: 0.31 LB.		SCALE 1:2		SHEET 1		OF 1	