




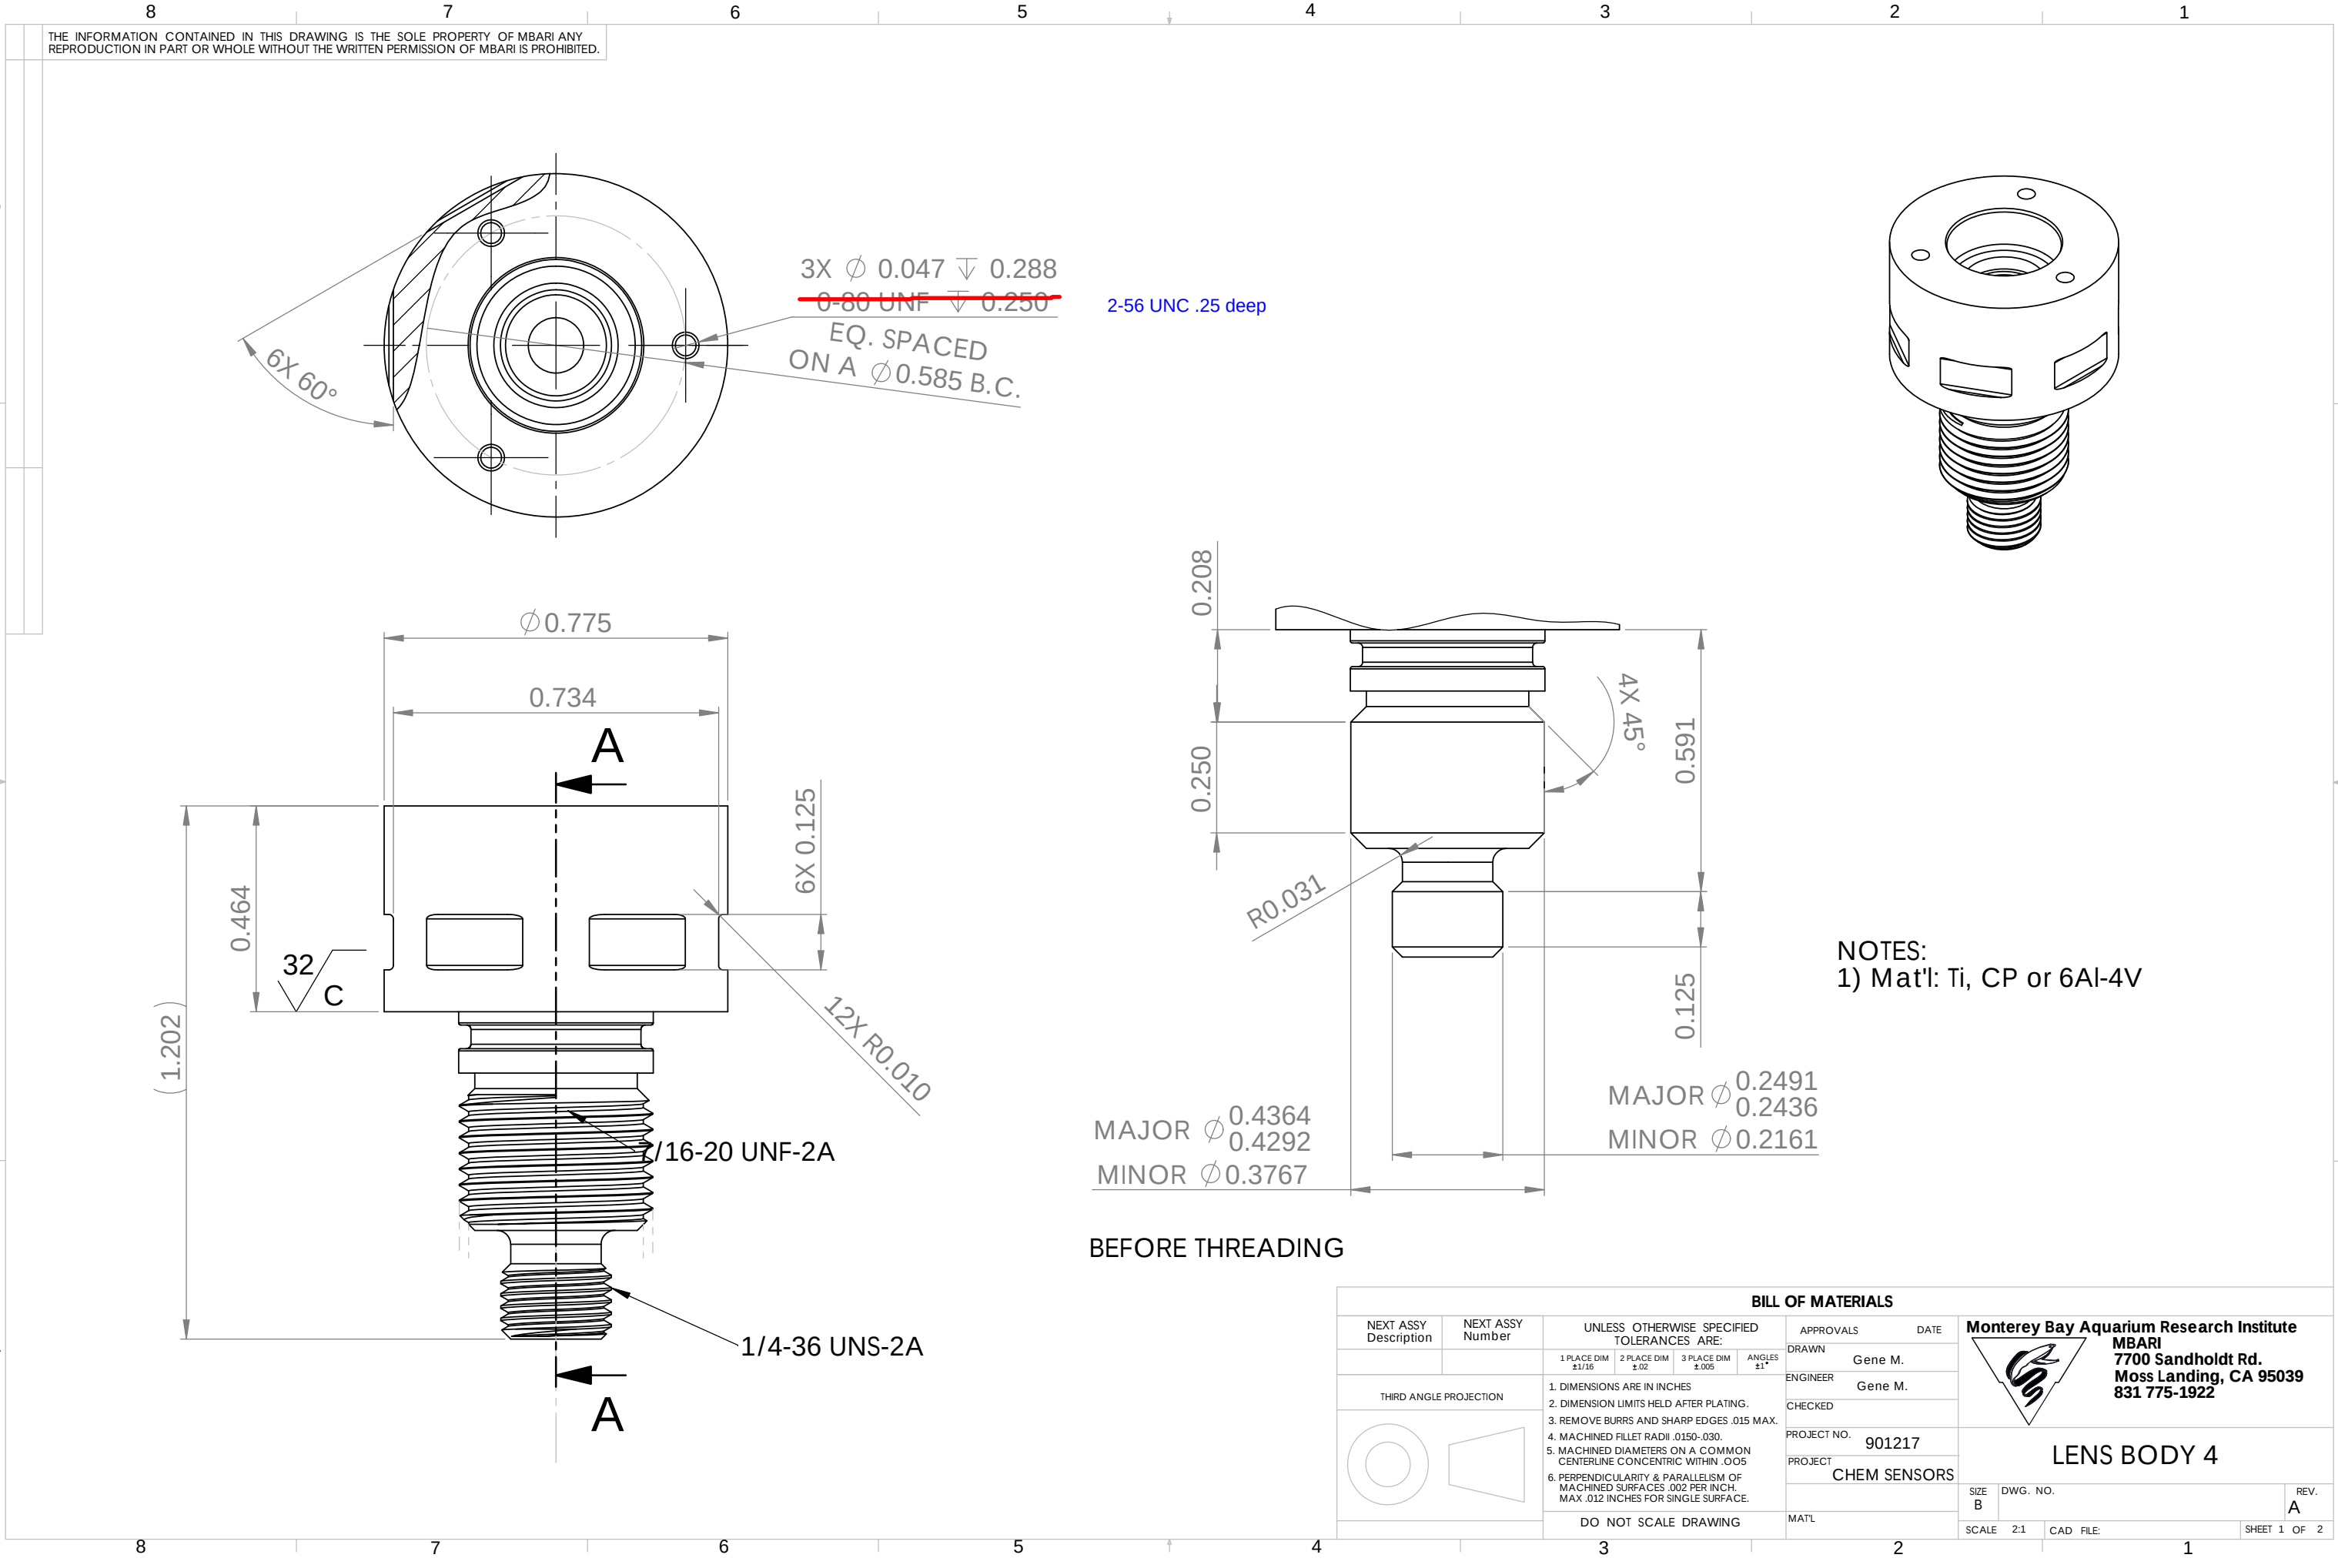

THE INFORMATION CONTAINED IN THIS DRAWING IS THE SOLE PROPERTY OF MBARI ANY REPRODUCTION IN PART OR WHOLE WITHOUT THE WRITTEN PERMISSION OF MBARI IS PROHIBITED.

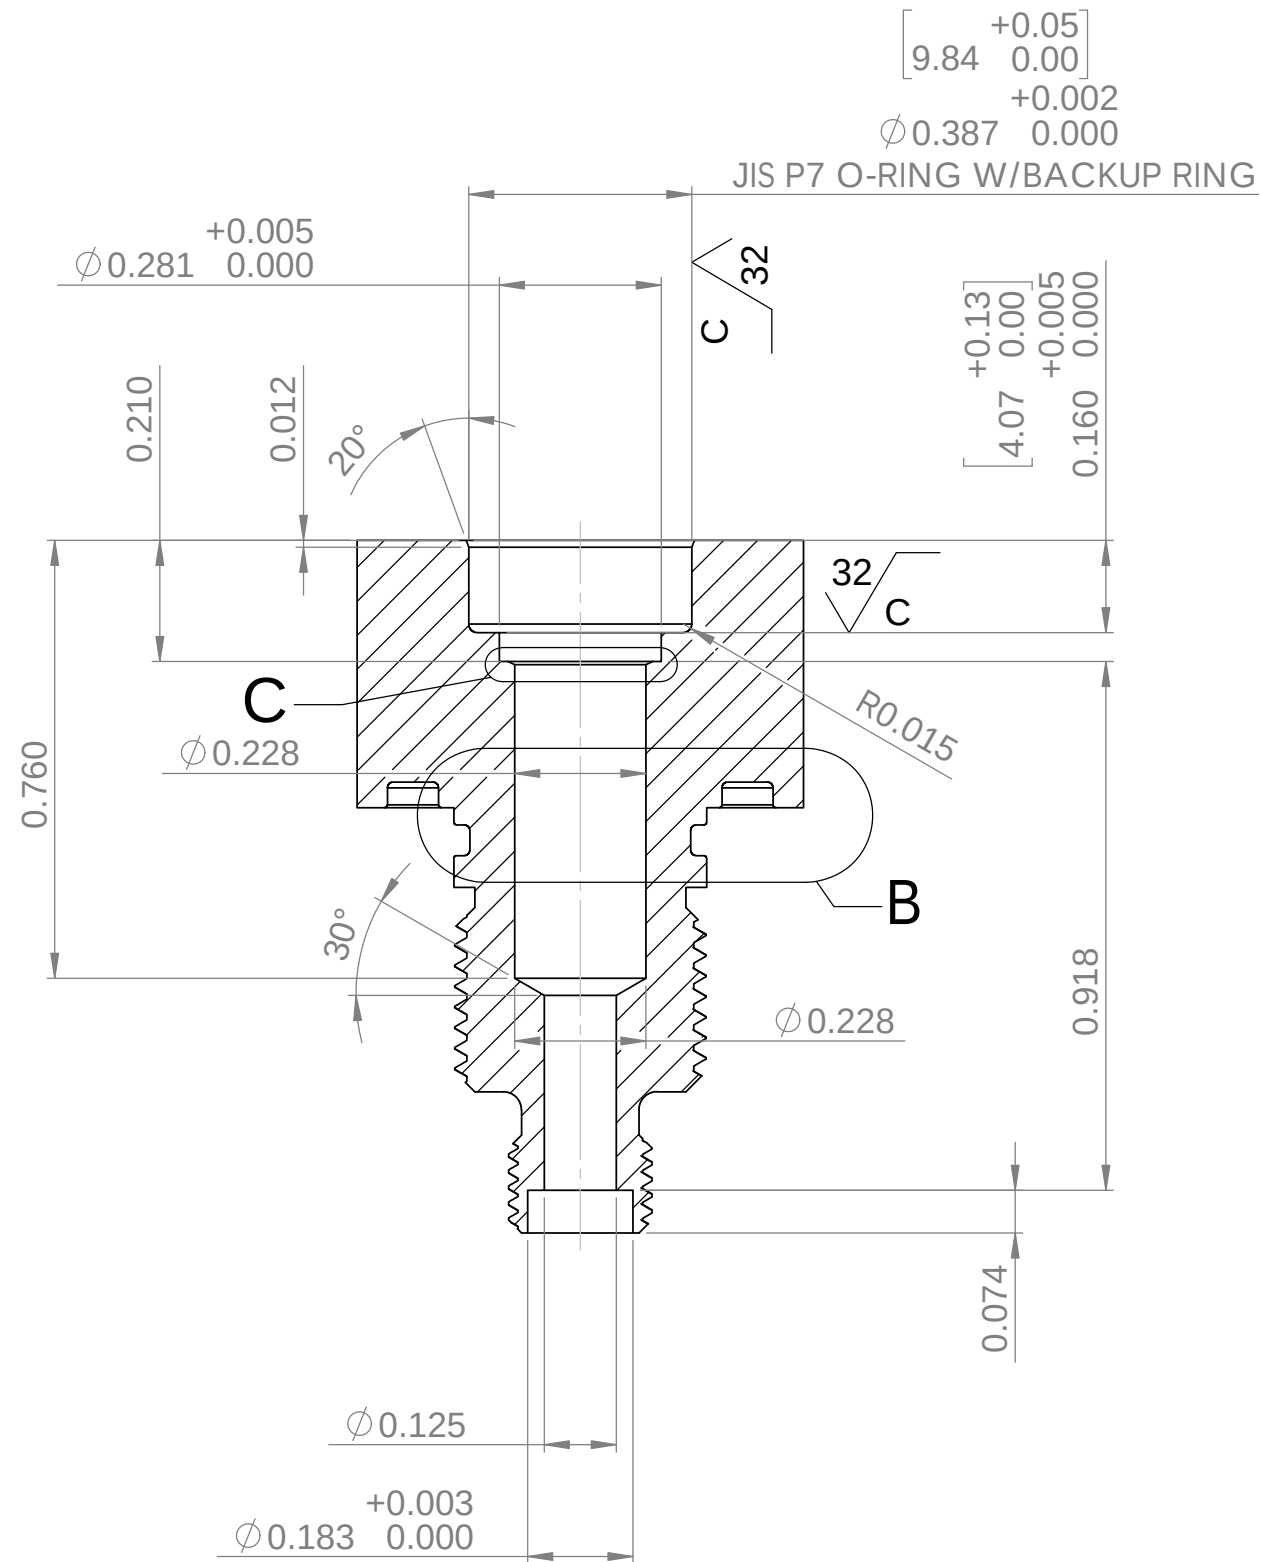

SECTION A-A
SCALE 3 : 1

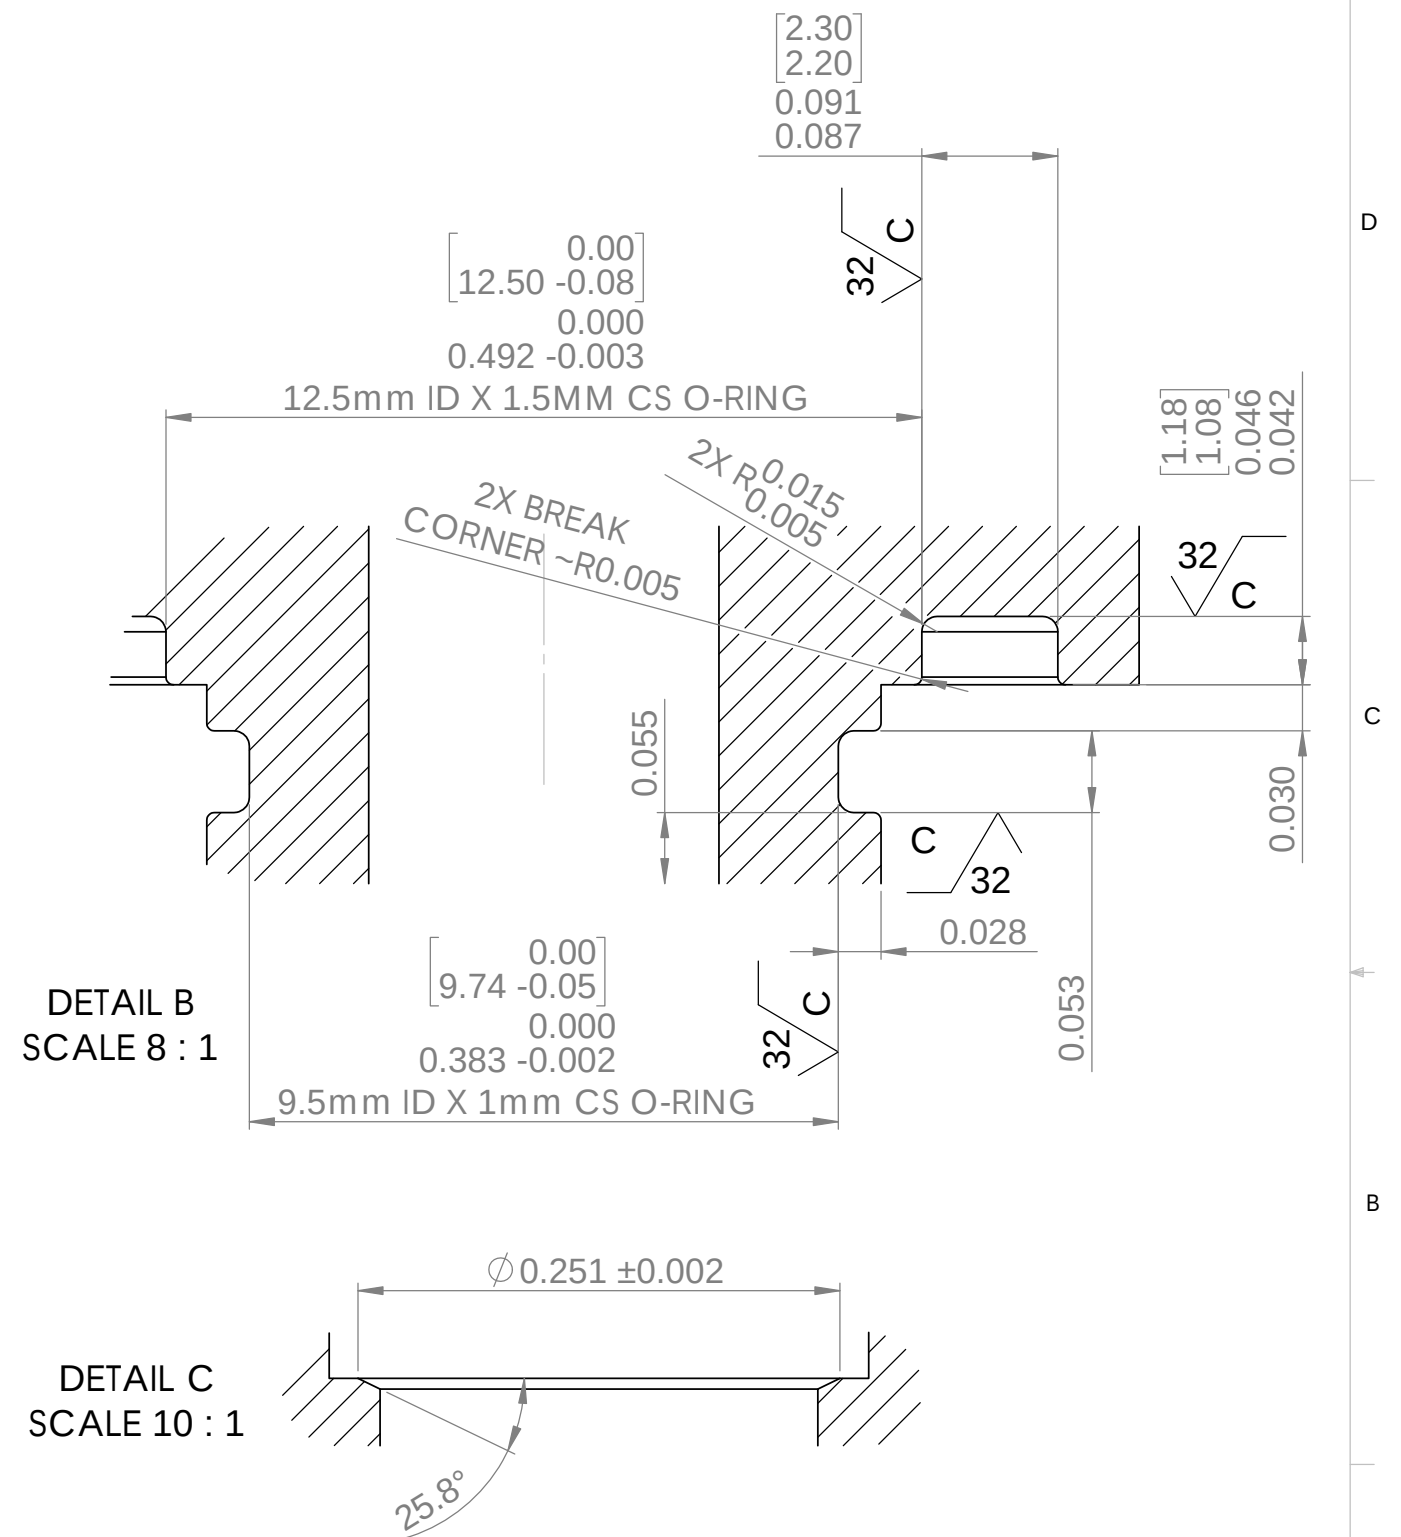

DETAIL C
SCALE 10 : 1

BILL OF MATERIALS								
NEXT ASSY Description	NEXT ASSY Number	UNLESS OTHERWISE SPECIFIED TOLERANCES ARE:			APPROVALS	DATE	Monterey Bay Aquarium Research Institute MBARI 7700 Sandholdt Rd. Moss Landing, CA 95039 831 775-1922	
		1 PLACE DIM ±.175	2 PLACE DIM ±.02	3 PLACE DIM ±.005	ANGLES ±1°	DRAWN Gene M.		
THIRD ANGLE PROJECTION		1. DIMENSIONS ARE IN INCHES 2. DIMENSION LIMITS HELD AFTER PLATING. 3. REMOVE BURRS AND SHARP EDGES .015 MAX. 4. MACHINED FILLET RADII .0150-.030. 5. MACHINED DIAMETERS ON A COMMON CENTERLINE CONCENTRIC WITHIN .005 6. PERPENDICULARITY & PARALLELISM OF MACHINED SURFACES .002 PER INCH. MAX. .012 INCHES FOR SINGLE SURFACE.				ENGINEER Gene M.		
						CHECKED		
						PROJECT NO.		
						DO NOT SCALE DRAWING		
						MATL		
						SIZE B	DWG. NO. 1-20082015-901206	REV. A
						SCALE 2:1	CAD FILE:	SHEET 2 OF 2