

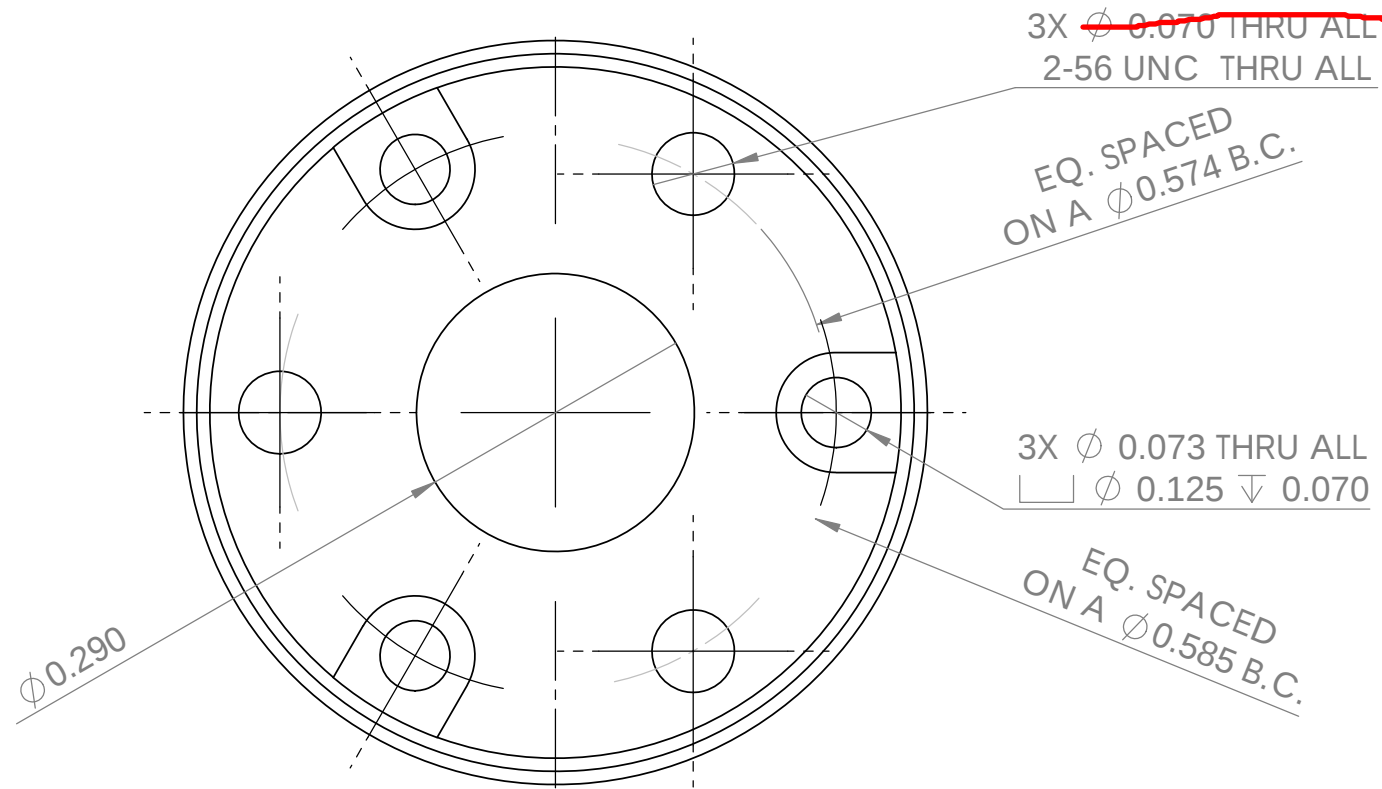


THE INFORMATION CONTAINED IN THIS DRAWING IS THE SOLE PROPERTY OF MBARI ANY REPRODUCTION IN PART OR WHOLE WITHOUT THE WRITTEN PERMISSION OF MBARI IS PROHIBITED.

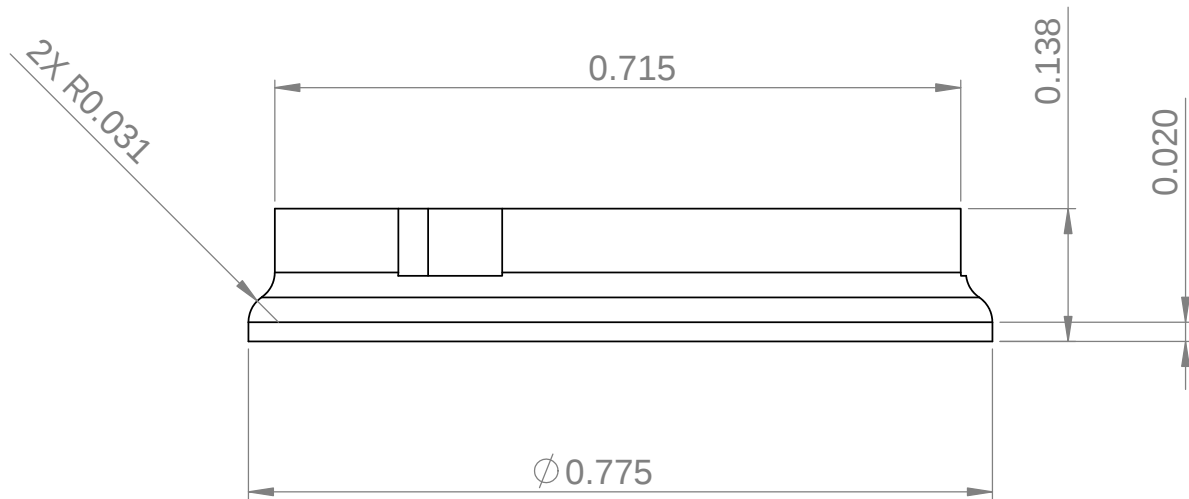

Drill 0.0938 THRU

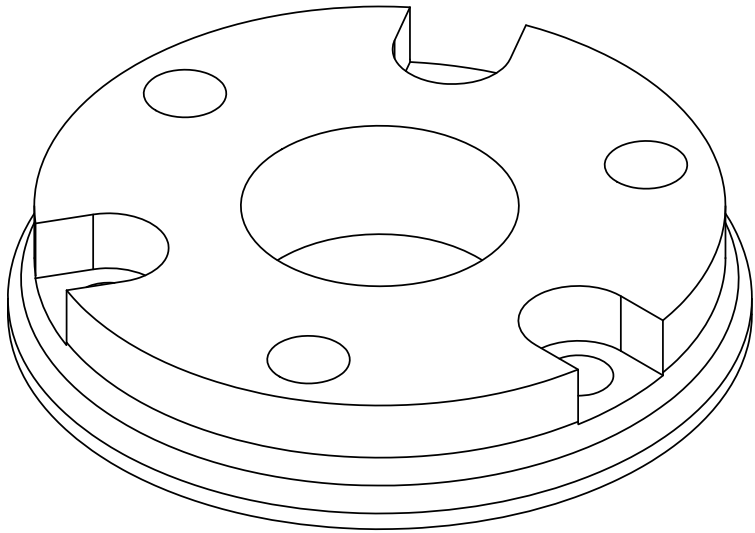

NOTE:
1) Mat'l: Ti, CP or 6Al-4V

BILL OF MATERIALS										
NEXT ASSY Description	NEXT ASSY Number	UNLESS OTHERWISE SPECIFIED TOLERANCES ARE:				APPROVALS		DATE		
		1 PLACE DIM ±1/16	2 PLACE DIM ±.02	3 PLACE DIM ±.005	ANGLES ±1°	DRAWN	Gene M.			
THIRD ANGLE PROJECTION		1. DIMENSIONS ARE IN INCHES				ENGINEER	Gene M.			
		2. DIMENSION LIMITS HELD AFTER PLATING.				CHECKED				
		3. REMOVE BURRS AND SHARP EDGES .015 MAX.				PROJECT NO.	901206			
		4. MACHINED FILLET RADII .0150-.030.				PROJECT	Coastal Profiling Float			
		5. MACHINED DIAMETERS ON A COMMON CENTERLINE CONCENTRIC WITHIN .005								
		6. PERPENDICULARITY & PARALLELISM OF MACHINED SURFACES .002 PER INCH. MAX .012 INCHES FOR SINGLE SURFACE.								
		DO NOT SCALE DRAWING				MAT'L		SIZE B	DWG. NO.	REV.
								SCALE 5:1	CAD FILE:	SHEET 1 OF 1



Monterey Bay Aquarium Research Institute
MBARI
7700 Sandholdt Rd.
Moss Landing, CA 95039
831 775-1922

LENS BODY SPACER