

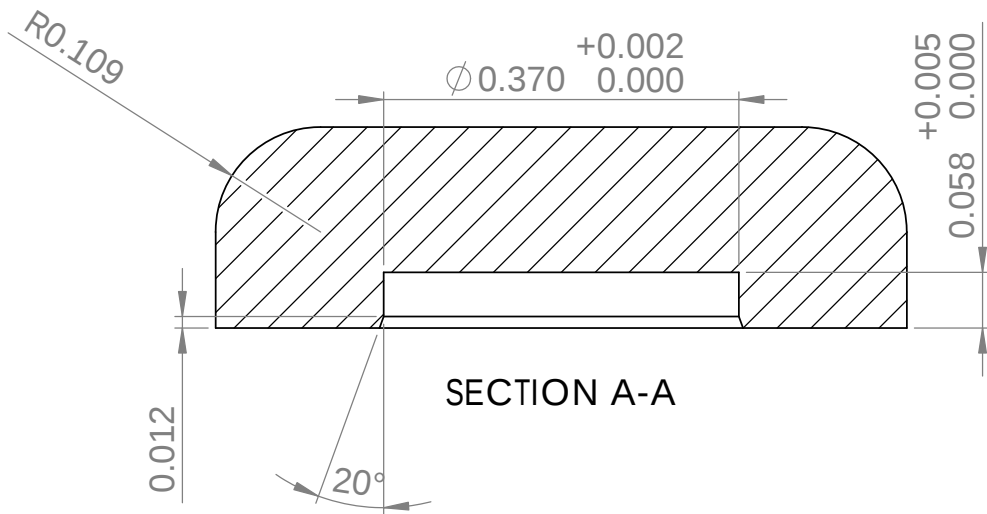
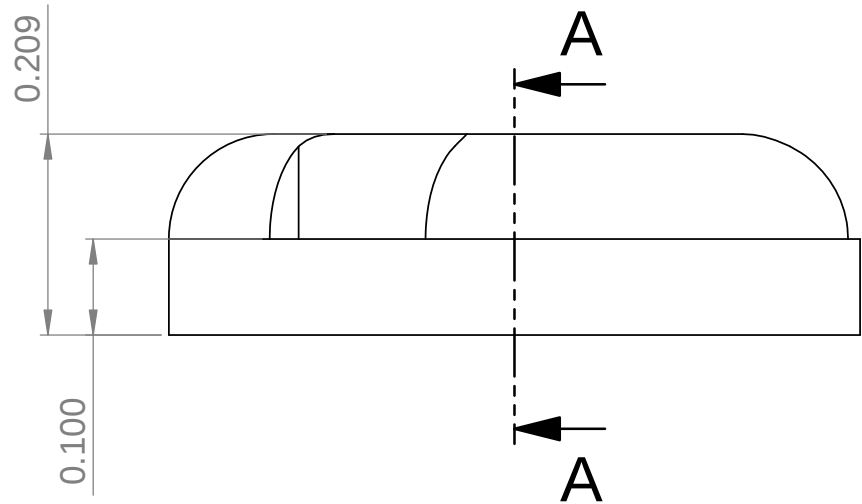


THE INFORMATION CONTAINED IN THIS DRAWING IS THE SOLE PROPERTY OF MBARI. ANY REPRODUCTION IN PART OR WHOLE WITHOUT THE WRITTEN PERMISSION OF MBARI IS PROHIBITED.

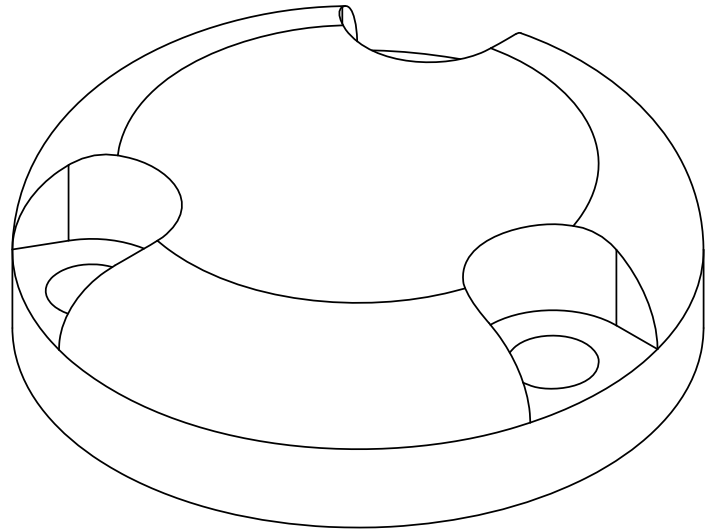

NOTES:
1) Mat'l: Ti, CP or 6Al-4V

BILL OF MATERIALS									
NEXT ASSY Description	NEXT ASSY Number	UNLESS OTHERWISE SPECIFIED TOLERANCES ARE:				APPROVALS		DATE	
		1 PLACE DIM ±1/16	2 PLACE DIM ±.02	3 PLACE DIM ±.005	ANGLES ±1°	DRAWN	Gene M.		
THIRD ANGLE PROJECTION		1. DIMENSIONS ARE IN INCHES				ENGINEER	Gene M.		
		2. DIMENSION LIMITS HELD AFTER PLATING.				CHECKED			
		3. REMOVE BURRS AND SHARP EDGES .015 MAX.				PROJECT NO.	901217		
		4. MACHINED FILLET RADII .0150-.030.				PROJECT	CHEM SENSORS		
		5. MACHINED DIAMETERS ON A COMMON CENTERLINE CONCENTRIC WITHIN .005							
		6. PERPENDICULARITY & PARALLELISM OF MACHINED SURFACES .002 PER INCH. MAX .012 INCHES FOR SINGLE SURFACE.							
		DO NOT SCALE DRAWING				MAT'L			
						SIZE B	DWG. NO.		REV. B
						SCALE 5:1	CAD FILE:		SHEET 1 OF 1

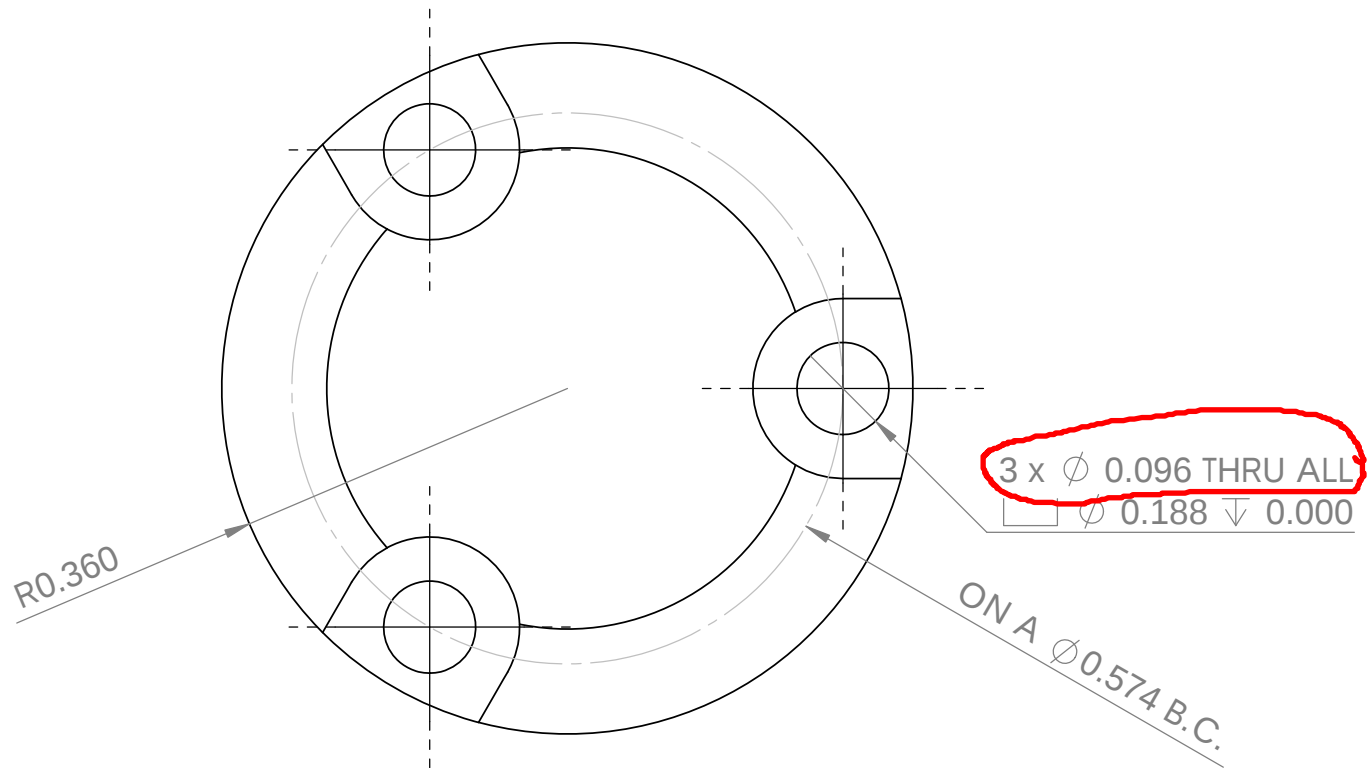

Monterey Bay Aquarium Research Institute

MBARI

7700 Sandholdt Rd.

Moss Landing, CA 95039

831 775-1922

MIRROR HOLDER 2

7700 Sandholdt Rd.
Moss Landing, CA 95039
831 775-1922

MIRROR HOLDER 2