
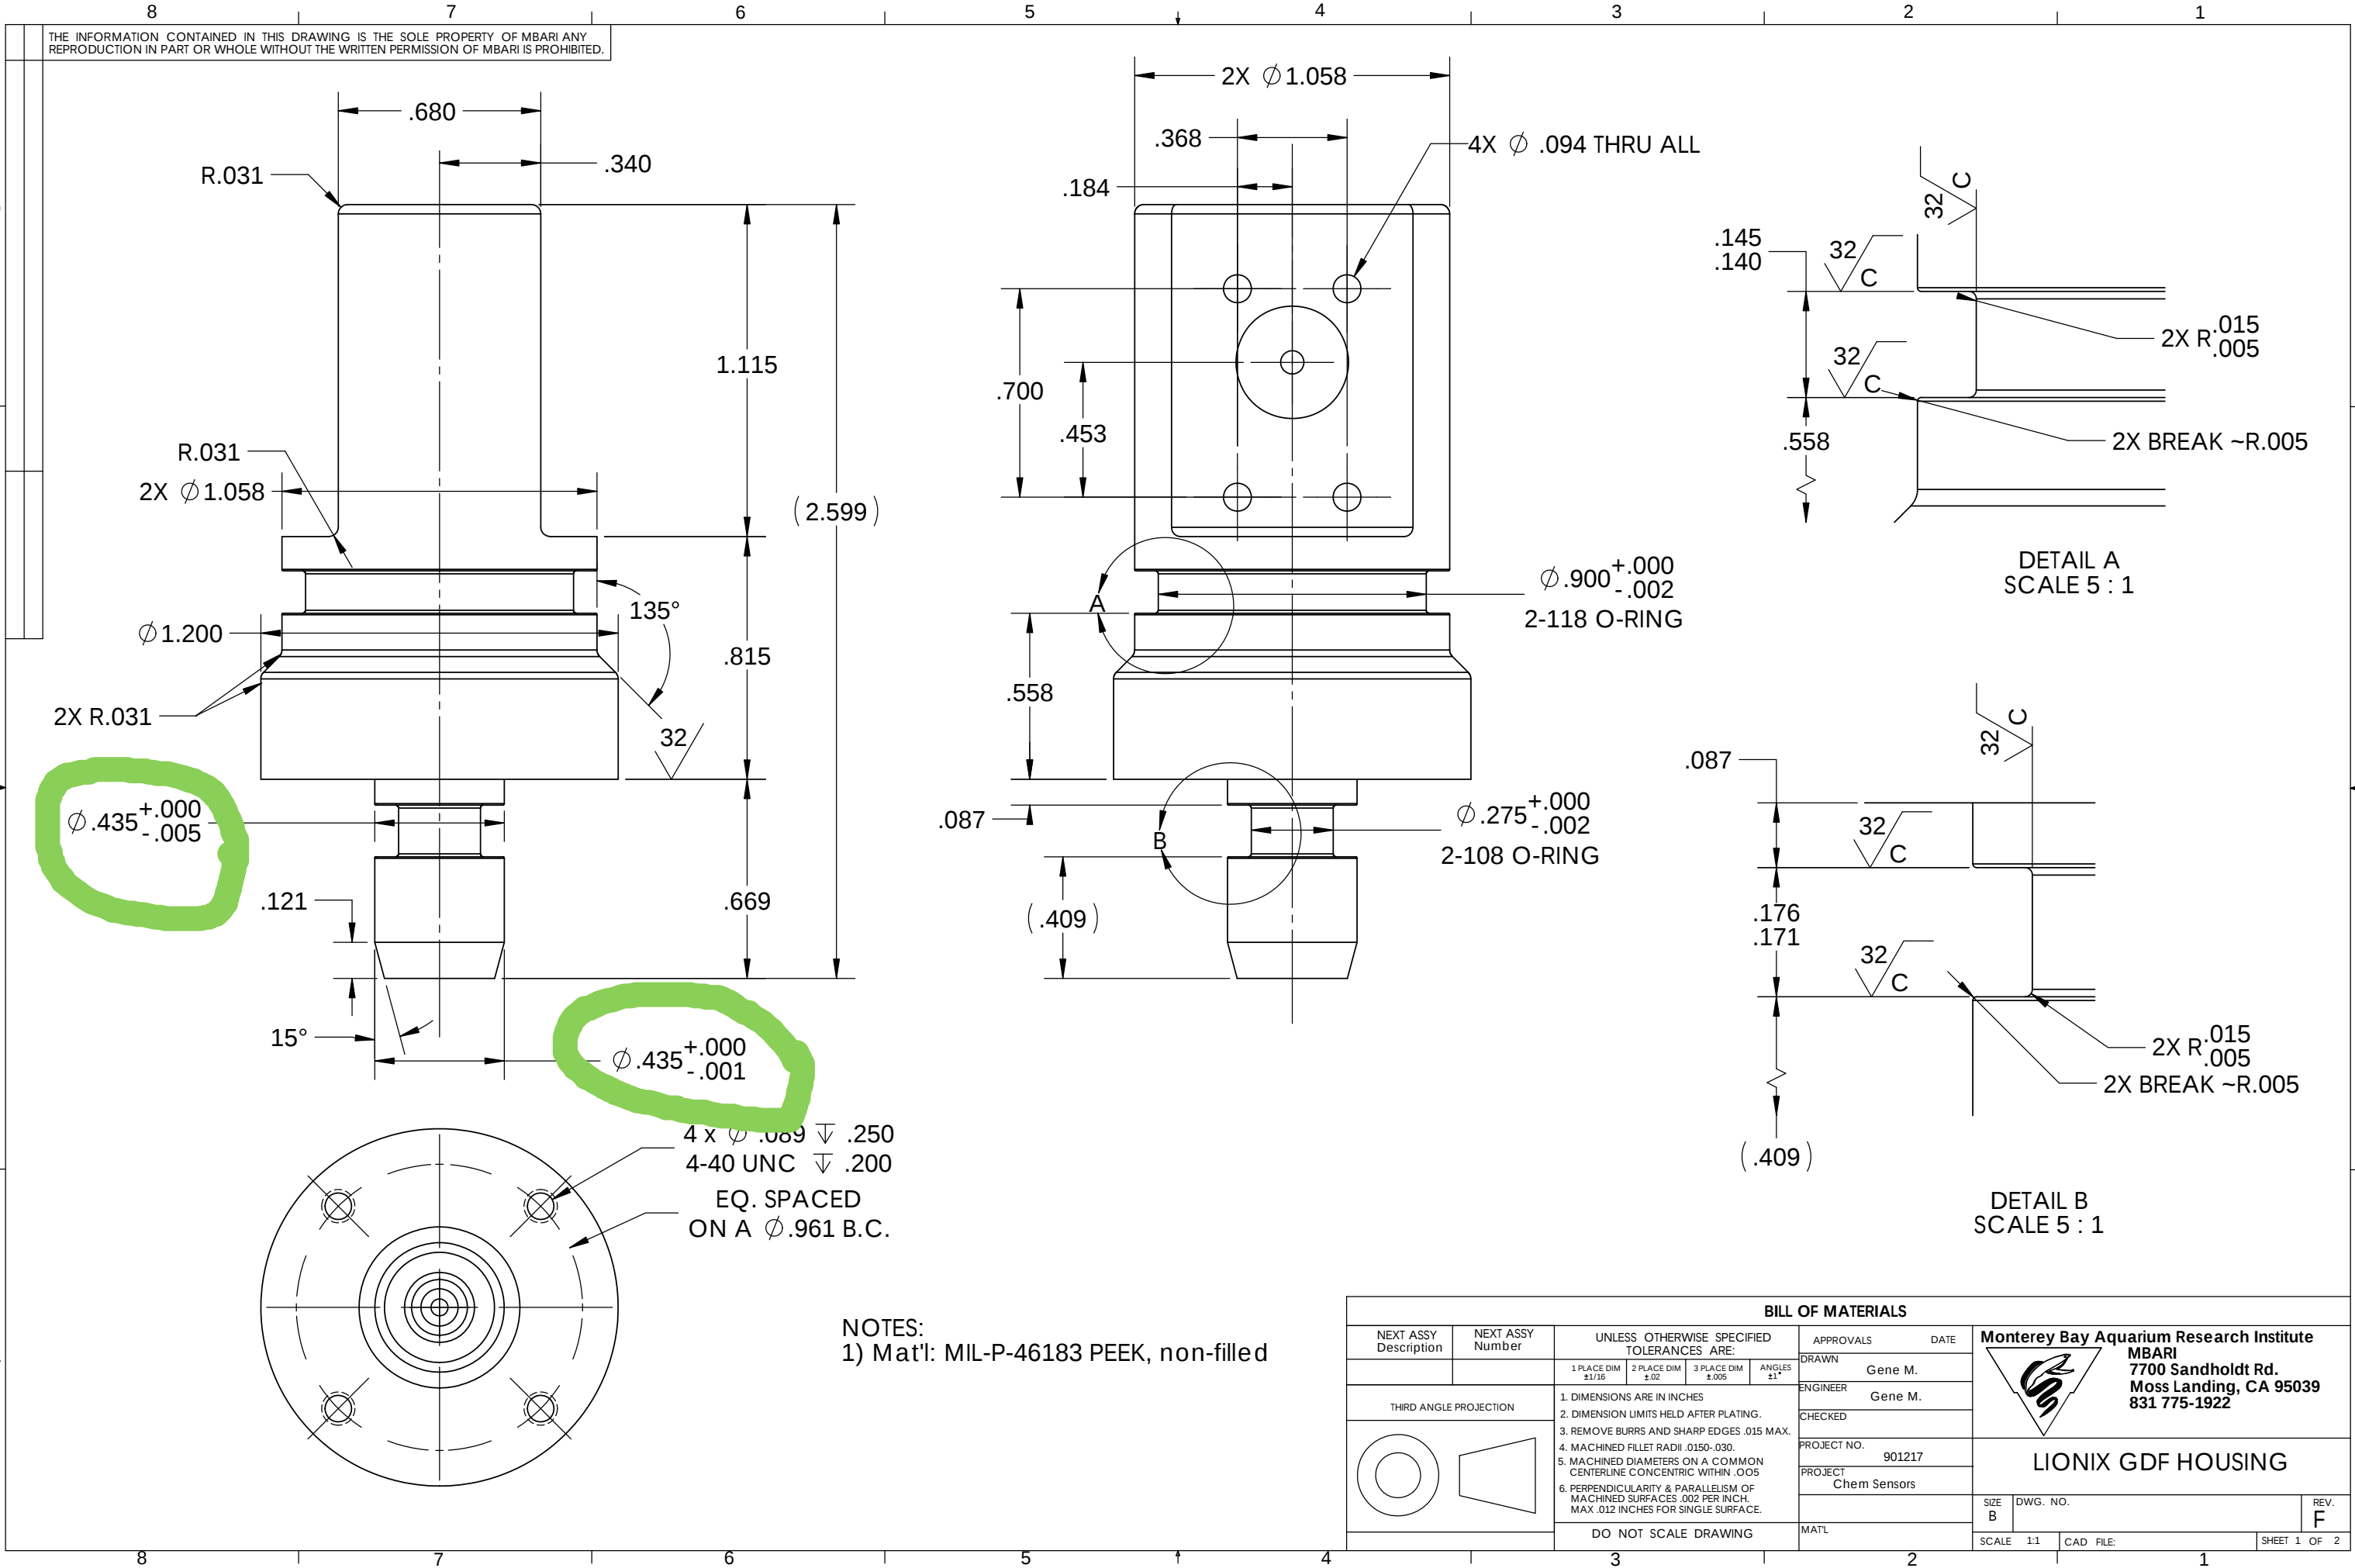


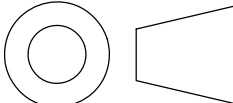

THE INFORMATION CONTAINED IN THIS DRAWING IS THE SOLE PROPERTY OF MBARI ANY REPRODUCTION IN PART OR WHOLE WITHOUT THE WRITTEN PERMISSION OF MBARI IS PROHIBITED.

NOTES:
1) Mat'l: MIL-P-46183 PEEK, non-filled

BILL OF MATERIALS														
NEXT ASSY Description		NEXT ASSY Number	UNLESS OTHERWISE SPECIFIED TOLERANCES ARE:				APPROVALS		DATE		 Monterey Bay Aquarium Research Institute MBARI 7700 Sandholdt Rd. Moss Landing, CA 95039 831 775-1922			
			1 PLACE DIM ±1/16	2 PLACE DIM ±.02	3 PLACE DIM ±.005	ANGLES ±1°	DRAWN	Gene M.						
							ENGINEER	Gene M.						
							CHECKED							
							PROJECT NO.	901217						
THIRD ANGLE PROJECTION			1. DIMENSIONS ARE IN INCHES 2. DIMENSION LIMITS HELD AFTER PLATING. 3. REMOVE BURRS AND SHARP EDGES .015 MAX. 4. MACHINED FILLET RADII .0150-.030. 5. MACHINED DIAMETERS ON A COMMON CENTERLINE CONCENTRIC WITHIN .005 6. PERPENDICULARITY & PARALLELISM OF MACHINED SURFACES .002 PER INCH. MAX .012 INCHES FOR SINGLE SURFACE.				PROJECT	Chem Sensors						
														
			DO NOT SCALE DRAWING				MAT'L			SIZE B	DWG. NO.		REV. F	
										SCALE 1:1	CAD FILE:		SHEET 1 OF 2	



THE INFORMATION CONTAINED IN THIS DRAWING IS THE SOLE PROPERTY OF MBARI ANY REPRODUCTION IN PART OR WHOLE WITHOUT THE WRITTEN PERMISSION OF MBARI IS PROHIBITED.

D



C

B


A

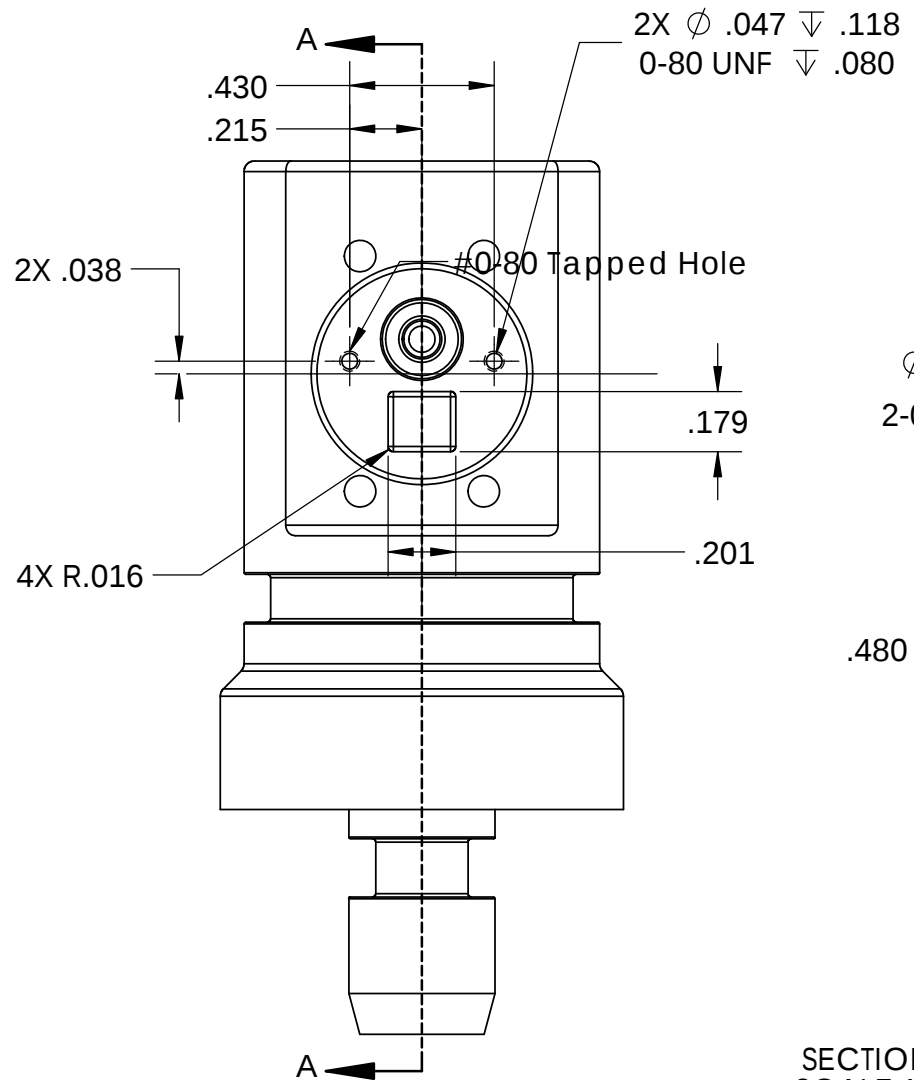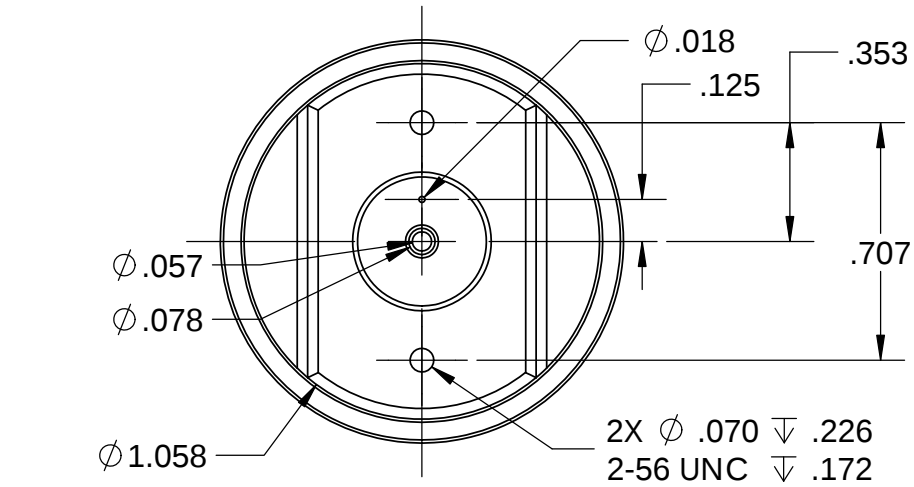

SECTION A-A
SCALE 1.75 : 1

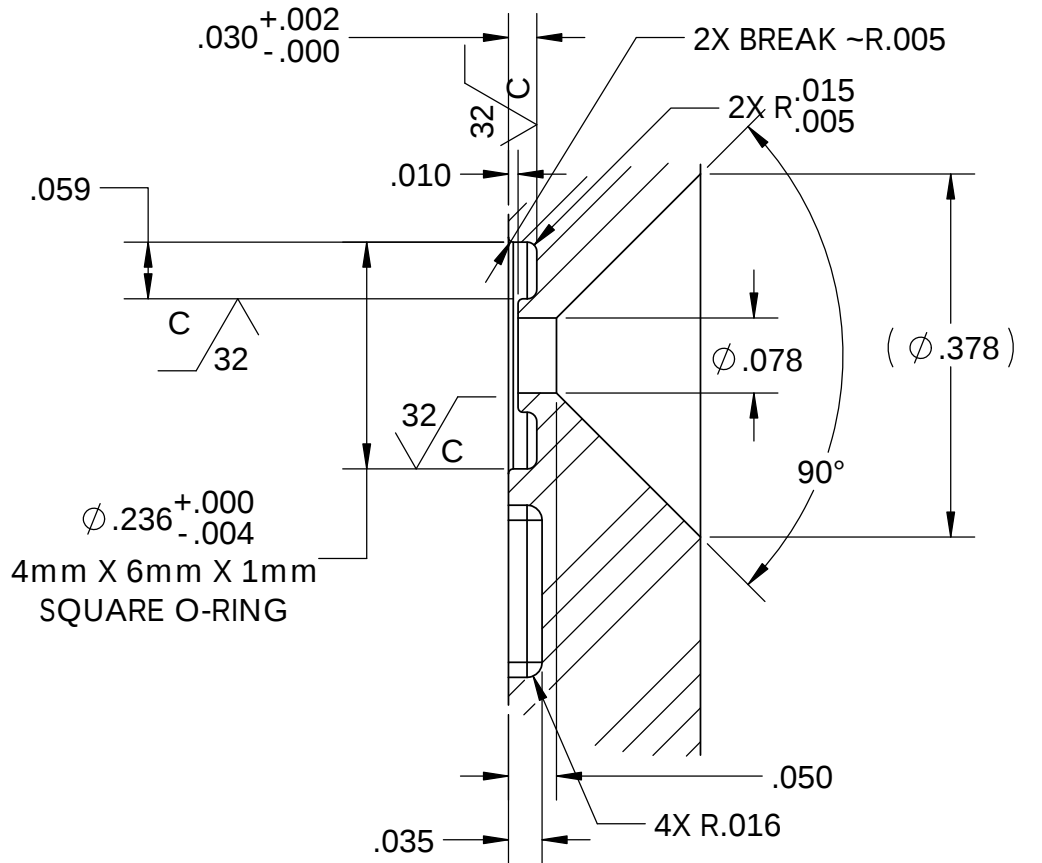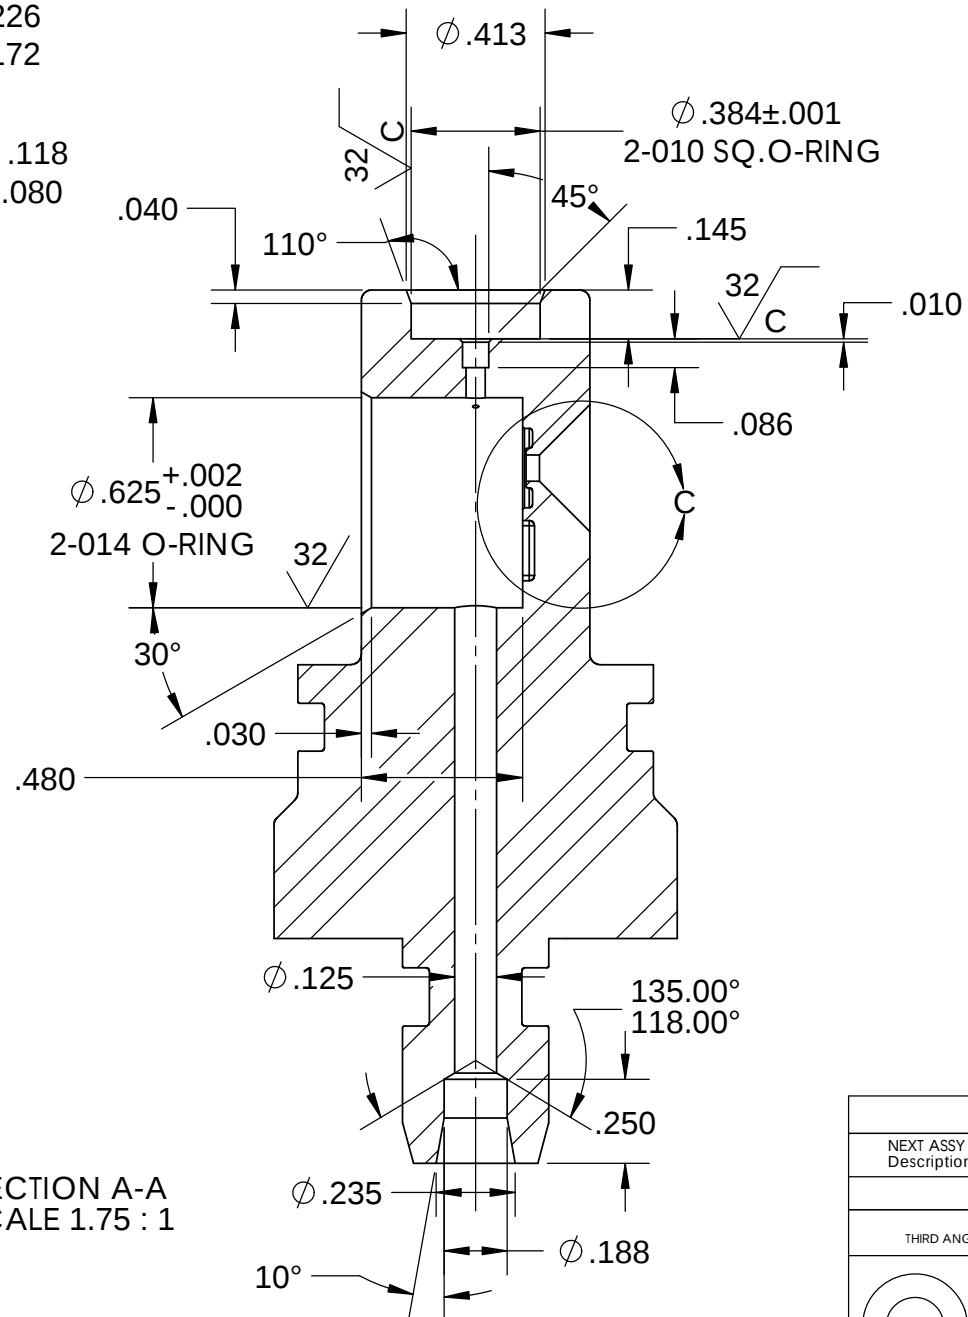

DETAIL C
SCALE 5 : 1

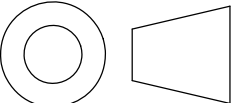BILL OF MATERIALS										
NEXT ASSY Description	NEXT ASSY Number	UNLESS OTHERWISE SPECIFIED TOLERANCES ARE:			APPROVALS		DATE			Monterey Bay Aquarium Research Institute MBARI 7700 Sandholdt Rd. Moss Landing, CA 95039 831 775-1922
		1 PLACE DIM ±1/16	2 PLACE DIM ±.02	3 PLACE DIM ±.005	ANGLES ±1°	DRAWN	Gene M.			
THIRD ANGLE PROJECTION		1. DIMENSIONS ARE IN INCHES 2. DIMENSION LIMITS HELD AFTER PLATING. 3. REMOVE BURRS AND SHARP EDGES .015 MAX. 4. MACHINED FILLET RADII .0150-.030. 5. MACHINED DIAMETERS ON A COMMON CENTERLINE CONCENTRIC WITHIN .005 6. PERPENDICULARITY & PARALLELISM OF MACHINED SURFACES .002 PER INCH. MAX .012 INCHES FOR SINGLE SURFACE.				ENGINEER	Gene M.			
						CHECKED				
						PROJECT NO.	901217			
						PROJECT	Chem Sensors			
							SIZE B	DWG. NO.		REV. F
		DO NOT SCALE DRAWING				MAT'L	SCALE 1:1		CAD FILE:	SHEET 2 OF 2